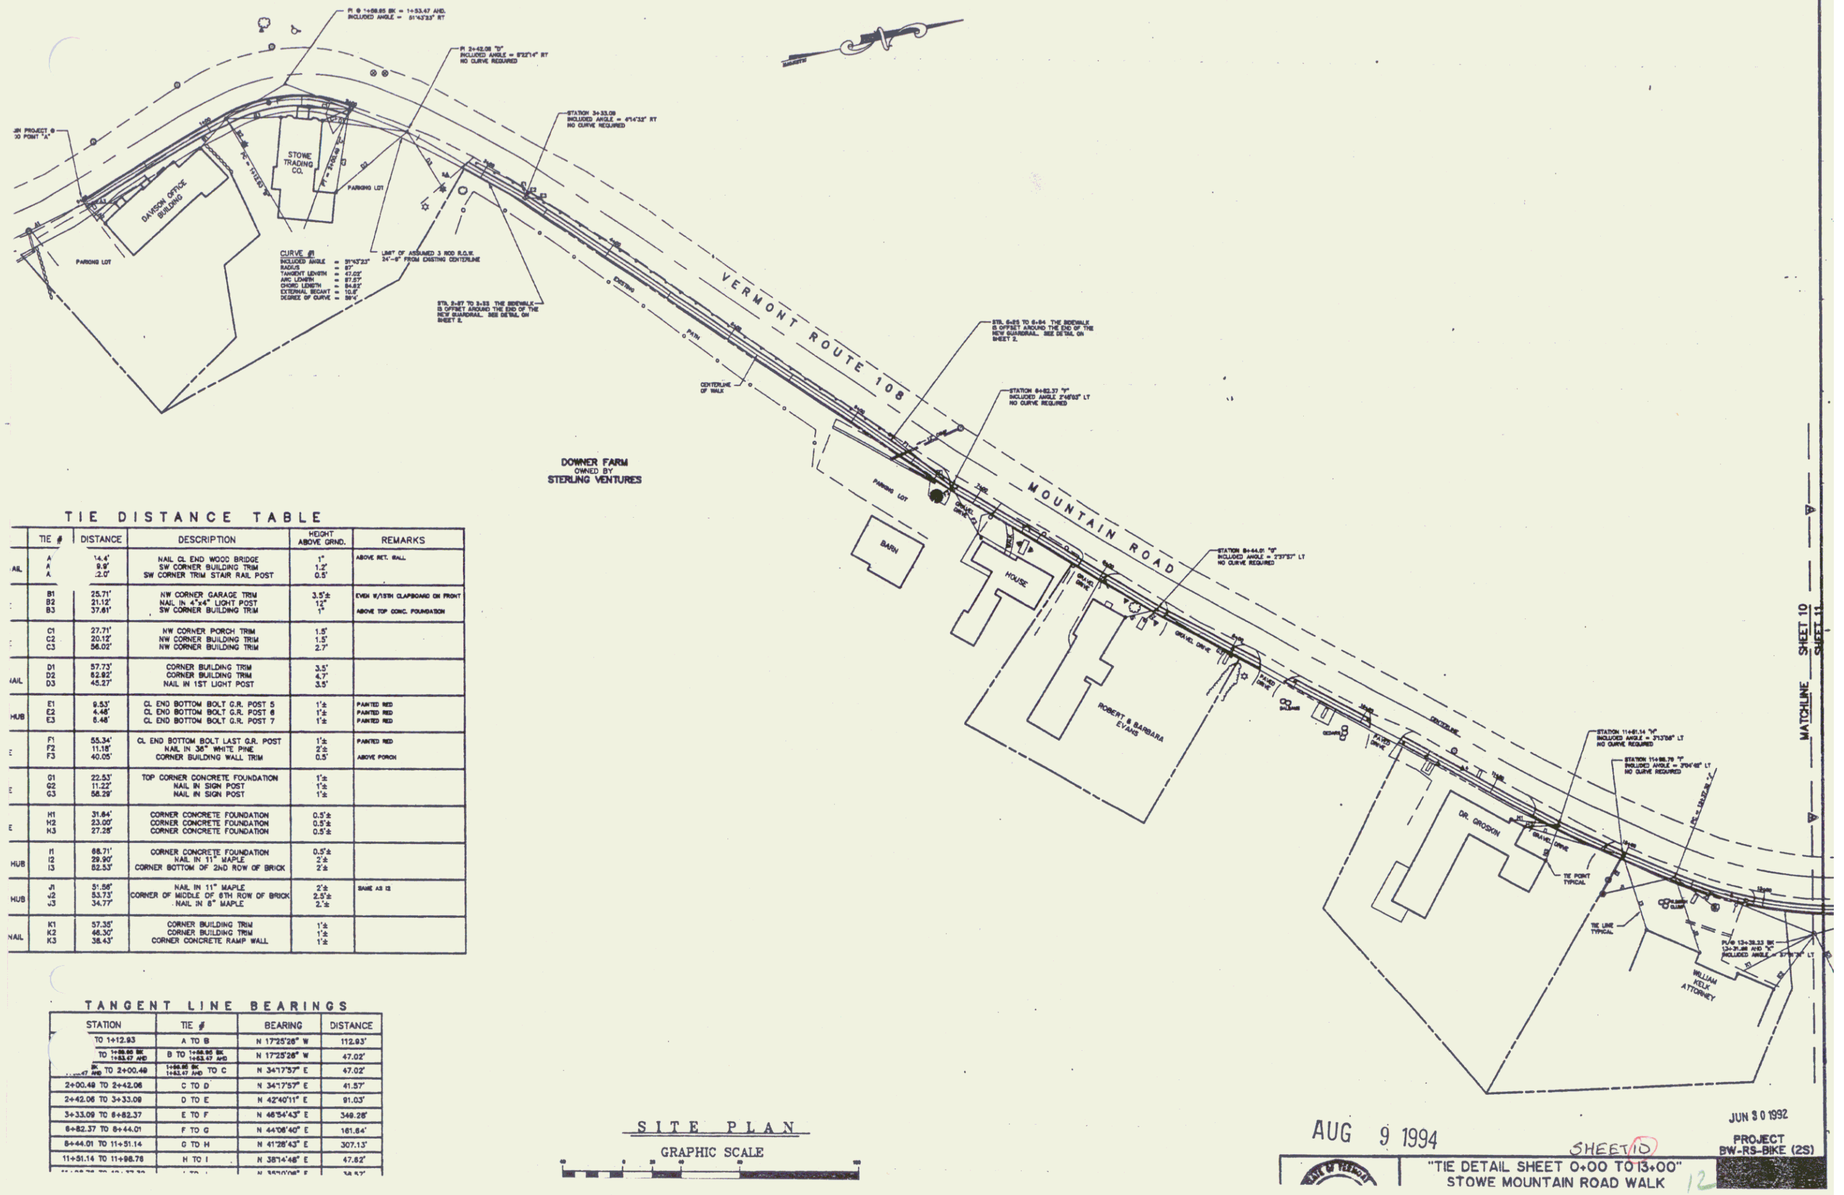

TIE DISTANCE TABLE

	TIE #	DISTANCE	DESCRIPTION	HEIGHT ABOVE GRND.	REMARKS
AIL	A	14.4'	NAIL CL END WOOD BRIDGE	1"	ABOVE RET. WALL
	A	9.9'	SW CORNER BUILDING TRIM	1.2'	
	A	2.0'	SW CORNER TRIM STAIR RAIL POST	0.5'	
	B1	25.71'	NW CORNER GARAGE TRIM	3.5'±	EVEN W/13TH CLAPBOARD ON FRONT
	B2	21.13'	NAIL IN 4"x4" LIGHT POST	1.2'	
	B3	37.61'	SW CORNER BUILDING TRIM	1'	ABOVE TOP CONC. FOUNDATION
	C1	27.71'	NW CORNER PORCH TRIM	1.5'	
	C2	20.12'	NW CORNER BUILDING TRIM	1.5'	
	C3	56.02'	NW CORNER BUILDING TRIM	2.7'	
AIL	D1	57.73'	CORNER BUILDING TRIM	3.5'	
	D2	52.82'	CORNER BUILDING TRIM	4.7'	
	D3	45.27'	NAIL IN 1ST LIGHT POST	3.5'	
HUB	E1	8.53'	CL END BOTTOM BOLT G.R. POST 5	1'±	PAINTED RED
	E2	4.48'	CL END BOTTOM BOLT G.R. POST 6	1'±	PAINTED RED
	E3	8.48'	CL END BOTTOM BOLT G.R. POST 7	1'±	PAINTED RED
	F1	55.34'	CL END BOTTOM BOLT LAST G.R. POST	1'±	PAINTED RED
	F2	11.18'	NAIL IN 36" WHITE PINE	2'±	
	F3	40.05'	CORNER BUILDING WALL TRIM	0.5'	ABOVE PORCH
	G1	22.53'	TOP CORNER CONCRETE FOUNDATION	1'±	
	G2	11.22'	NAIL IN SIGN POST	1'±	
	G3	56.29'	NAIL IN SIGN POST	1'±	
	H1	31.84'	CORNER CONCRETE FOUNDATION	0.5'±	
	H2	23.00'	CORNER CONCRETE FOUNDATION	0.5'±	
	H3	27.28'	CORNER CONCRETE FOUNDATION	0.5'±	
HUB	I1	68.71'	CORNER CONCRETE FOUNDATION	0.5'±	
	I2	29.90'	NAIL IN 11" MAPLE	2'±	
	I3	52.53'	CORNER BOTTOM OF 2ND ROW OF BRICK	2'±	
HUB	J1	51.56'	NAIL IN 11" MAPLE	2'±	SAME AS I2
	J2	53.73'	CORNER OF MIDDLE OF 6TH ROW OF BRICK	2.5'±	
	J3	34.77'	NAIL IN 8" MAPLE	2'±	
AIL	K1	57.35'	CORNER BUILDING TRIM	1'±	
	K2	46.30'	CORNER BUILDING TRIM	1'±	
	K3	38.43'	CORNER CONCRETE RAMP WALL	1'±	

TANGENT LINE BEARINGS

STATION	TIE #	BEARING	DISTANCE
TO 1+12.93	A TO B	N 17°25'28" W	112.93'
TO 1+08.85 BK 1+53.47 AHD	B TO 1+08.85 BK 1+53.47 AHD	N 17°25'28" W	47.02'
1+08.85 BK 1+53.47 AHD TO 2+00.49	1+08.85 BK 1+53.47 AHD TO C	N 34°17'57" E	47.02'
2+00.49 TO 2+42.06	C TO D	N 34°17'57" E	41.57'
2+42.06 TO 3+33.09	D TO E	N 42°40'11" E	91.03'
3+33.09 TO 6+82.37	E TO F	N 46°54'43" E	349.28'
6+82.37 TO 8+44.01	F TO G	N 44°08'40" E	161.64'
8+44.01 TO 11+51.14	G TO H	N 41°28'43" E	307.13'
11+51.14 TO 11+98.78	H TO I	N 38°14'48" E	47.62'

SITE PLAN

GRAPHIC SCALE

AUG 9 1994

JUN 30 1992

SHEET 10

PROJECT
BW-RS-BIKE (2S)

"TIE DETAIL SHEET 0+00 TO 13+00"
STOWE MOUNTAIN ROAD WALK