TIE DISTANCE TABLE

STATION	DESC.	TIE #	DISTANCE	DESCRIPTION	HEIGHT ABOVE GRND.	REMARKS
13+39.23 13+31.89	K CONC. NAIL	K1 K2 K3	57.35' 46.30' 38.43'	CORNER BUILDING TRIM CORNER BUILDING TRIM CORNER CONCRETE RAMP WALL	1'± 1'± 1'±	
14+33.80	L CONC. NAIL	L1 L2 L3	62.33' 83.45' 47.15'	NAIL CTR. BOTTOM HORIZ. SIGN BOARD 8in NAIL IN UTILITY POLE CONC. NAIL 1" IN FROM CORNER PARKING LOT	2'± 2'±	ABOVE BERM IN PAVEMENT
14+87.65	M NAIL IN HUB	M1 M2 M3	42.17' 46.85' 32.18'	CONC. NAIL 1' IN FROM CORNER PARKING LOT CONC. NAIL 1" IN EDGE OF PARKING LOT NAIL IN TOP CTR. OF PLANTER TIMBER	 2'	SAME AS L3 IN LINE WITH SIGN ROADSIDE END
16+32.10	N NAIL IN HUB	N1 N2 N3	46.26' 39.82' 41.46'	OUT. CLOSE CORNER OF PORCH POST CORNER BUILDING TRIM NAIL TOP CORNER TIMBER RET. WALL	3.7'± 3.7'± 1'	ABOVE WALK ABOVE WALK TOP OF RET. WALL
19+05.54	O CONC. NAIL	O1 O2 O3	66.54' 9.59' 35.51'	CORNER CONCRETE FOUNDATION NAIL IN CORNER SIGN POST NAIL IN "ST FENCE POST	1' 1'	BELOW TRIM ABOVE METAL
20+70.47	P NAIL IN HUB	P1 P2 P3	51.88' 31.22' 59.27'	CONC. NAIL END OF 6TH WHITE LINE CONC. NAIL END OF 1ST WHITE LINE NAIL IN SIGN POST	 1'±	IN PAVEMENT IN PAVEMENT
22+72.72	Q SPIKE	Q1 Q2 Q3	30.00' 60.05' 46.77'	NAIL IN 15" RED PINE CORNER CONCRETE FOUNDATION WALL NAIL IN 15" RED PINE	0.7'± 0.3'± 1.3'±	ABOVE WALK
23+28.47	R NAIL IN HUB	R1 R2 R3	14.50' 15.81' 43.10'	NAIL IN 15" RED PINE NAIL IN 15" RED PINE NAIL IN GUY POLE	1.3'± 1.3'± 1.1'±	SAME AS Q3
23+35.32	S NAIL IN HUB	S1 S2 S3	19.79' 12.43' 36.27'	NAIL IN 15" RED PINE NAIL IN 15" RED PINE NAIL IN GUY POLE	1.3'± 1.3'± 1.2'±	SAME AS Q3, R1 SAME AS R2 SAME AS R3
24+61.84 24+57.52	T NAIL IN HUB	T1 T2 T3	40.05' 10.74' 23.45'	NAIL IN 18" RED PINE CONC. NAIL IN PATCH OF CONCRETE CONC. NAIL IN WHITE LINE	0.9'	IN LAWN OPPOSITE PEDESTAL
25+84.04	U CONC. NAIL	U1 U2 U3	62.43' 21.96' 19.16'	CORNER BUILDING TRIM NAIL IN SIGN POST NAIL IN SIGN POST	2' 2'± 2'±	ABOVE STONE PATIO ROADSIDE

TANGENT LINE BEARINGS

STATION	TIE #	BEARING	DISTANCE
13+39.23 BK TO 14+33.80 13+31.89 AHD	K TO L	N 02°21'25" W	101.91'
14+33.80 TO 14+87.65	L TO M	N 02°21'25" W	53.85'
14+87.65 TO 16+32.10	M TO N	N 01°25'28" W	144.45'
16+32.10 TO 19+05.54	N TO O	N 03°04'17" W	273.44'
19+05.54 TO 20+70.47	O TO P	N 06°25'22" W	164.93'
20+70.47 TO 22+72.72	P TO Q	N 11°59'16" W	202.25'
22+72.72 TO 23+28.47	Q TO R	N 15°14'23" W	55.75'
23+28.47 TO 23+35.32	R TO S	N 14°08'49" W	6.85'
23+35.32 TO 24+61.84 BK 25+82.81 AHD	S TO T	N 14°08'49" W	126.52'
24+61.84 BK 24+57.52 AHD TO 25+84.04	T TO U	N 40°03'26" W	126.52'

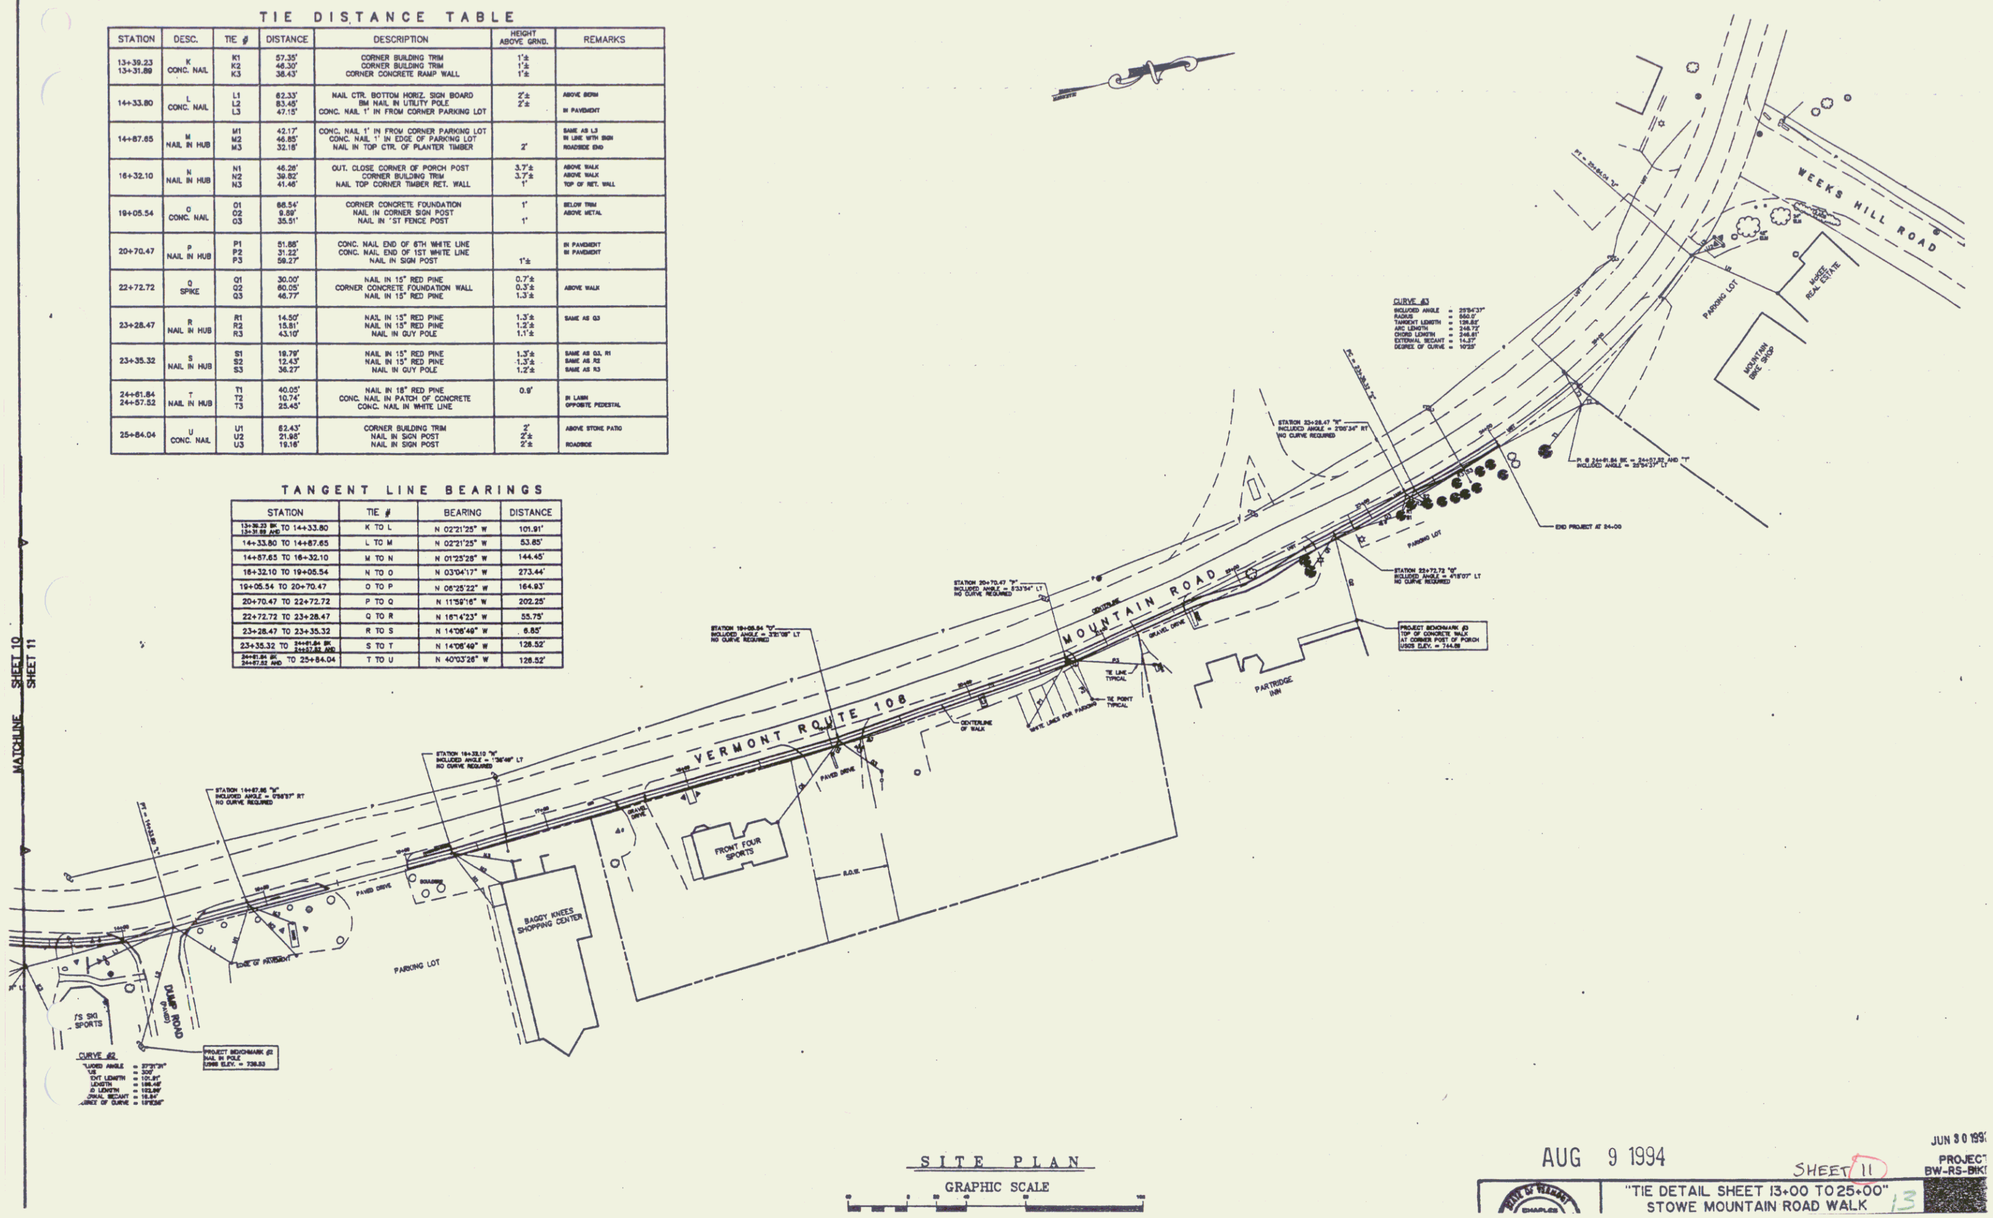

SITE PLAN

GRAPHIC SCALE

AUG 9 1994

JUN 30 199

SHEET 11

PROJECT BW-RS-BIKT

"TIE DETAIL SHEET 13+00 TO 25+00"
STOWE MOUNTAIN ROAD WALK

13