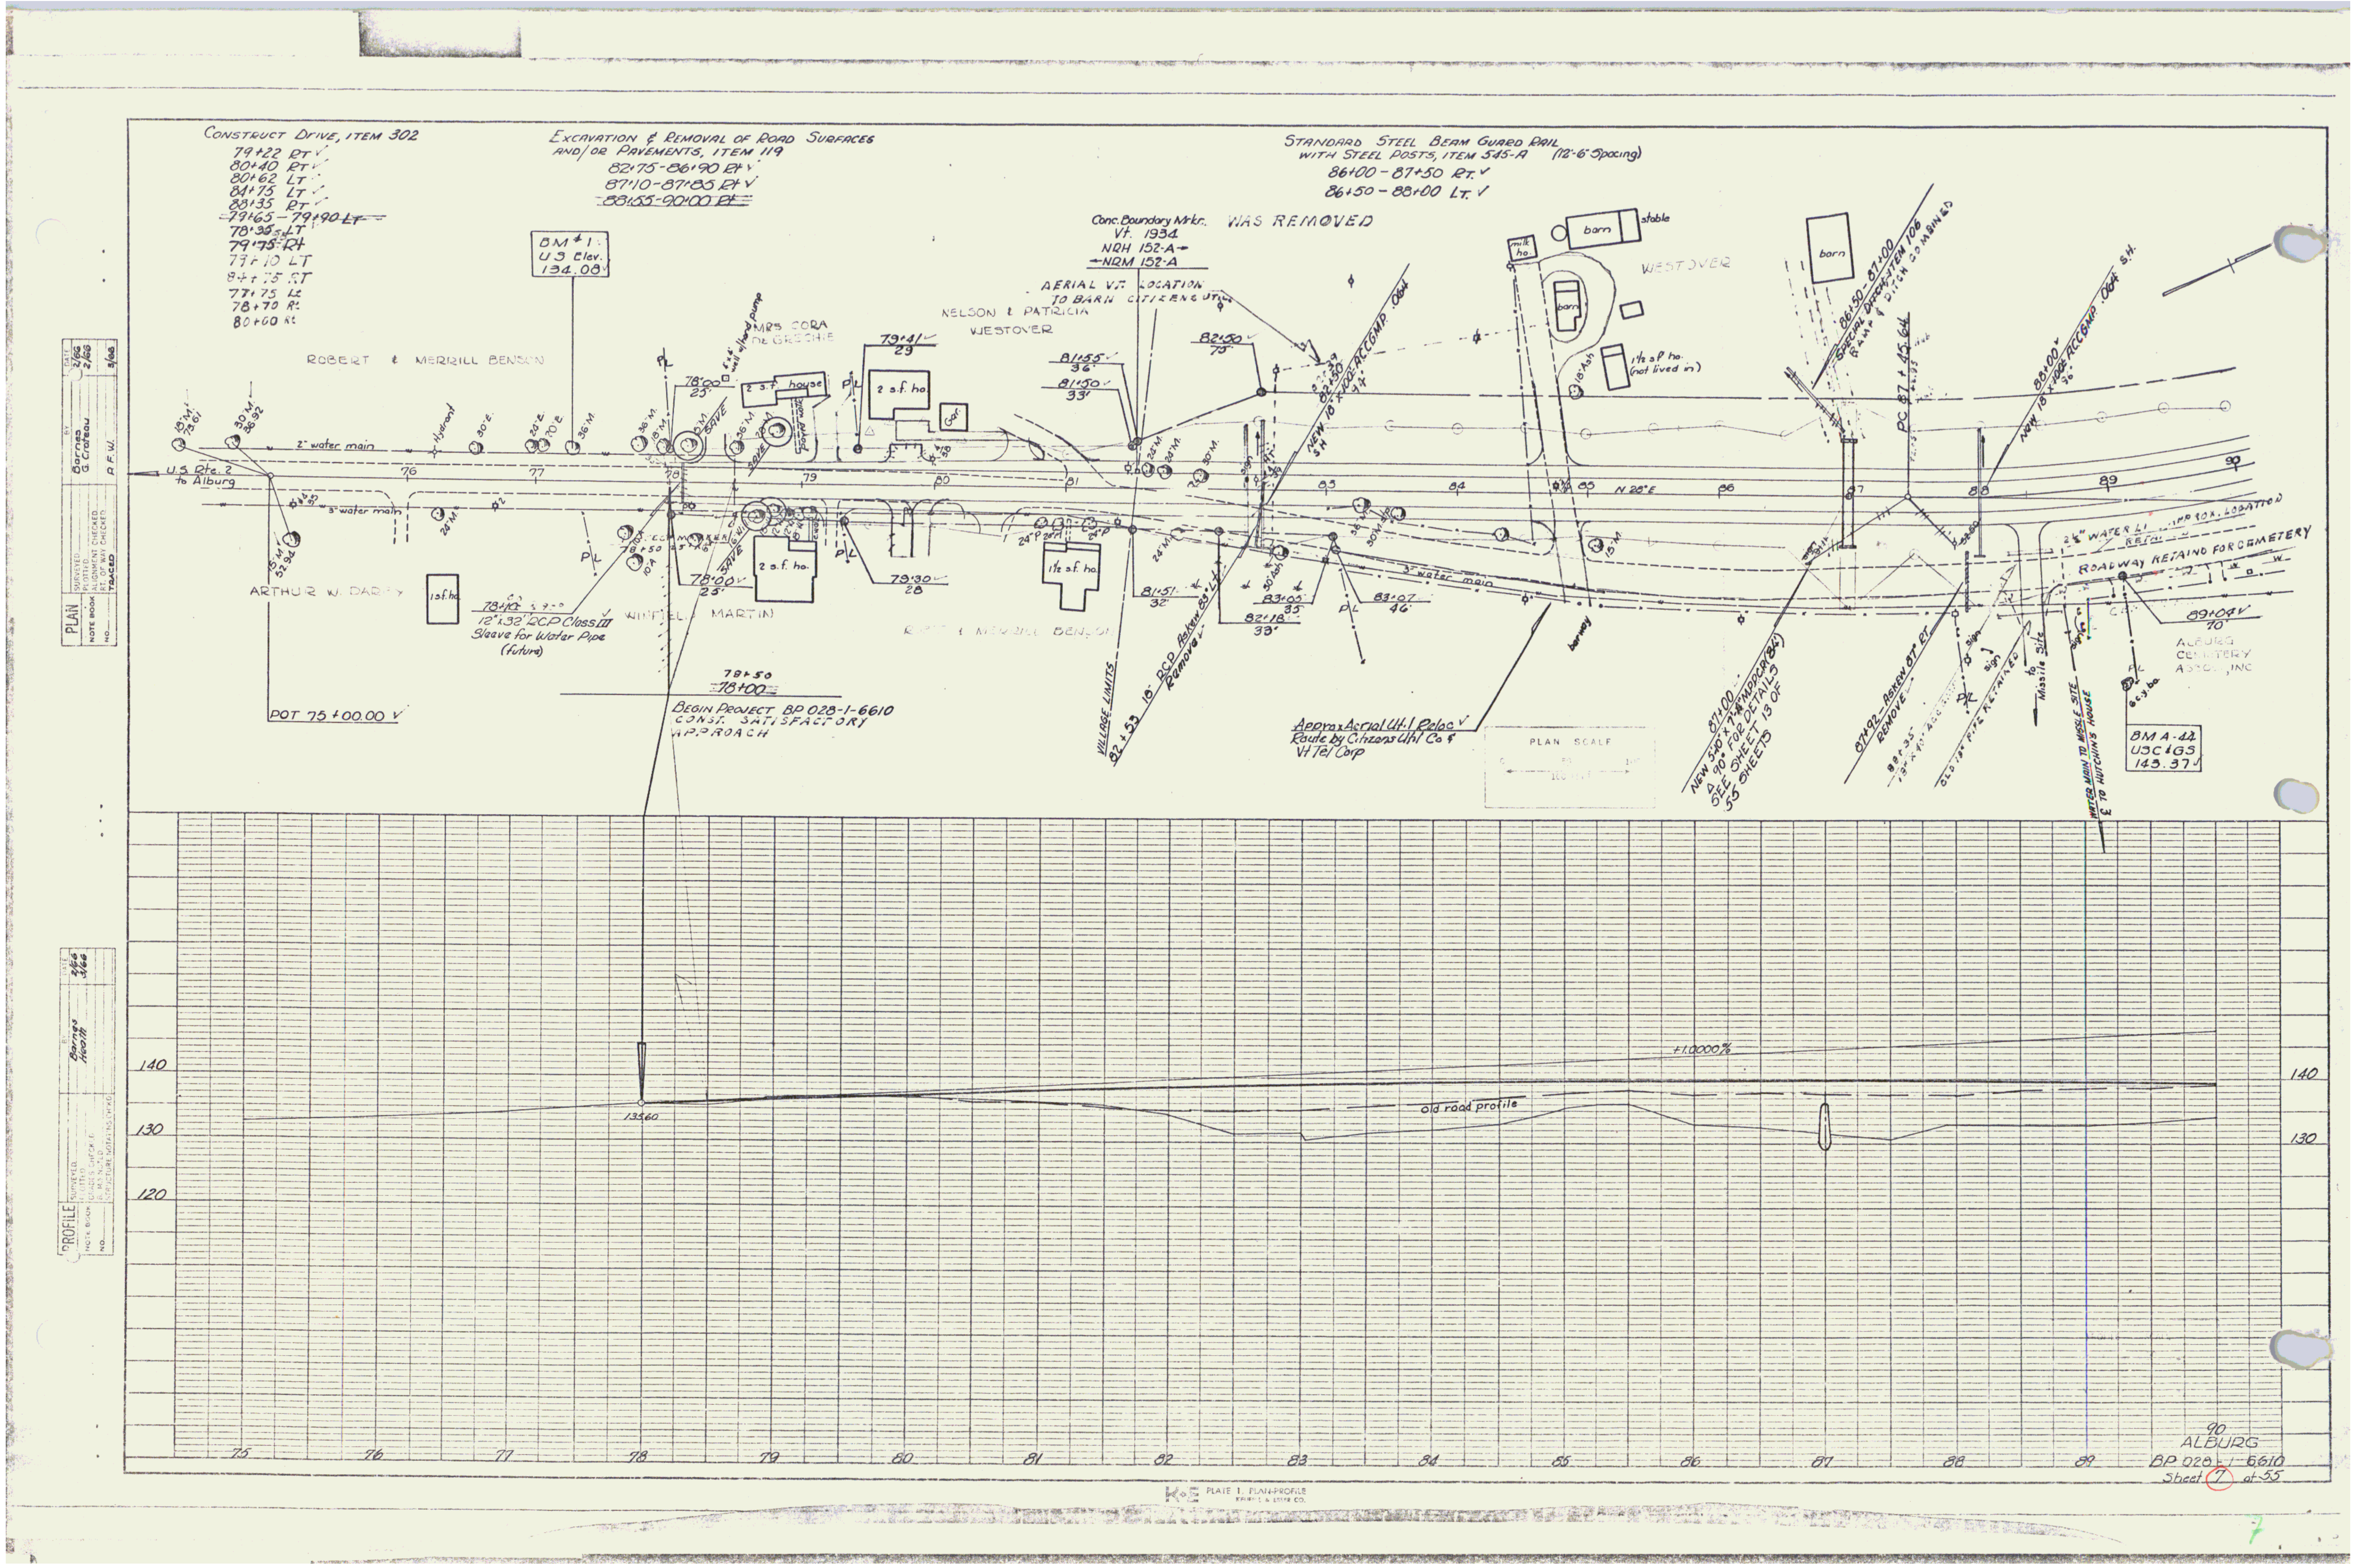

CONSTRUCT DRIVE, ITEM 302
79+22 RT
80+40 RT
80+62 LT
81+75 LT
88+35 RT
79+65 – 79+90 LT
78+35 LT
79+75 Rt
77+10 LT
84+75 RT
77+75 Lt
78+70 Rt
80+60 Rt
EXCAVATION & REMOVAL OF ROAD SURFACES AND/OR PAVEMENTS, ITEM 119
82+75 – 86+90 Rt
87+10 – 87+86 Rt
88+55 – 90+00 Rt
STANDARD STEEL BEAM GUARD RAIL WITH STEEL POSTS, ITEM 545-A (12'-6" Spacing)
86+00 – 87+50 RT.
86+50 – 88+00 LT.
BM #1
U.S. Elev.
134.08
Conc. Boundary Mrkr. WAS REMOVED
Vt. 1934
NRH 152-A
NRM 152-A
AERIAL V.T. LOCATION TO BARN CITIZENS UTIL.
NELSON & PATRICIA WESTOVER
ROBERT & MERRILL BENSON
WESTOVER
barn
stable
2 water main
U.S. Rte. 2 to Alburg
ARTHUR W. DARBY
2 s.f. ho.
1½ s.f. ho.
12"x32' 2CP Class III Sleeve for Water Pipe (future)
POT 75+00.00
BEGIN PROJECT BP 028-1-6610
CONST. SATISFACTORY APPROACH
VILLAGE LIMITS
Approx. Aerial Util. Reloc. Rande by Citizens Util. Co. & Vt. Tel. Corp.
PLAN SCALE
N 20° E
PC 87+45.64
ROADWAY RETAINED FOR CEMETERY
ALBURG CEMETERY ASSOC. INC.
BM A-44
USC & GS
145.37
PLAN
PROFILE
140
130
120
+1.0000%
old road profile
135.60
75
76
77
78
79
80
81
82
83
84
85
86
87
88
89
90
ALBURG
BP 028-1-6610
Sheet 7 of 55
PLATE 1. PLAN & PROFILE