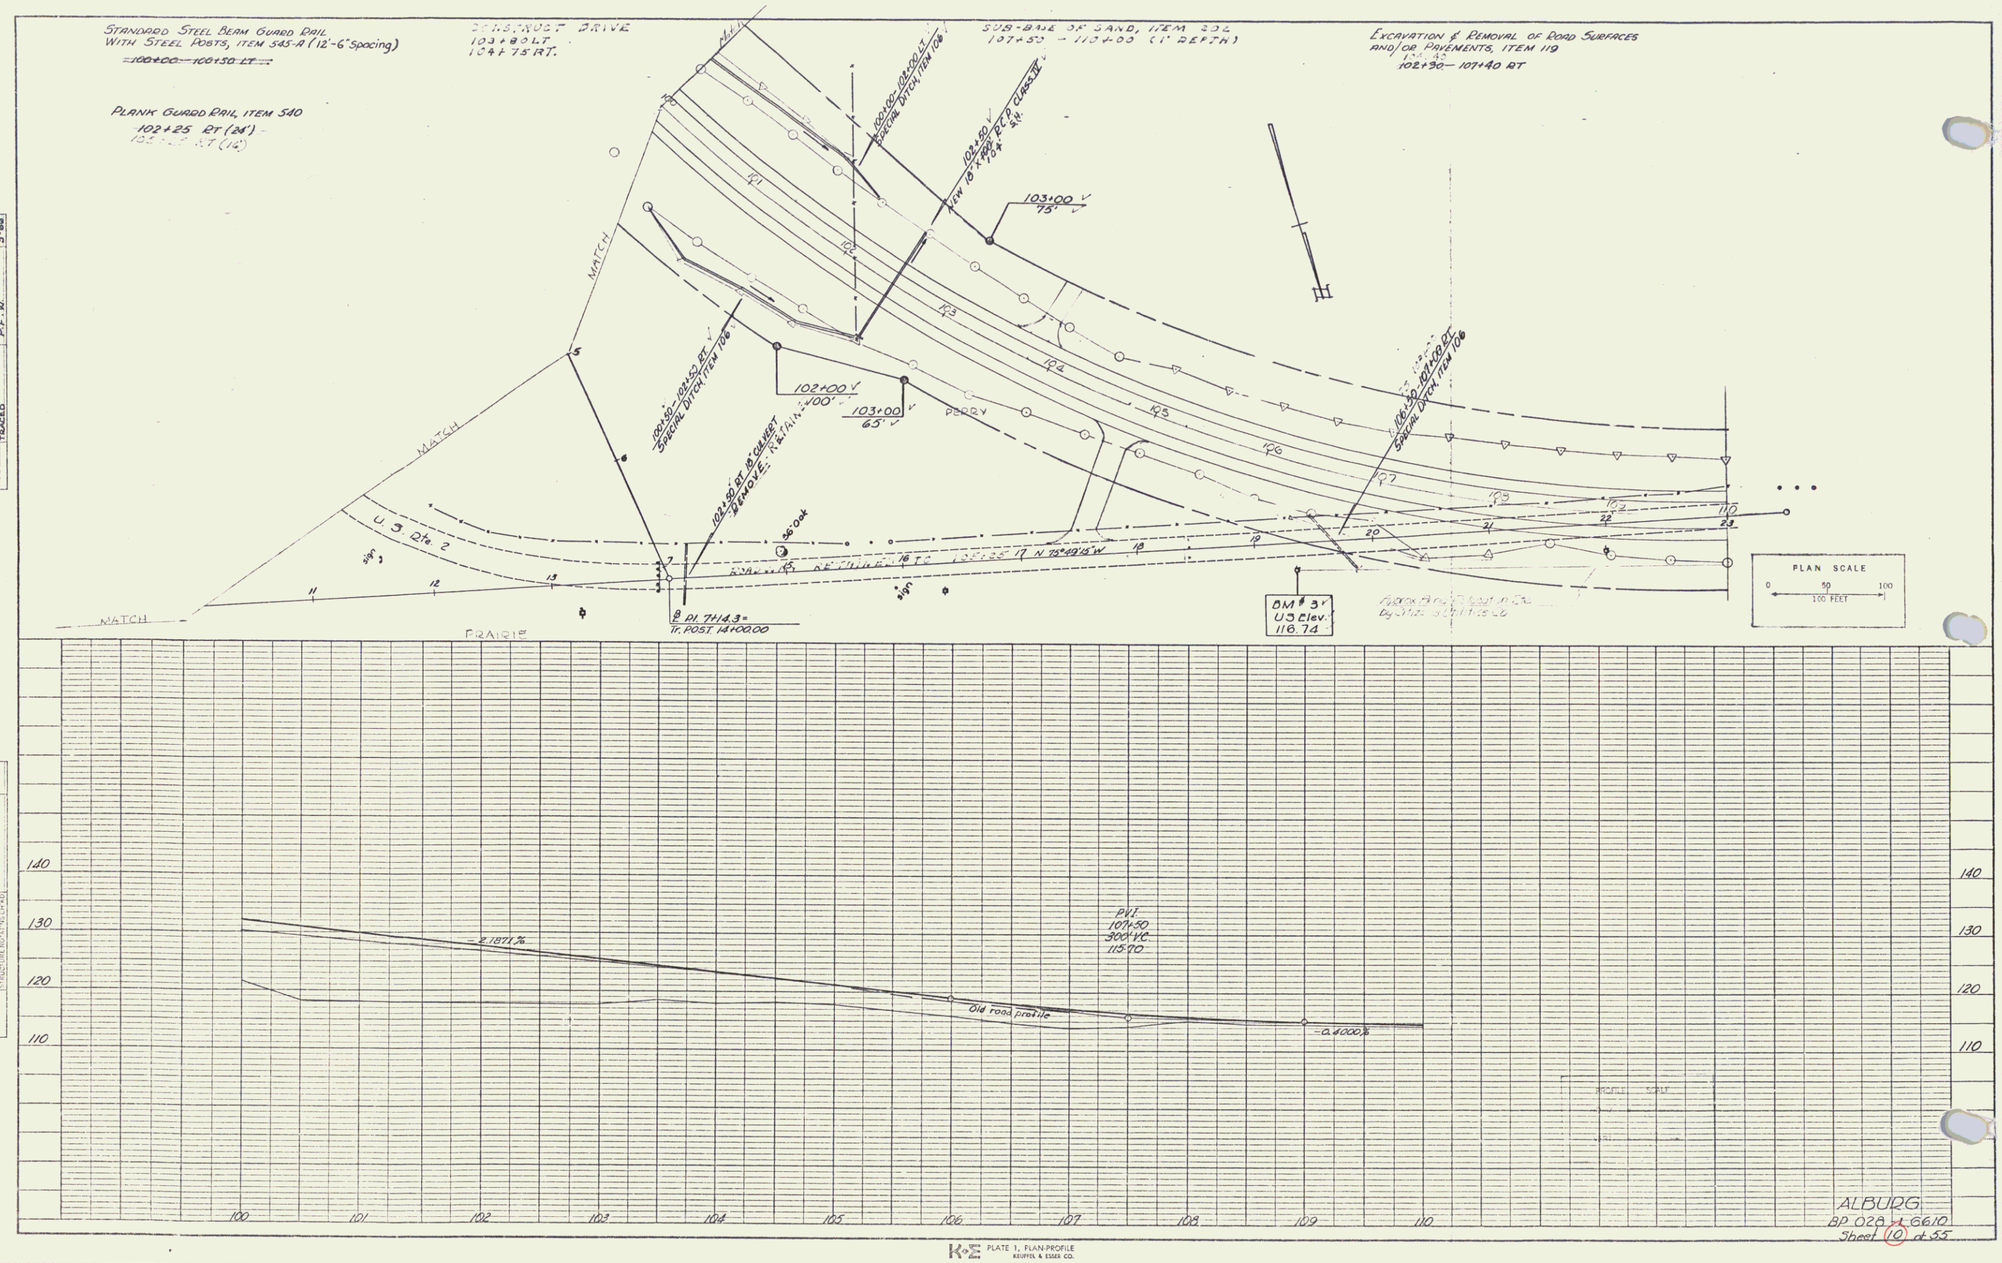

PLAN

PROFILE

K+E PLATE 1, PLAN-PROFILE
KEUFFEL & ESSER CO.

48 7312 IMPERIAL™ TRACING CLOTH

9