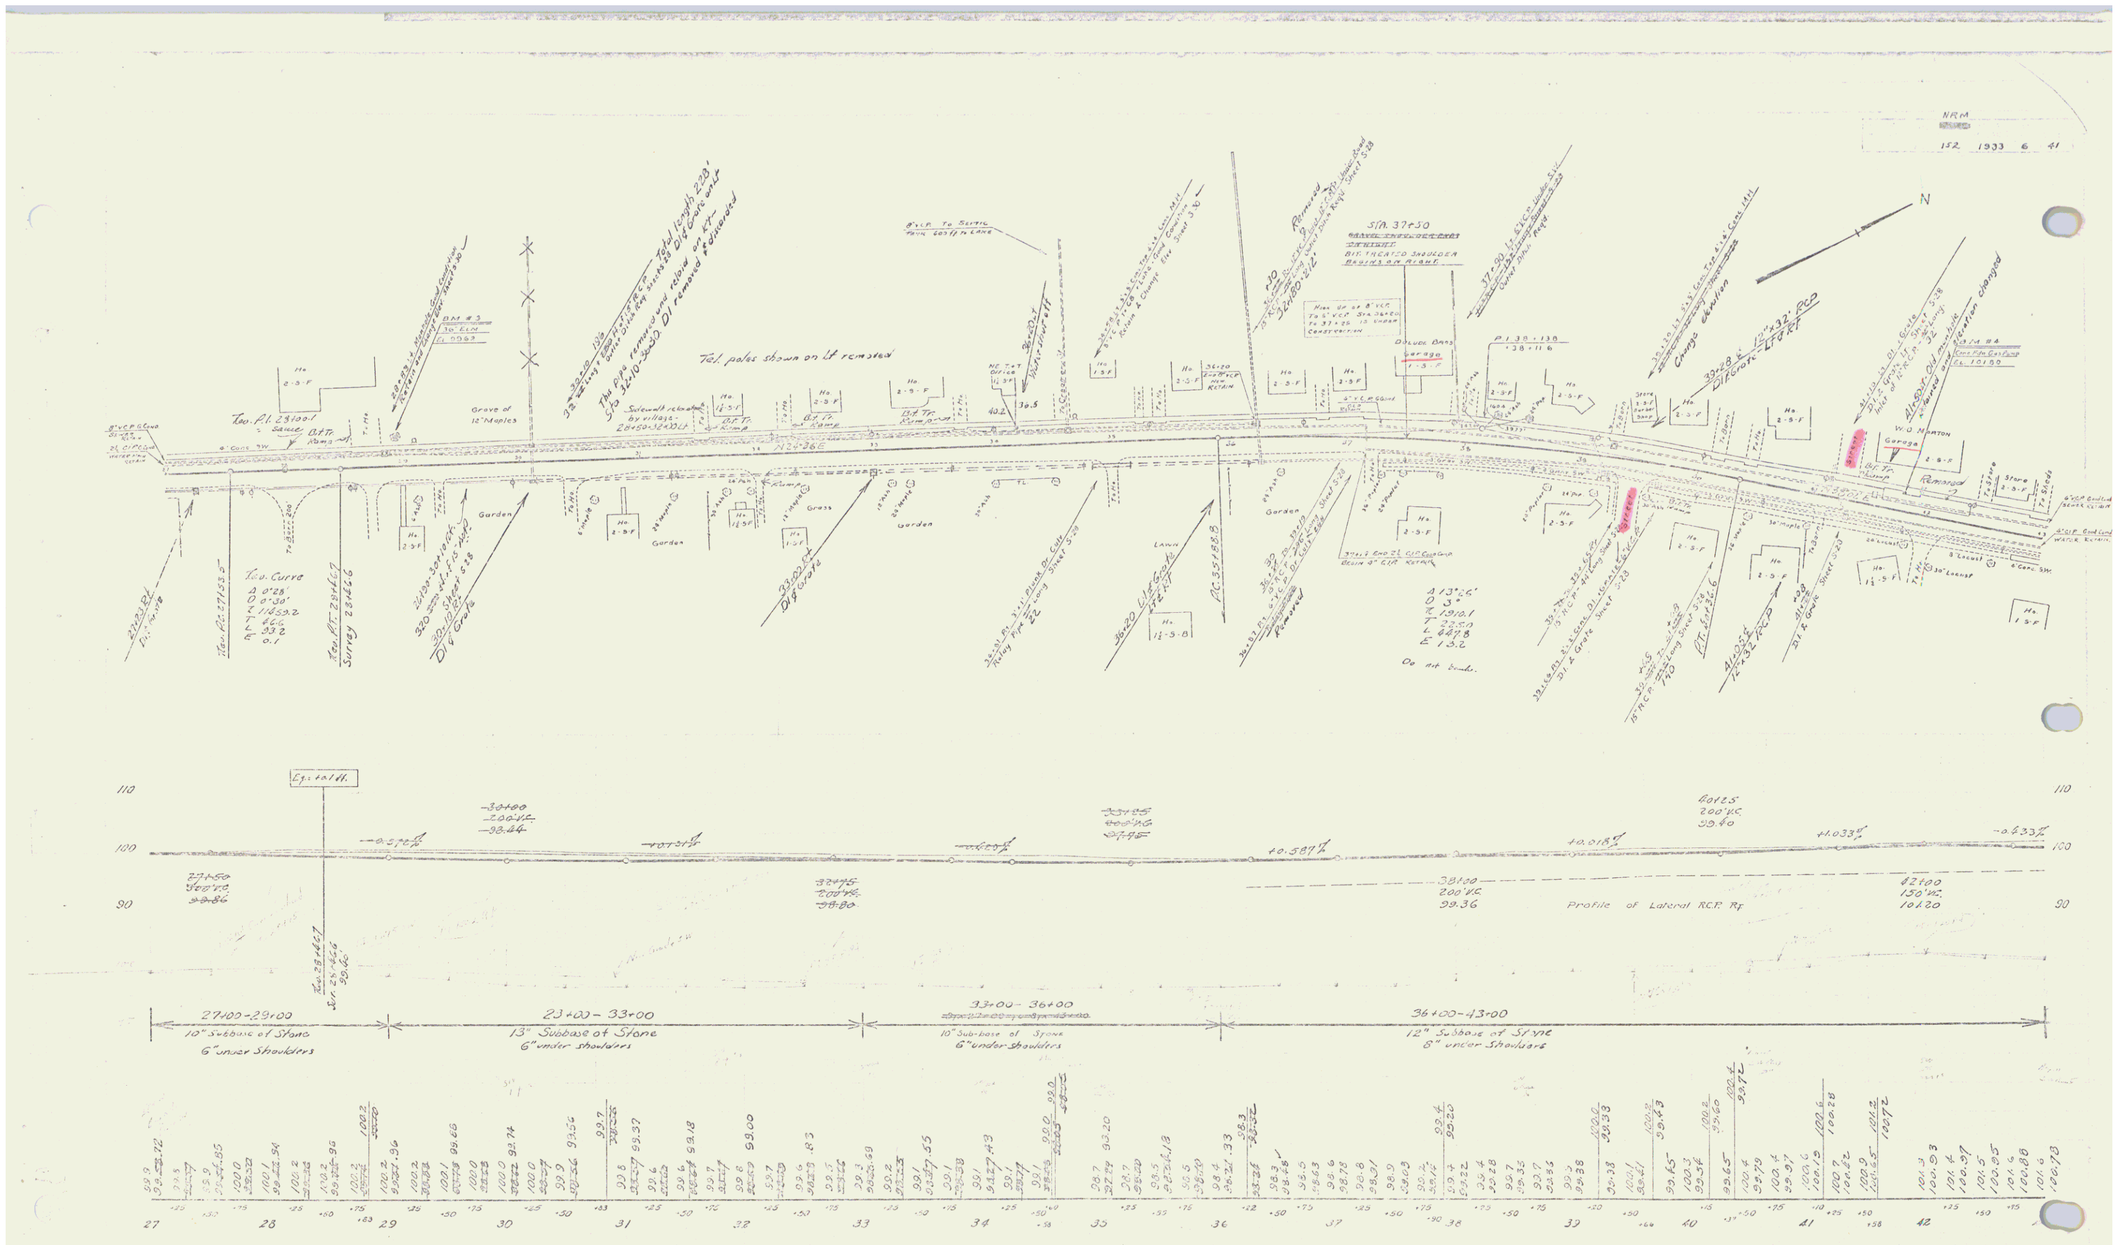
NRM
152 1933 6 41
N
Sta. 37+50
Bit. Treated Shoulder
Begins on Right
Tel. poles shown on lt removed
Grove of 12" Maples
Garden
Grass
Lawn
Remnant
Profile of Lateral RCP Rt
27+00-29+00
10" Subbase of Stone
6" under Shoulders
29+00-33+00
13" Subbase of Stone
6" under Shoulders
33+00-36+00
10" Subbase of Stone
6" under Shoulders
36+00-43+00
12" Subbase of Stone
8" under Shoulders
SERIES NRM 152
SHEET 6 OF 41

4