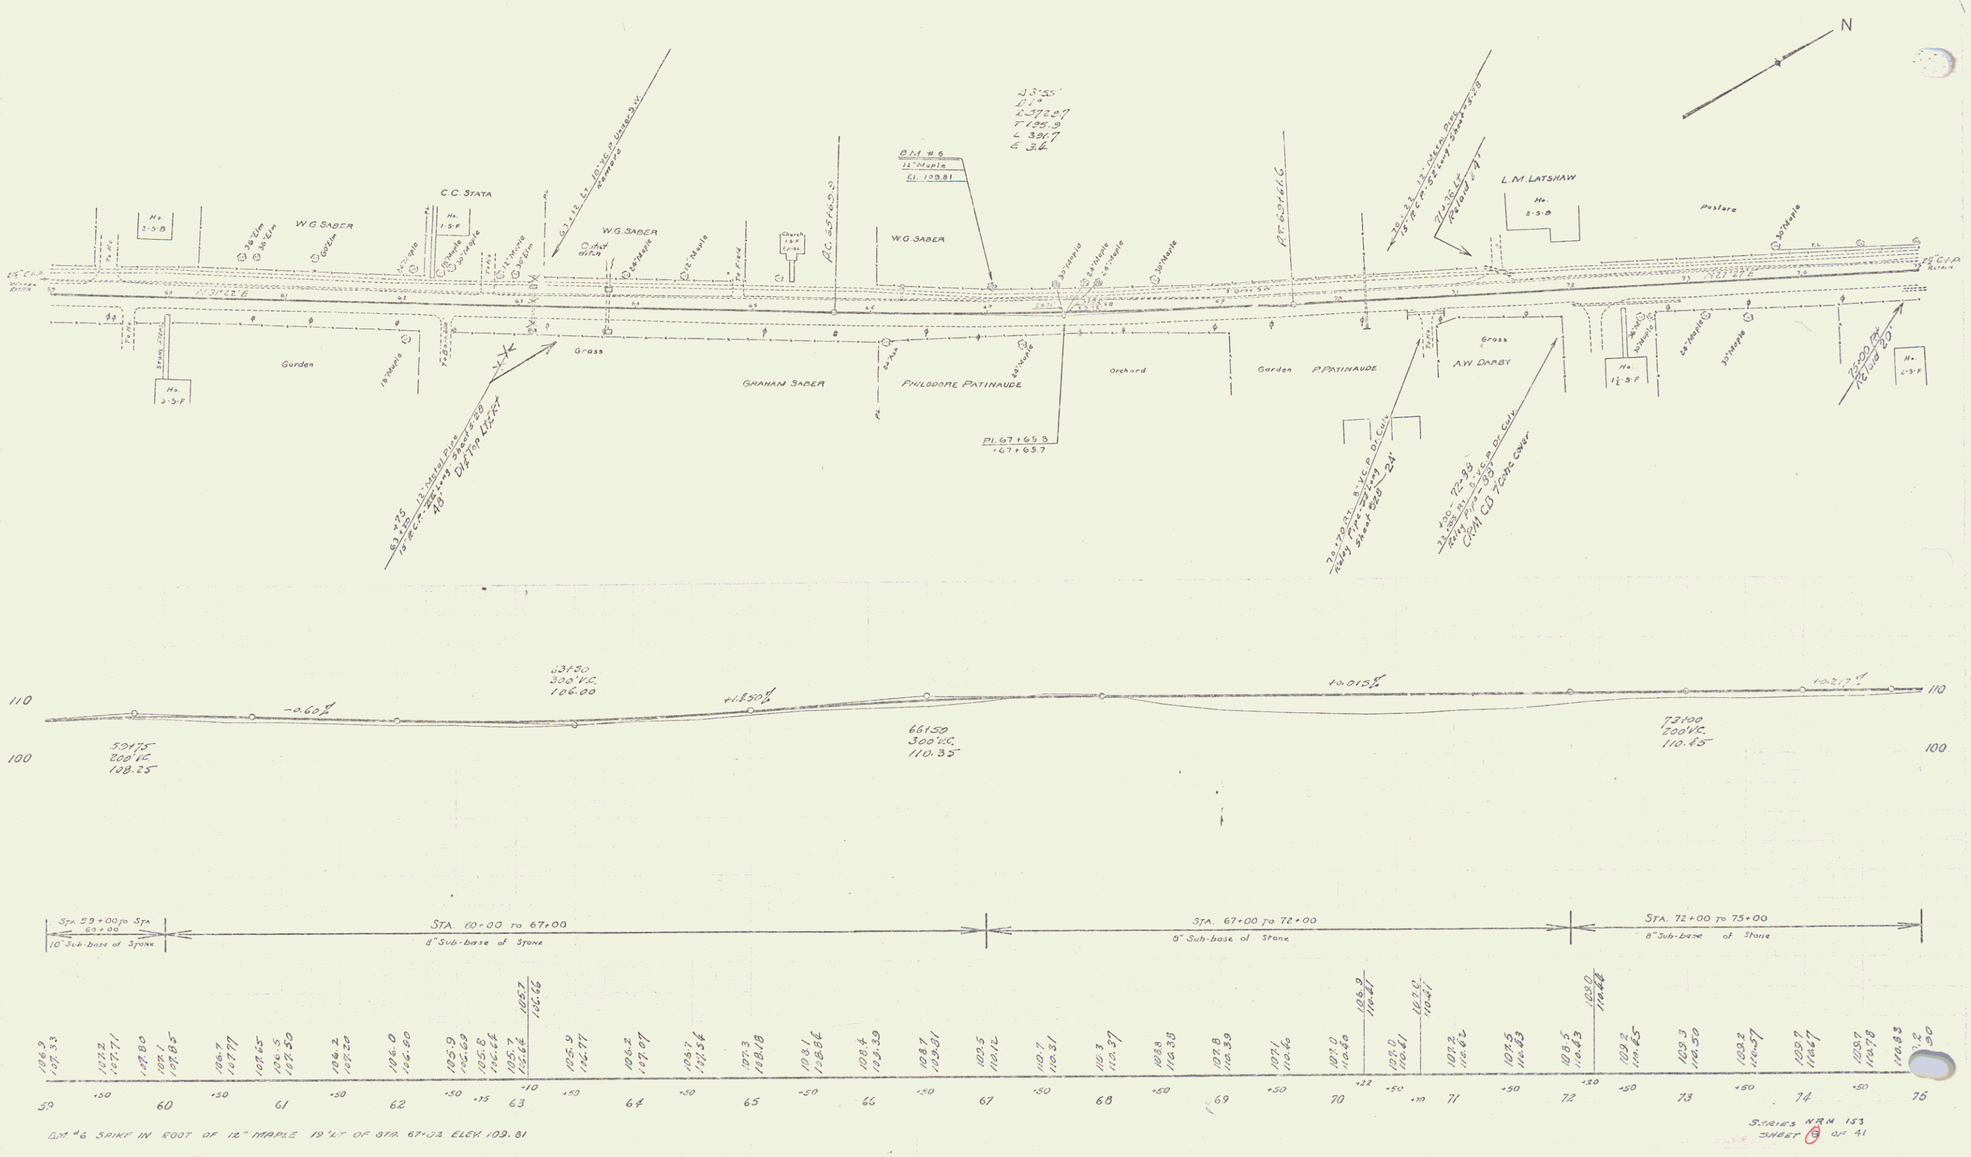
N
C.C. STATA
W.G. SABER
GRAHAM SABER
PHILODORE PATINAUDE
P. PATINAUDE
A.W. DARBY
L.M. LATSHAW
Garden
Grass
Orchard
Pasture
B.M. #6
12" Maple
El. 109.81
Pl. 67+65.3
STA. 60+00 to 67+00
8" Sub-base of Stone
STA. 67+00 to 72+00
8" Sub-base of Stone
STA. 72+00 to 75+00
8" Sub-base of Stone
B.M. #6 SPIKE IN ROOT OF 12" MAPLE 19' LT. OF STA. 67+02 ELEV. 109.81
SERIES N.R.M. 153
SHEET 8 OF 41

16