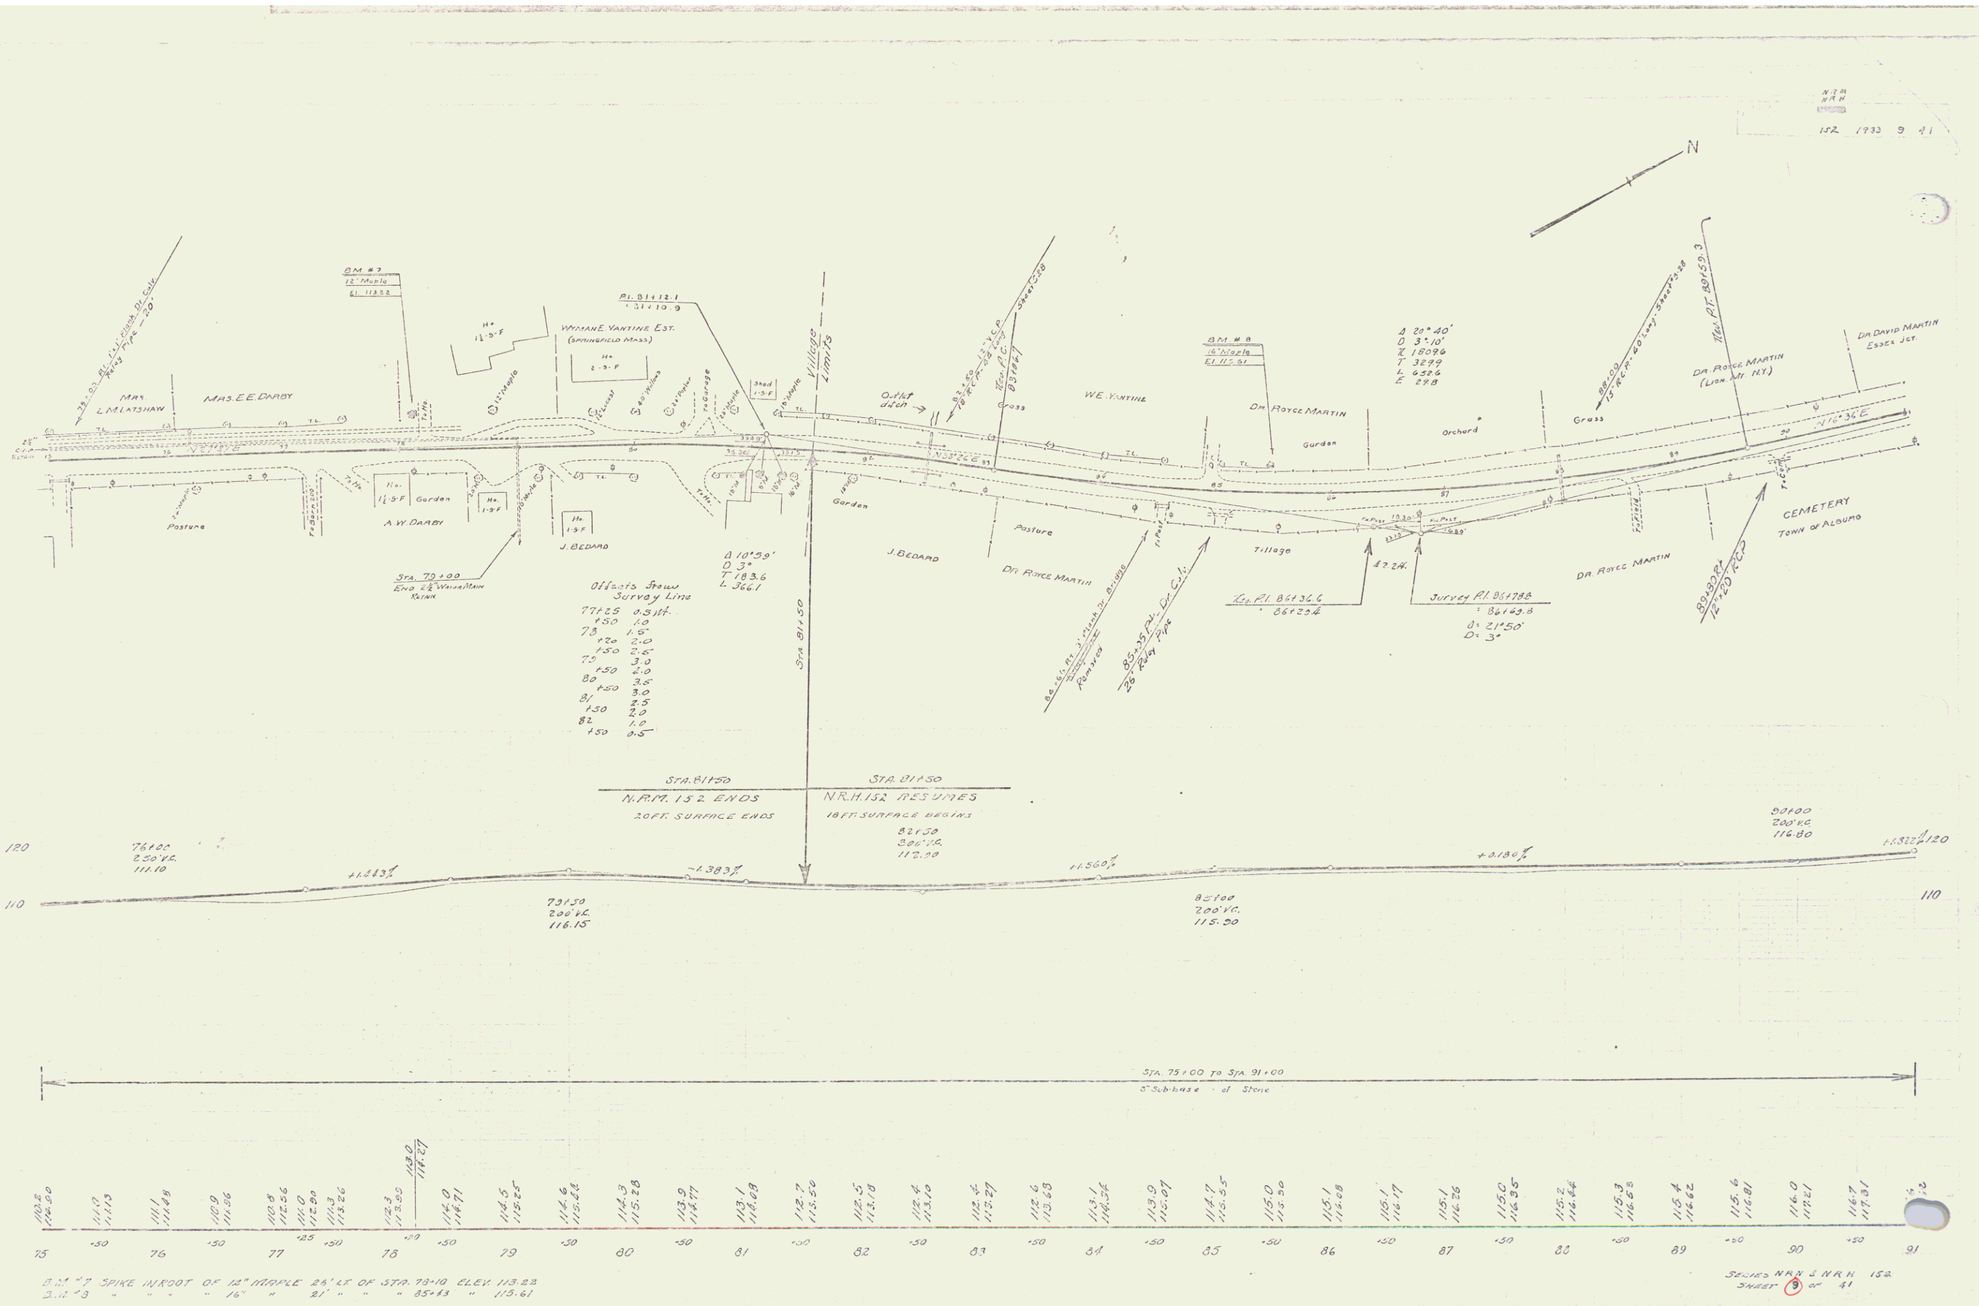
N
Mrs. L.M. LATSHAW
Mrs. E.E. DARBY
A.W. DARBY
J. BEDARD
WILLIAM E. YANTINE EST. (SPRINGFIELD MASS.)
W.E. YANTINE
Dr. ROYCE MARTIN
Dr. ROYCE MARTIN (LION MT. NY.)
Dr. DAVID MARTIN ESSEX JCT.
CEMETERY TOWN OF ALBUMS
Village Limits
Sta 81+50
Sta. 79+00 End 12" Water Main
Offsets from Survey Line
Sta. 81+50
N.R.H. 152 ENDS
20 FT. SURFACE ENDS
N.R.H. 152 RESUMES
18 FT. SURFACE BEGINS
Sta. 75+00 to Sta. 91+00
8" Sub-base of Stone
B.M. #7 12" Maple El. 113.32
B.M. #8 16" Maple El. 117.61
B.M. "F" Spike in root of 12" Maple 26' Lt. of Sta. 78+10 Elev. 113.22
B.M. "G" " " " " 16" " 21' " " " 85+43 " 115.61
Series N.R.H. & N.R.H. 152
Sheet 9 of 41

17