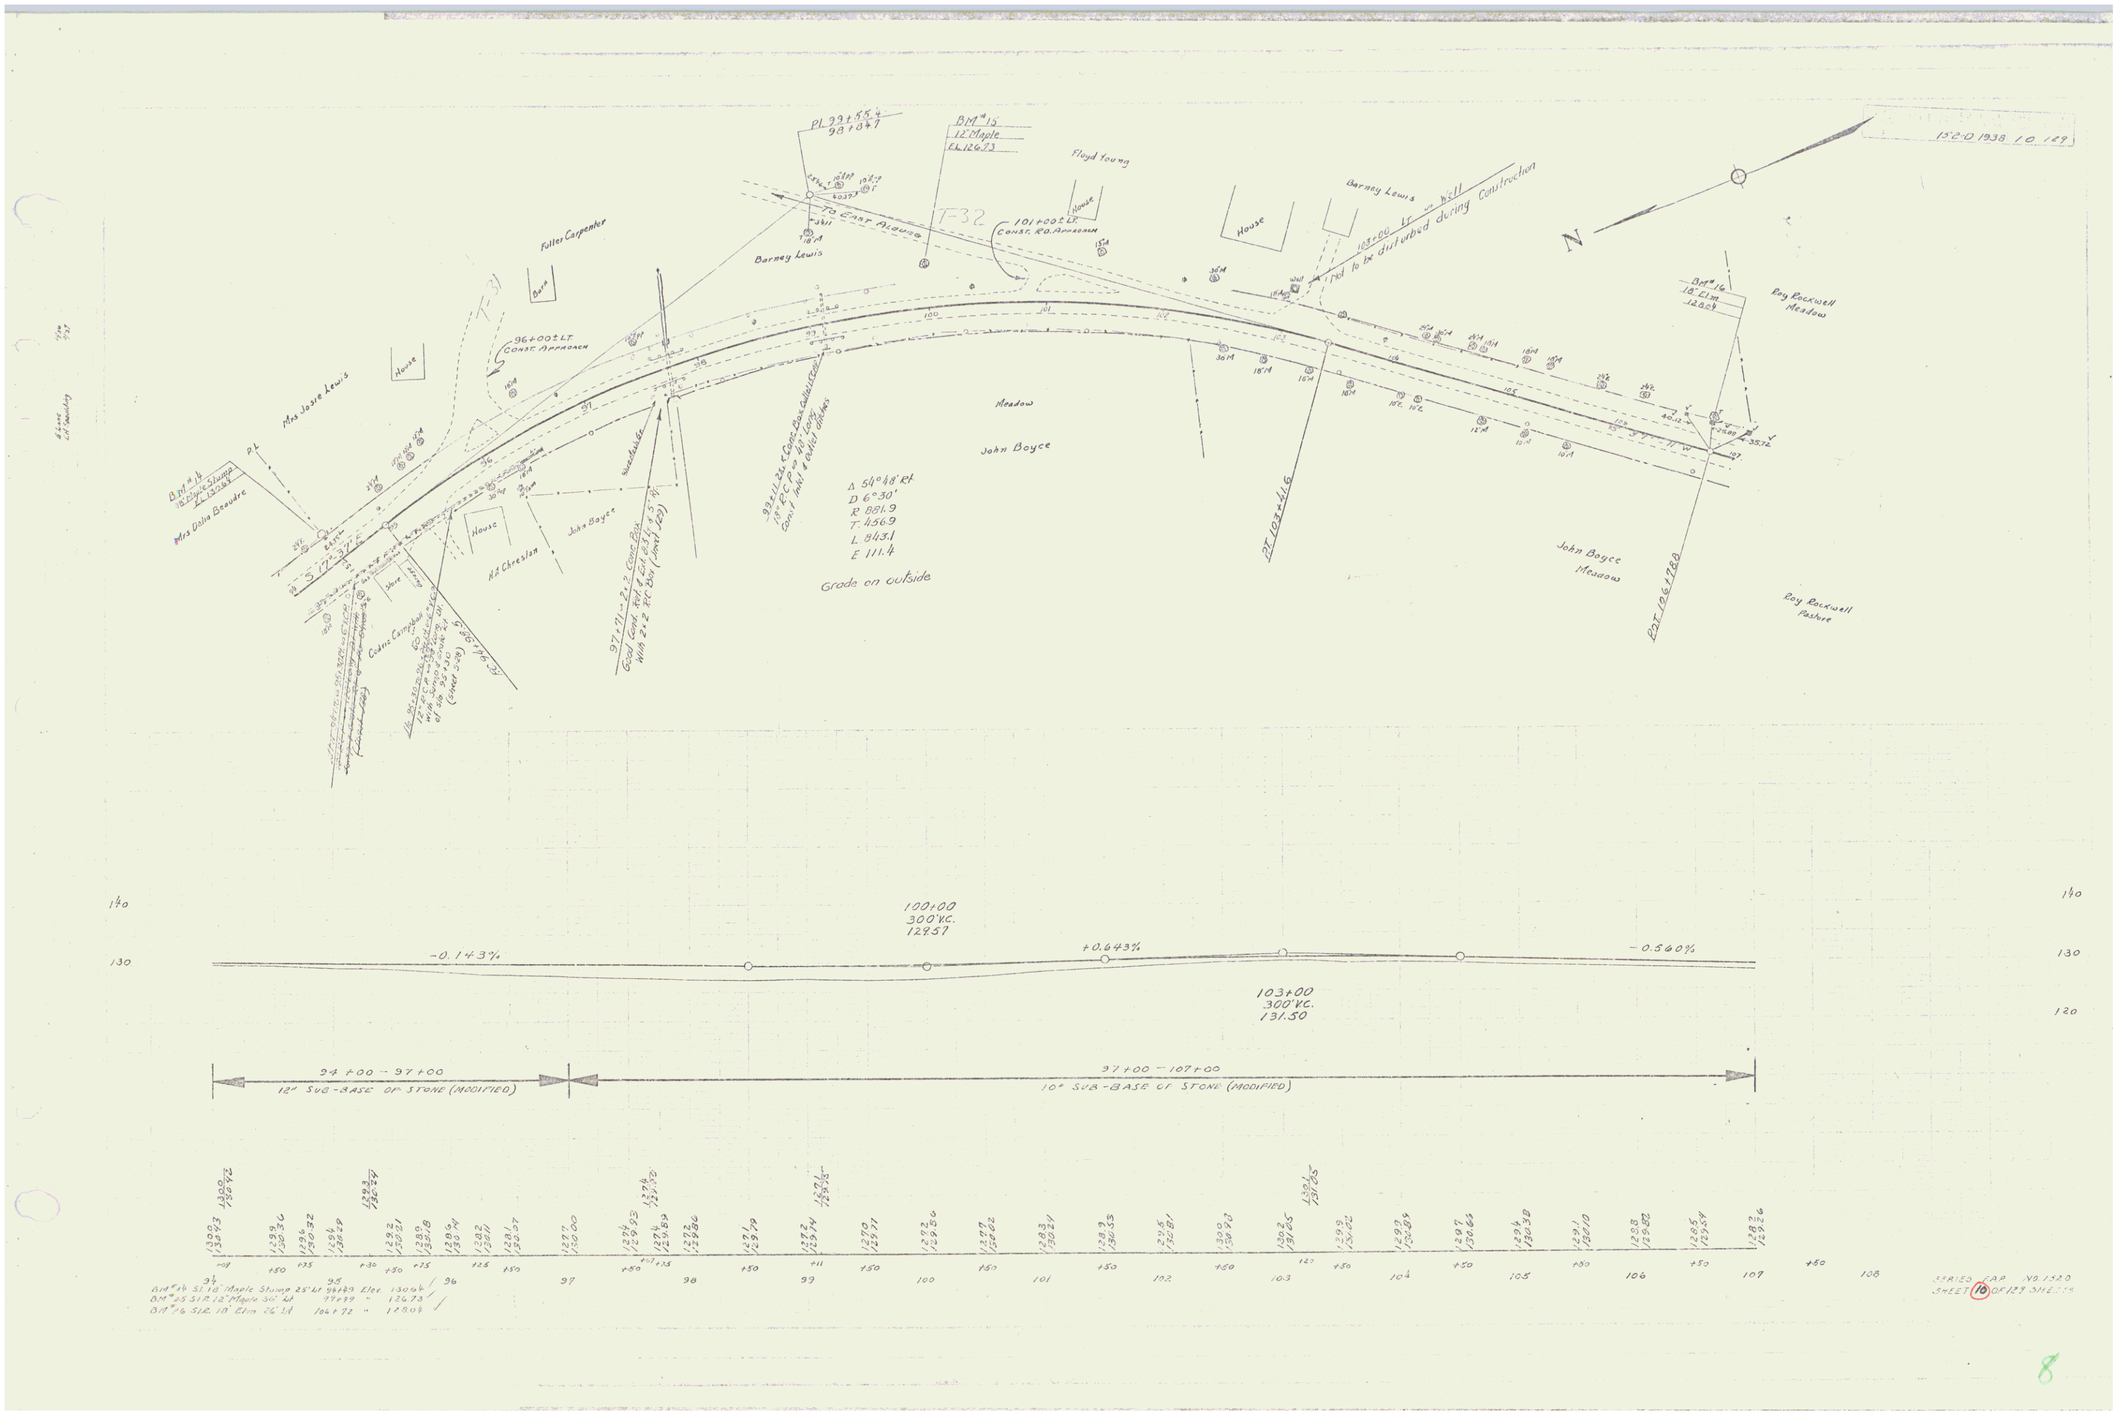
15-2-0 1938 10 129
N
Floyd Young
Barney Lewis
Fuller Carpenter
Mrs Jesse Lewis
Mrs Della Beaudre
Mrs Chrestian
Cedric Campbell
John Boyce
Meadow
Roy Rockwell Meadow
Roy Rockwell Pasture
House
Barn
Shed
Woodshed
TO CONST. ALBANY
T-32
T-31
101+00 ± LT. CONST. RD. APPROACH
96+00 ± LT. CONST. APPROACH
103+00 ± LT. on hill Not to be disturbed during Construction
PL 99+58.4 98+84.7
BM #15 12" Maple EL 126.73
BM #16 18" Elm EL 128.04
BM #14 18" Maple Stump
Δ 54°18' Rt
D 6°30'
R 881.9
T. 456.9
L 843.1
E 111.4
Grade on outside
PT 103+41.6
PT 106+17.80
S 17°37'E
-0.143%
+0.643%
-0.560%
100+00 300' VC. 127.57
103+00 300' VC. 131.50
94+00 - 97+00
12" SUB-BASE OF STONE (MODIFIED)
97+00 - 107+00
10" SUB-BASE OF STONE (MODIFIED)
BM #14 SIR 18" Maple Stump 25' Lt 94+89 Elev. 130.64
BM #15 SIR 12" Maple 30' Rt 99+99 " 126.73
BM #16 SIR 18" Elm 26' Rt 104+72 " 128.04
SERIES 1.00 VOL 1320
SHEET 10 OF 129 SHEETS

8