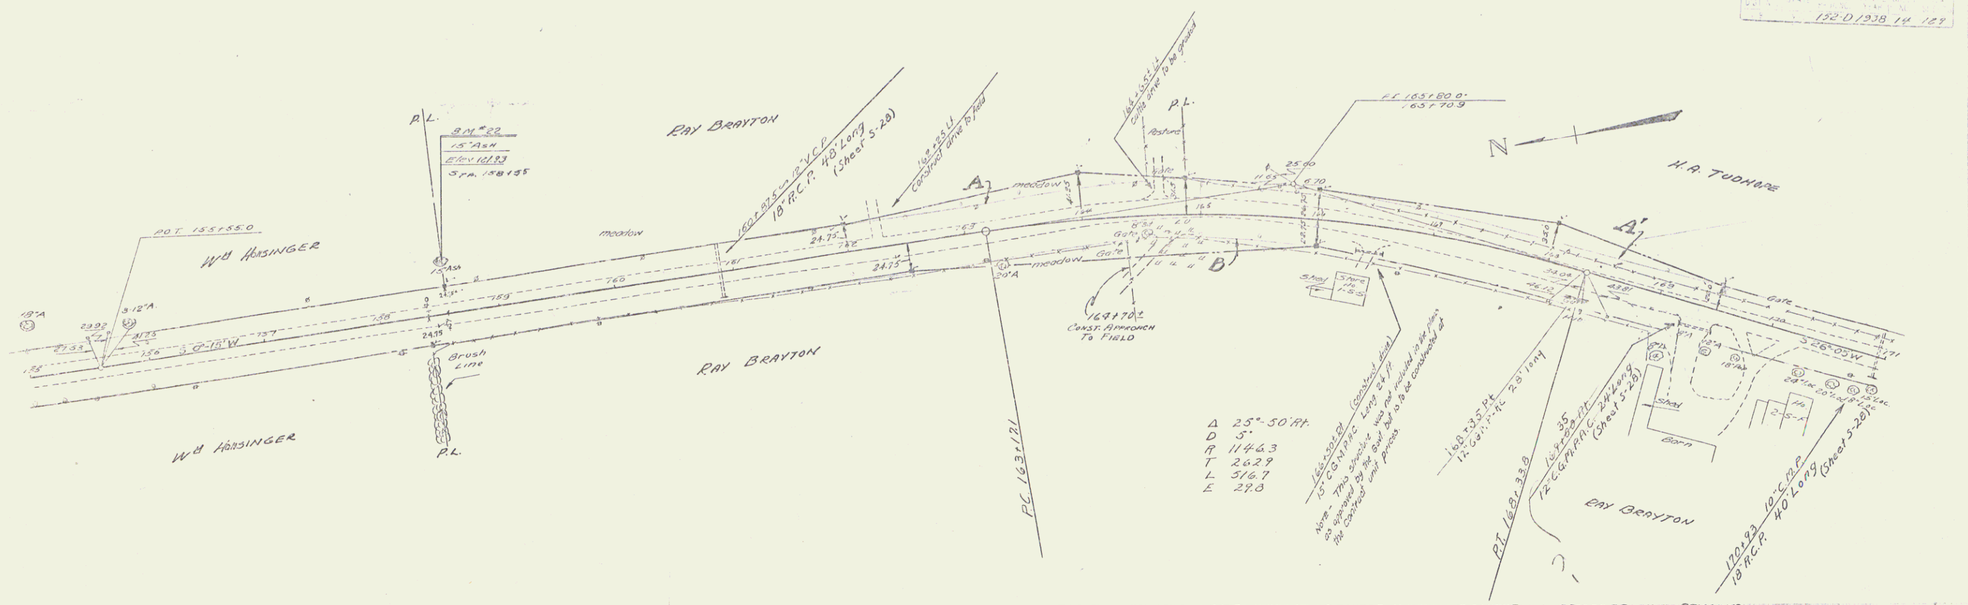
132 D 1938 14 129
RAY BRAYTON
W.H. HASINGER
H.A. TUDHOPE
meadow
Gate
Barn
Shed
Brush Line
P.L.
P.T. 155+55.0
P.T. 165+80.0
Δ 25°-50' Rt.
D 5°
R 1146.3
T 262.9
L 516.7
E 29.8
PARCEL INSTRUMENT DATE GRANTOR GRANTEE RECORDED ALBURQ. REMARKS
BOOK PAGE DATE
A-B Q.C.D. 9-8-37 RAY BRAYTON 37.0 ac. Rt. 30 274-75 9-27-37
A' Q.C.D. 9-8-37 H.A. TUDHOPE & BURLINGTON SAVINGS BANK " 30 276-79 9-16-37
+0.300%
+4.000%
-1.162%
161+50
400' V.C.
123.20
167+75
300' V.C.
148.20
156+25
250' V.C.
129.30
155+00 - 157+00
12" SUB-BASE OF STONE (MODIFIED)
157+00 — 167+00
10" SUB-BASE OF STONE (MODIFIED)
167+00 - 169+50
12" SUB-BASE OF STONE (MODIFIED)
169+50 - 171+00
10" SUB-BASE OF STONE (WOOD)
SCALED MAP NO. 1320
SHEET 14 OF 127 SHEETS