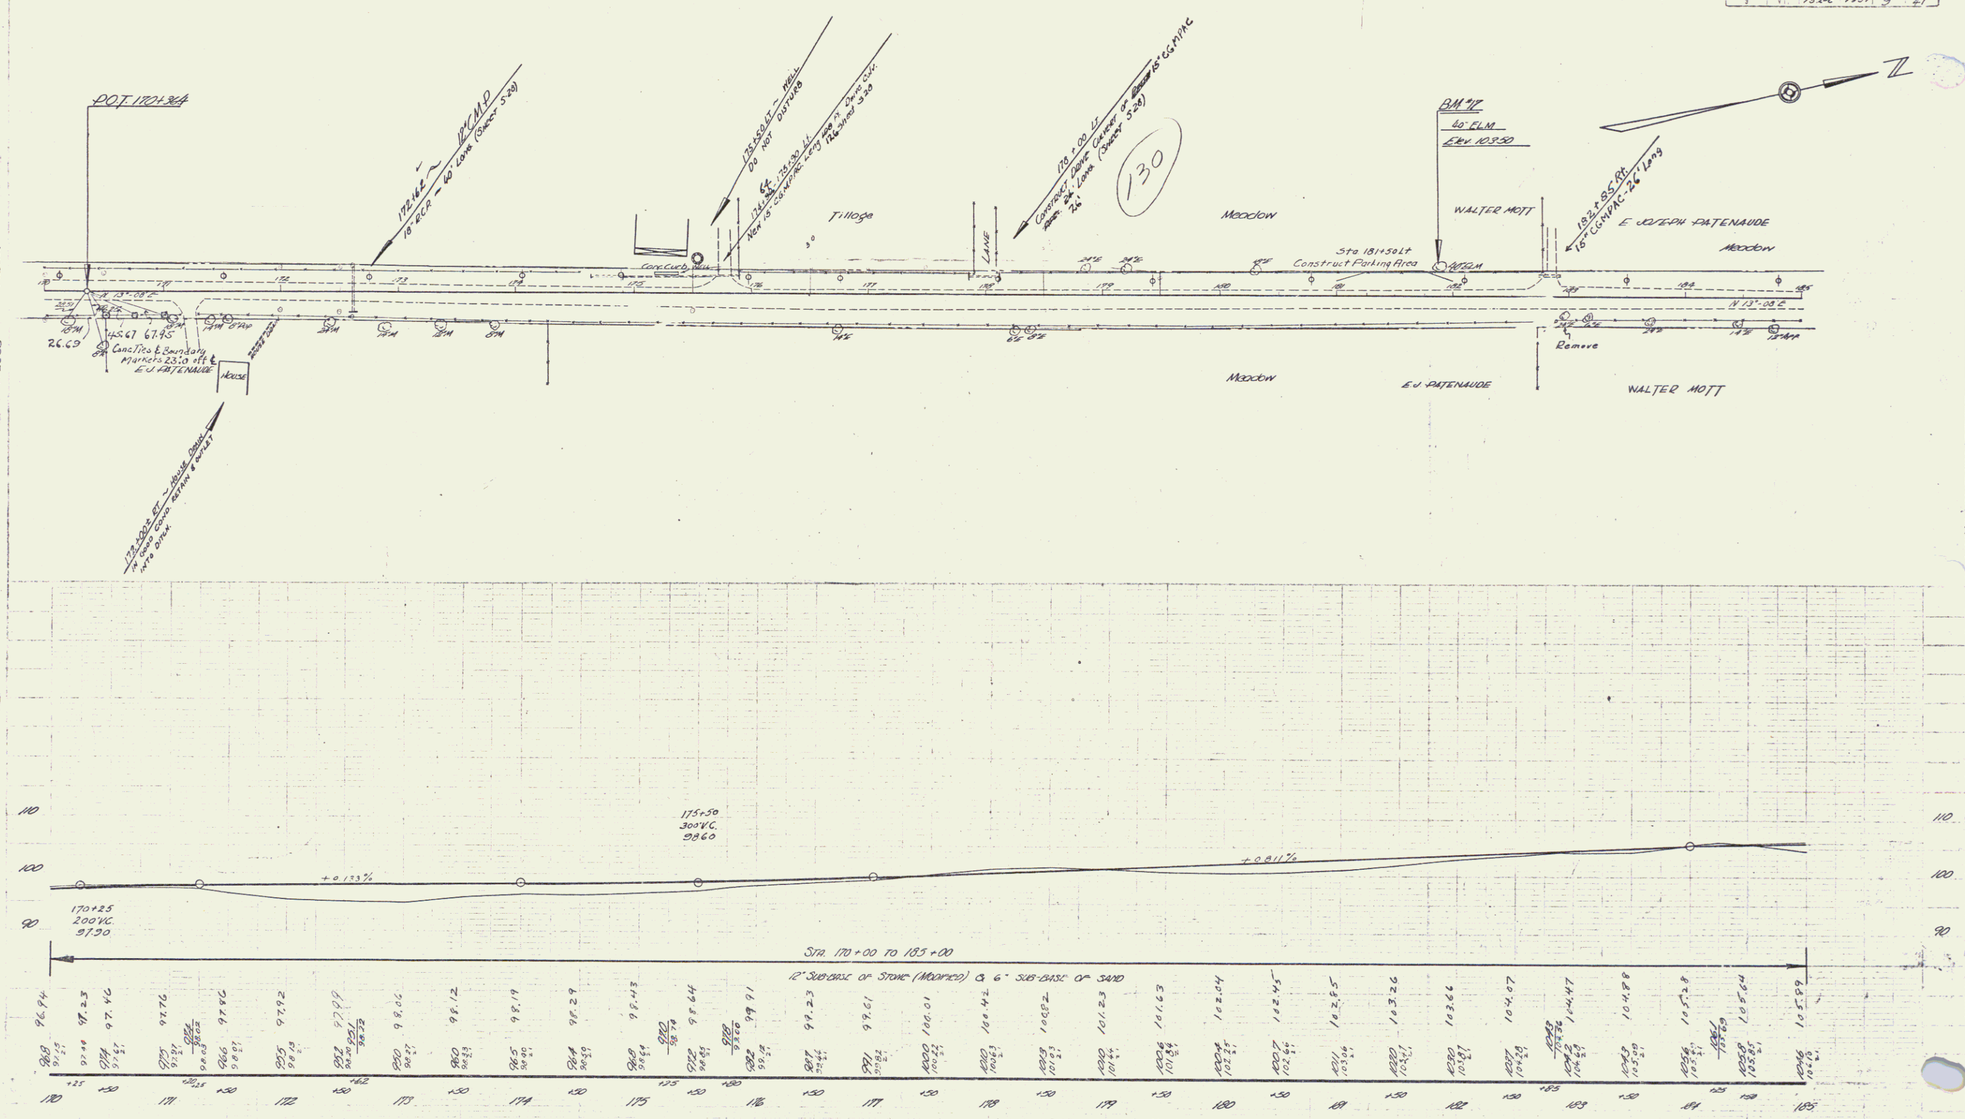FED. AID PROJ. NO.	STATE	FED. AID PROJ. NO.	SHEET NO.	TOTAL SHEETS
9	VT.	152-C 1937	9	41