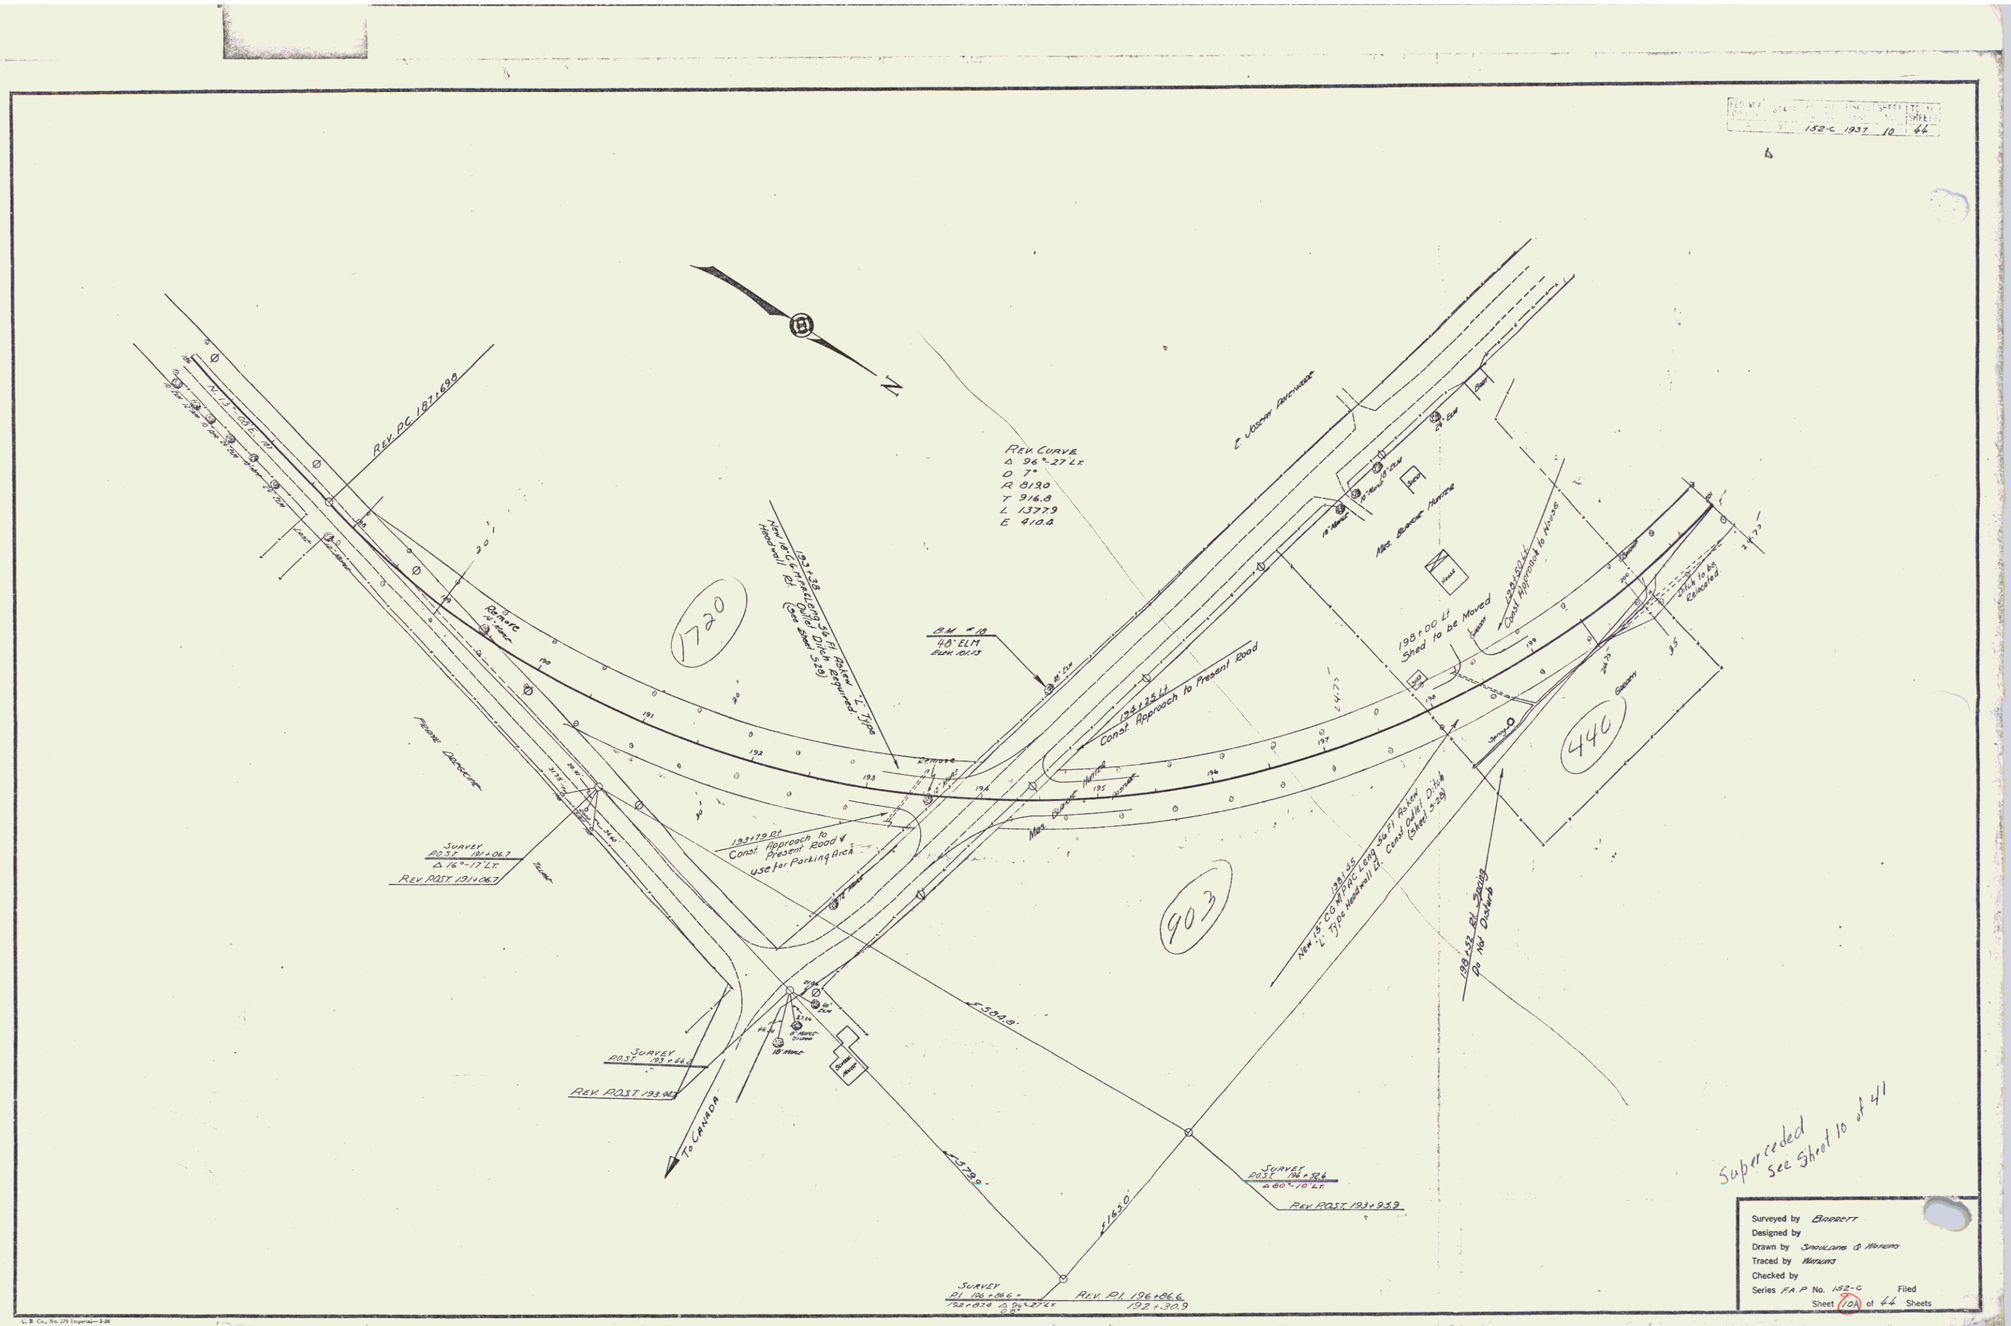

Superceded
See Sheet 10 of 41

Surveyed by Bassett
Designed by
Drawn by Sprouldone & Morrison
Traced by Morrison
Checked by
Series F.A.P No. 152-C Filed
Sheet 10A of 44 Sheets

C. B. Co., No. 279 Imperial—3-26

9