7 Final Earthwork Sheets
23 Drainage Sheets
8 Wall Sheets (Rip Wall)

STATE OF VERMONT
DEPARTMENT OF HIGHWAYS

PROPOSED IMPROVEMENT

TOWN OF HARTFORD
COUNTY OF WINDSOR
INTERSTATE ROUTE 89
LEBANON, N.H.–MONTPELIER ROAD
PROJECT I 89-1 (3)

BEGINNING AT A POINT 0.039 MILE WESTERLY OF THE NEW HAMPSHIRE-VERMONT STATE LINE AND EXTENDING NORTHWESTERLY 0.958 MILE

LENGTH OF ROADWAY 5,032.34 FEET = 0.953 MILE
LENGTH OF BRIDGE 23.66 FEET = 0.005 MILE
LENGTH OF PROJECT 5,056.00 FEET = 0.958 MILE

ROW Project I 89-1(13)
Pin # 99R006

ADT 1958 2170
ADT 1985 7000
DHV 1985 1020
D 55 %
T 8 %
V 60 M.P.H.

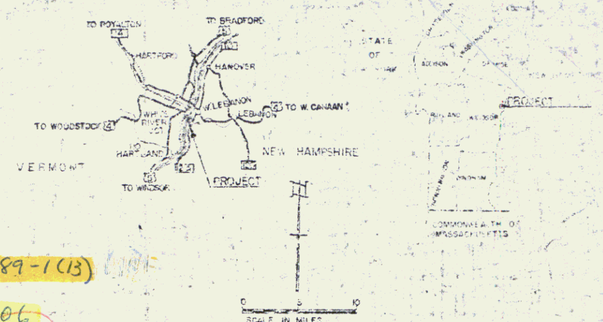

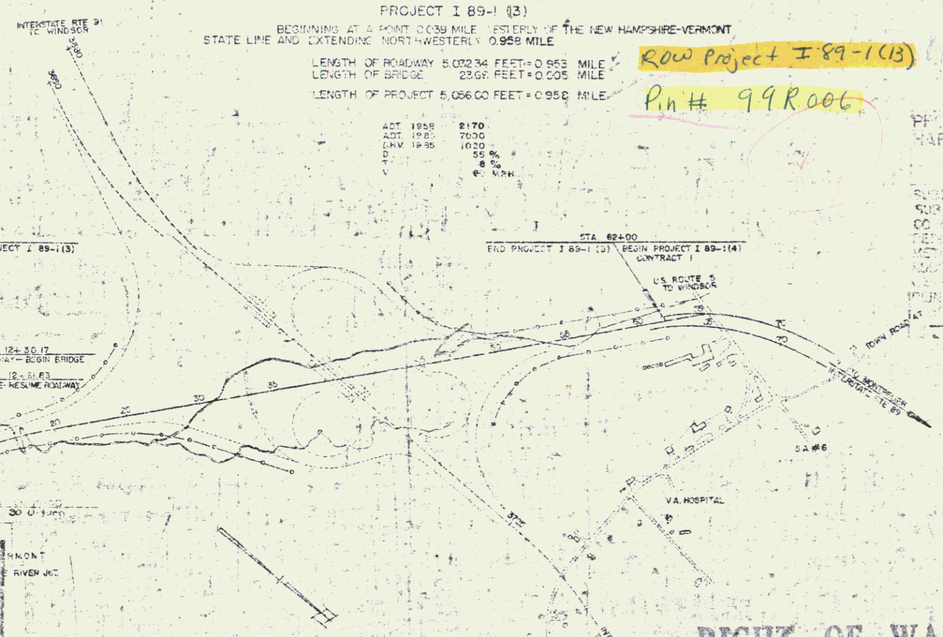

PROJECT NAME & NUMBER TYPE STAGE
HARTFORD I 89-1 (3) GRADING & DRAINAGE
RECORD PLANS
MATERIALS
SUBBASE OF GRAVEL—COULTON PIT—HARTFORD, VT.
SUBBASE OF SAND—LUCE PIT—HARTFORD, VT.
CONCRETE, CLASS C—HILLER TRADITIX CONCRETE—WILLIAMSTOWN, VT.
REINFORCING STEEL—REPUBLIC STEEL CORP.—BUFFALO, N.Y.
[illegible]
[illegible]
CONTRACTOR—LAMOILLE CONSTRUCTION CO. INC.
MORRISVILLE, VT.
CHIEF RESIDENT ENGINEER—ROY F. NICHOLS
RESIDENT ENGINEER—[illegible], GORDON D. [illegible]
INSPECTORS—SHIRLEY A. KENYON, [illegible]
[illegible]
RECORD PLANS—GEORGE ADAIR.
CONTRACT—[illegible]
PRINTED—SEPTEMBER [illegible]
COMPLETED—FEBRUARY [illegible]
ACCEPTED—FEBRUARY [illegible]

RIGHT-OF-WAY AND
CONSTRUCTION PLANS

THESE PLANS ARE SUBJECT TO SUCH REVISIONS AS MAY BE REQUIRED BY THE BUREAU OF PUBLIC ROADS OR THE COMMISSIONER OF HIGHWAYS

CONSTRUCTION IS TO BE CARRIED OUT IN ACCORDANCE WITH THE PLANS AND THE STANDARD SPECIFICATIONS FOR HIGHWAY AND BRIDGE CONSTRUCTION [illegible]

DEPARTMENT OF COMMERCE
BUREAU OF PUBLIC ROADS

MP 0.00-4.41

MAY 22, 1963

I 89-1(3)
1