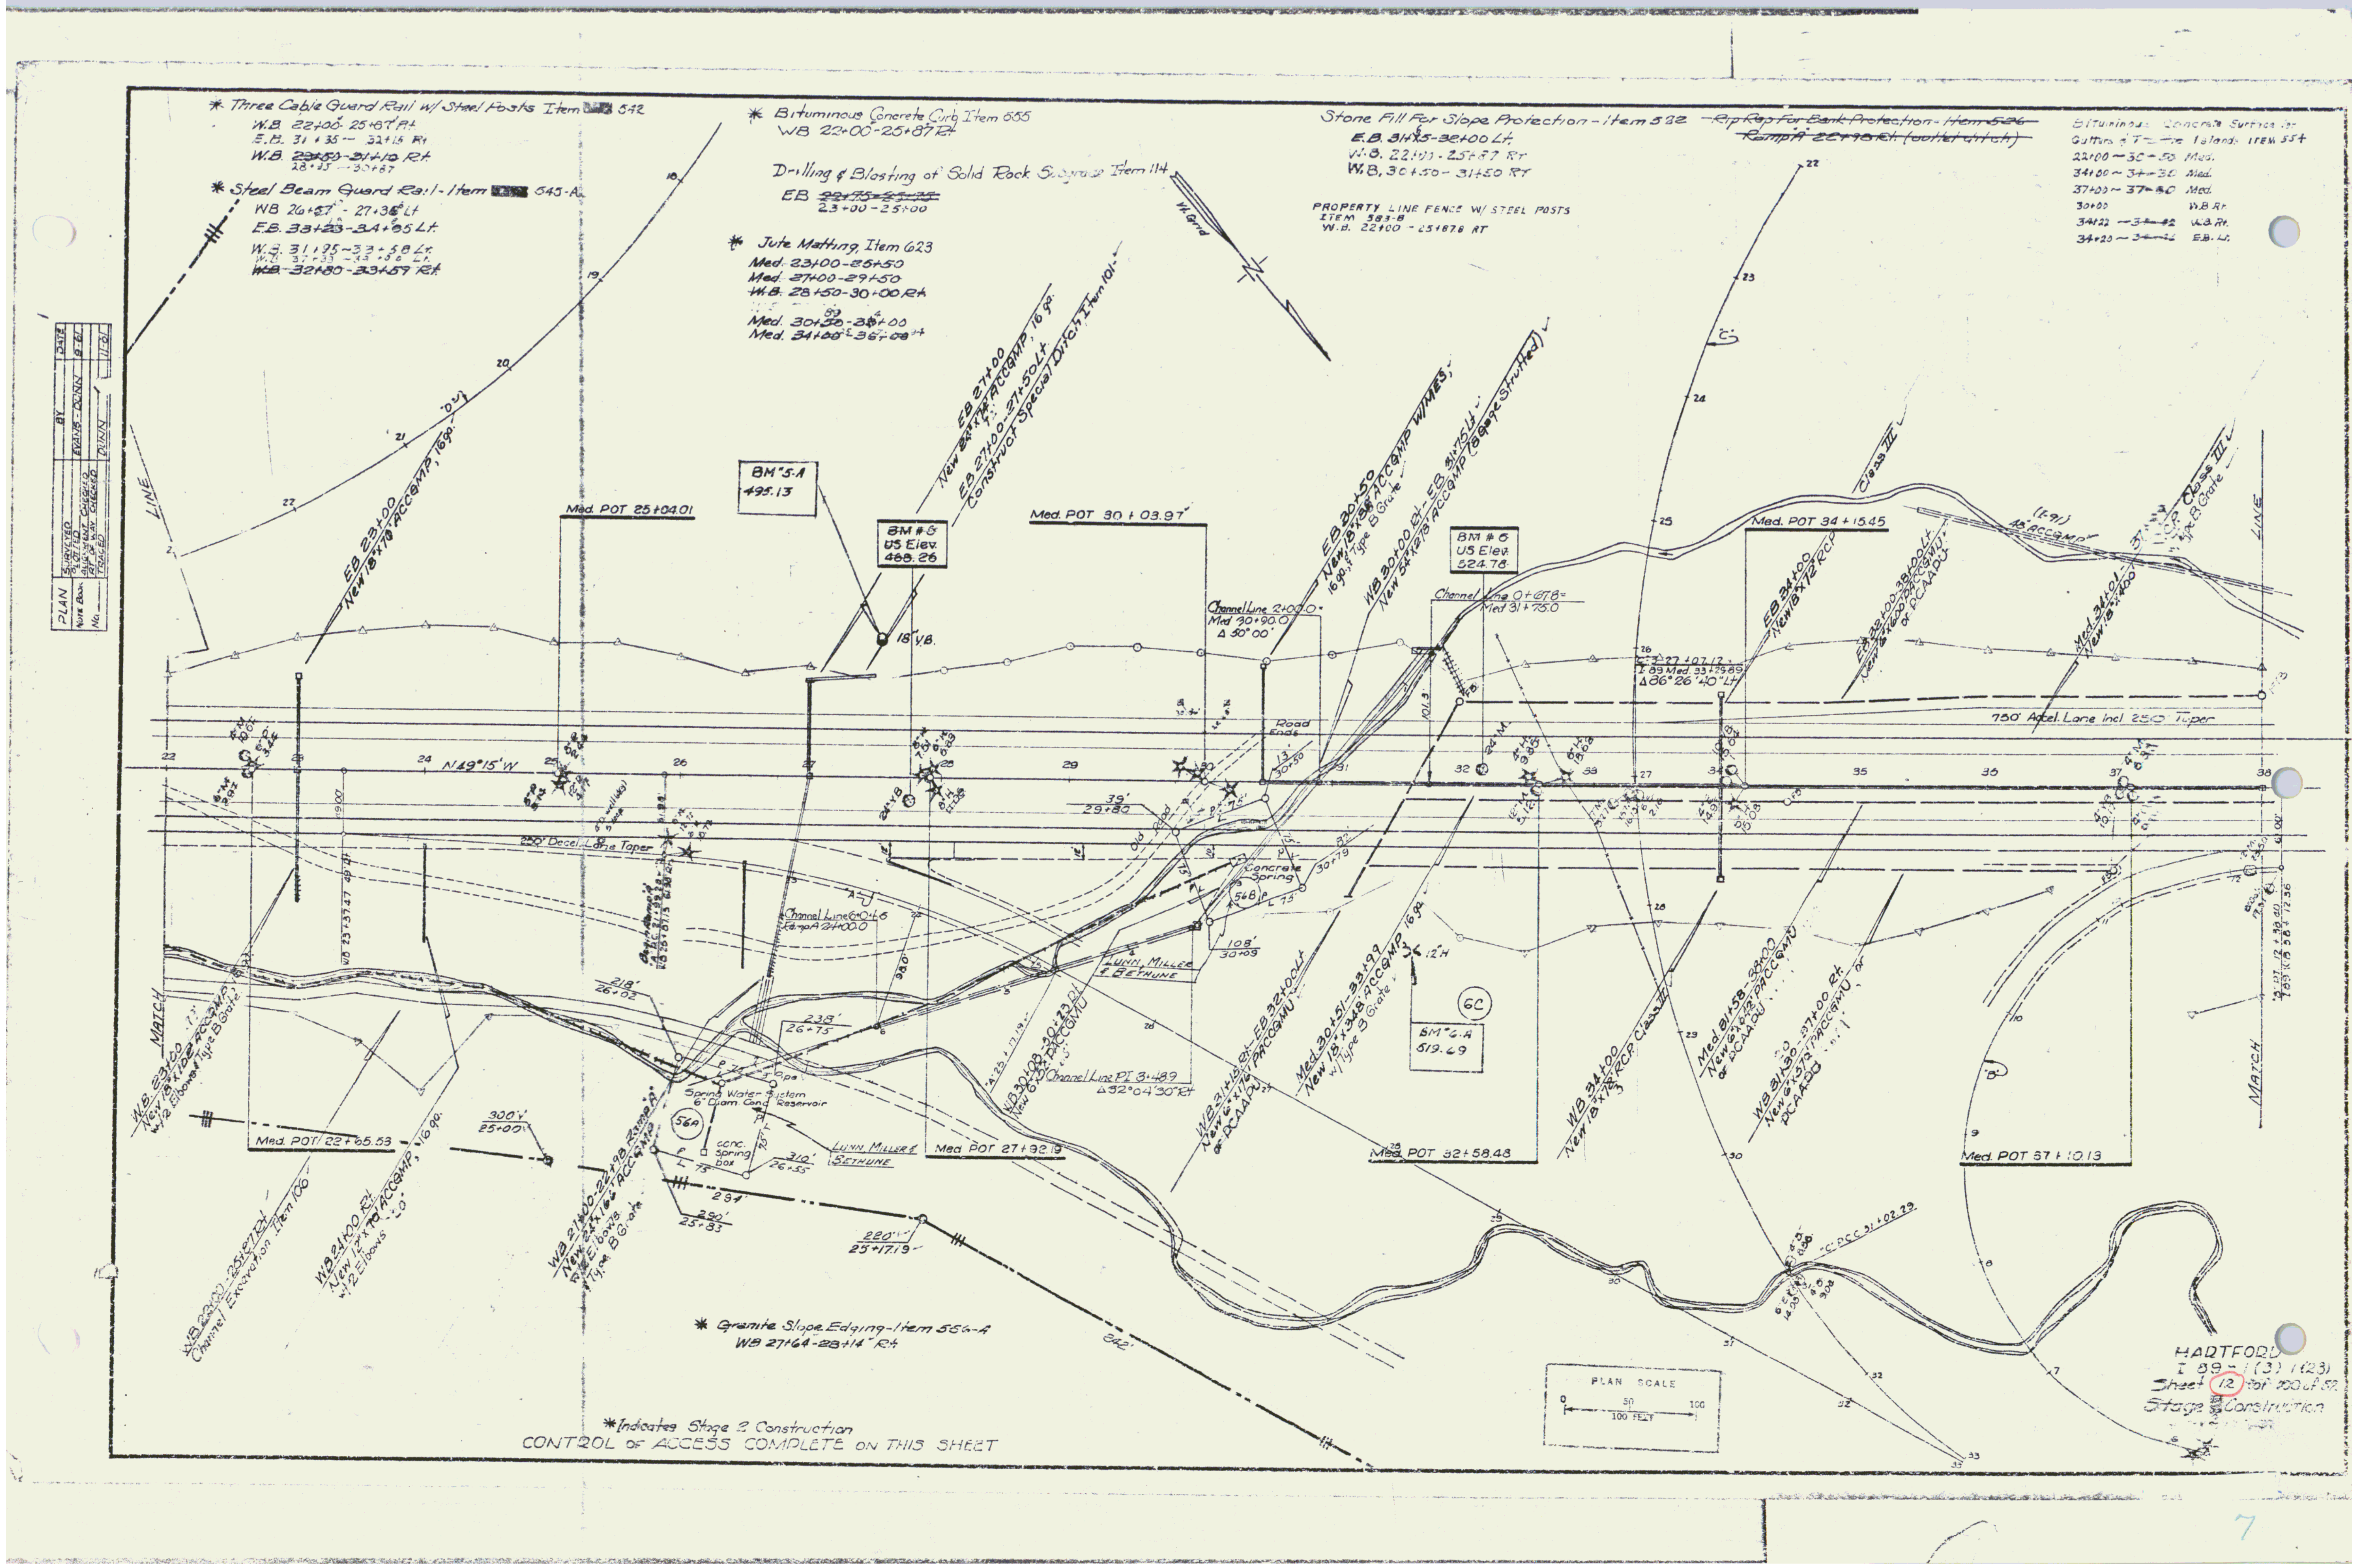

* Three Cable Guard Rail w/ Steel Posts Item 542
W.B. 22+00 - 25+87 Rt.
E.B. 31+35 — 32+15 Rt.
W.B. ~~23+50 - 31+10~~ Rt.
28+35 — 30+67
* Steel Beam Guard Rail - Item 545-A
WB 26+57 - 27+36 Lt.
E.B. 33+23 - 34+65 Lt.
W.B. 31+95 ~ 33+58 Lt.
~~W.B. 32+80 - 33+59 Rt.~~
* Bituminous Concrete Curb Item 655
WB 22+00 - 25+87 Rt.
Drilling & Blasting of Solid Rock Subgrade Item 114
EB 23+00 - 25+00
* Jute Matting, Item 623
Med. 23+00 - 25+50
Med. 27+00 - 29+50
~~W.B. 28+50 - 30+00 Rt.~~
Med. 30+50 - 33+00
Med. 34+00 - 36+00
Stone Fill For Slope Protection - Item 522
E.B. 31+15 - 32+00 Lt.
W.B. 22+00 - 25+87 Rt.
W.B. 30+50 - 31+50 Rt.
~~Rip Rap For Bank Protection - Item 526~~
~~Ramp A 22+18 Rt. (outlet ditch)~~
PROPERTY LINE FENCE W/ STEEL POSTS
ITEM 583-B
W.B. 22+00 - 25+87.8 RT
Bituminous Concrete Surface for Gutters & Traffic Islands ITEM 554
22+00 ~ 30+50 Med.
34+00 ~ 34+30 Med.
37+00 ~ 37+50 Med.
30+00 W.B Rt.
34+22 W.B. Rt.
34+20 E.B. Lt.
PLAN
SURVEYED
PLOTTED
ALIGNMENT CHECKED
RT. OF WAY CHECKED
TRACED
BY
EVANS - DUNN
DUNN
DATE
9-61
11-61
EB 23+00
New 18"x70' ACCGMP, 16 ga.
BM #5-A
495.13
BM #6
US Elev.
488.26
18" V.B.
EB 27+00
New 24"x74' ACCGMP, 16 ga.
EB 27+00 - 27+50 Lt.
Construct Special Ditch Item 101
Med. POT 25+04.01
Med. POT 30+03.97
Channel Line 2+00.0
Med 30+90.0
Δ 50° 00'
EB 30+50
New 18"x86' ACCGMP W/MES
16 ga. & Type B Grate
WB 30+00 Rt. - EB 31+75 Lt.
New 54"x278' ACCGMP (8 gage Strutted)
BM #6
US Elev.
524.78
Channel Line 0+67.8 = Med 31+75.0
101.3'
Road Ends
13'
30+50
Med. POT 34+15.45
27+07.12
I 89 Med. 33+29.89
Δ 86° 26' 40" Lt.
EB 34+00
New 18"x72' RCP
EB 32+00 - 38+00 Lt.
New 6"x600' PACCGMU or PCAAPU
Class III
(I-91)
48" ACCGMP
Med. 34+01
New 18"x400'
RCP Class III
Type B Grate
LINE
750' Accel. Lane Incl 250' Taper
N 49° 15' W
250' Decel. Lane Taper
WB 23+37.47 49 Lt.
39'
29+80
Old Road
Concrete Spring
30+79
56B
108'
30+09
Lunn, Miller & Bethune
Channel Line 6+04.6
Ramp A 24+00.0
238'
26+75
218'
26+02
Spring Water System
6" Diam. Conc. Reservoir
56A
conc. Spring box
310'
26+55
Lunn, Miller & Bethune
294'
290'
25+83
220'
25+17.19
300'
25+00
Med. POT 22+65.53
Med POT 27+92.19
WB 30+08 - 30+23 Rt.
New 6"x15' PACCGMU
Channel Line PI 3+48.9
Δ 32° 04' 30" Rt.
WB 31+15 Rt. - EB 32+00 Lt.
New 6"x176' PACCGMU or PCAAPU
Med. 30+51 - 33+99
New 18"x348' ACCGMP 16 ga.
w/ Type B Grate
12" H
6C
BM #6-A
519.69
Med. POT 32+58.48
WB 34+00
New 18"x172' RCP Class III
Med. 31+58 - 38+00
New 6"x642' PACCGMU or PCAAPU
WB 31+30 - 37+00 Rt.
New 6"x570' PACCGMU or PCAAPU
Med. POT 37+10.13
"C" PCC 31+02.29
MATCH
MATCH
W.B. 23+00
New 18"x102' ACCGMP
w/2 Elbows Type B Grate
WB 22+00 - 25+87 Rt.
Channel Excavation Item 106
WB 24+00 Rt.
New 12"x70' ACCGMP, 16 ga.
w/2 Elbows
WB 21+00 - 22+98 Ramp "A"
New 24"x166' ACCGMP
w/2 Elbows
Type B Grate
* Granite Slope Edging - Item 556-A
WB 27+64 - 28+14 Rt.
842'
PLAN SCALE
0 50 100
100 FEET
*Indicates Stage 2 Construction
CONTROL OF ACCESS COMPLETE ON THIS SHEET
HARTFORD
I 89 - 1 (3) 1 (23)
Sheet 12 of 52
Stage Construction
7