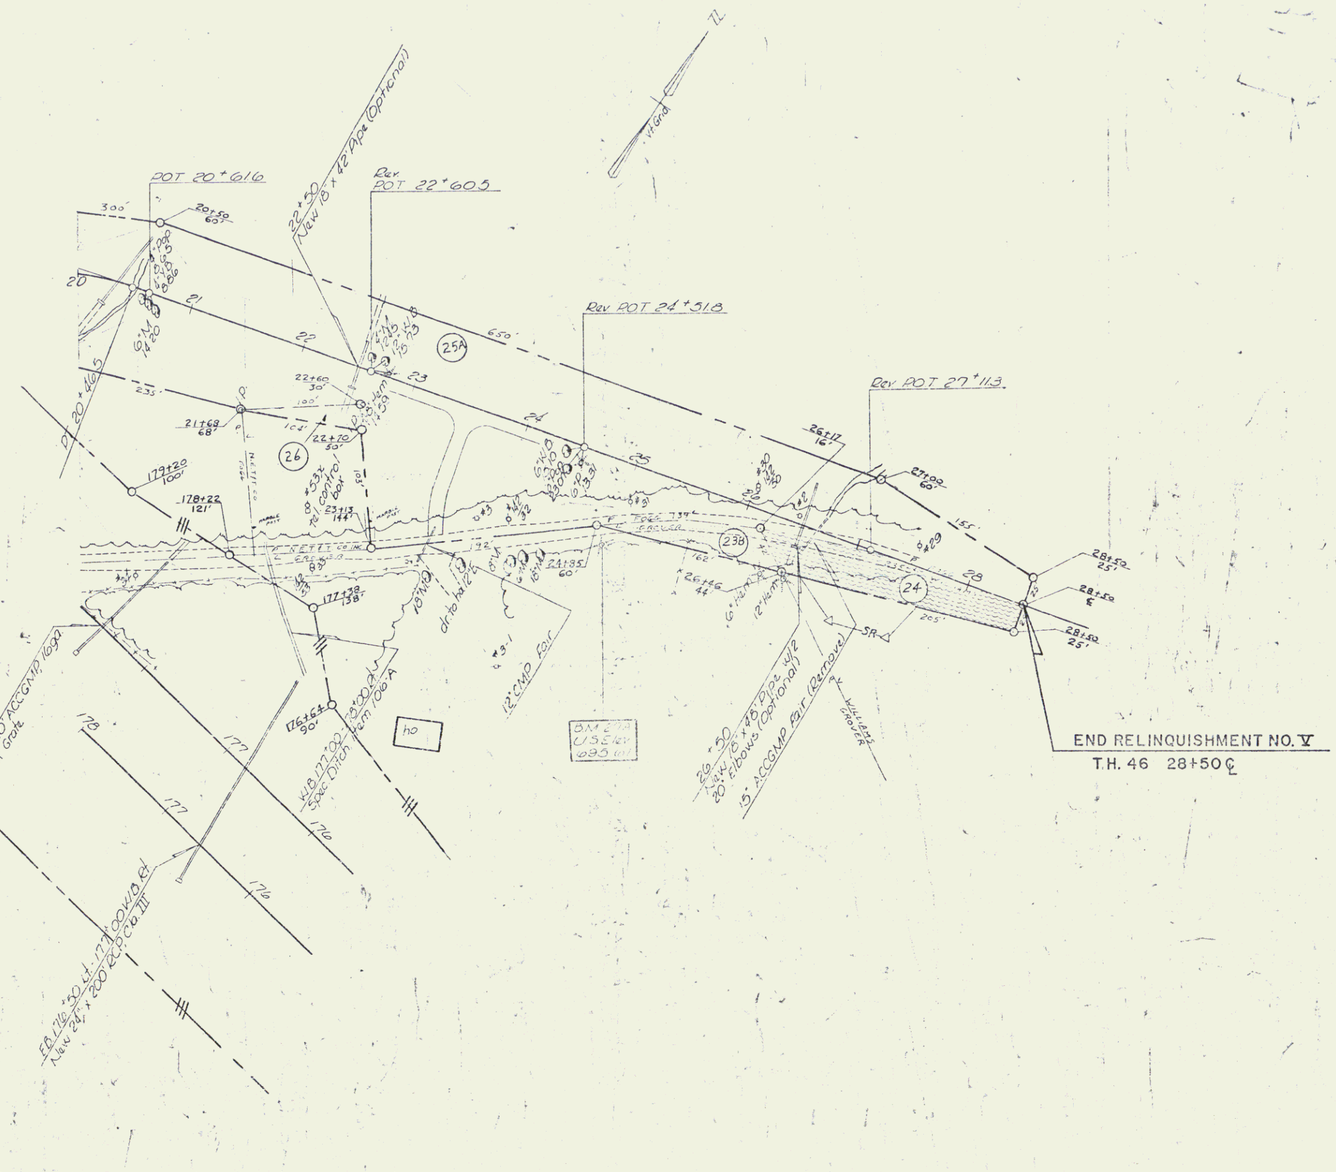
POT 20+616
Rev POT 22+605
Rev POT 24+518
Rev POT 27+113
END RELINQUISHMENT NO. V
T.H. 46 28+50 ℄
HARTFORD

35D

26