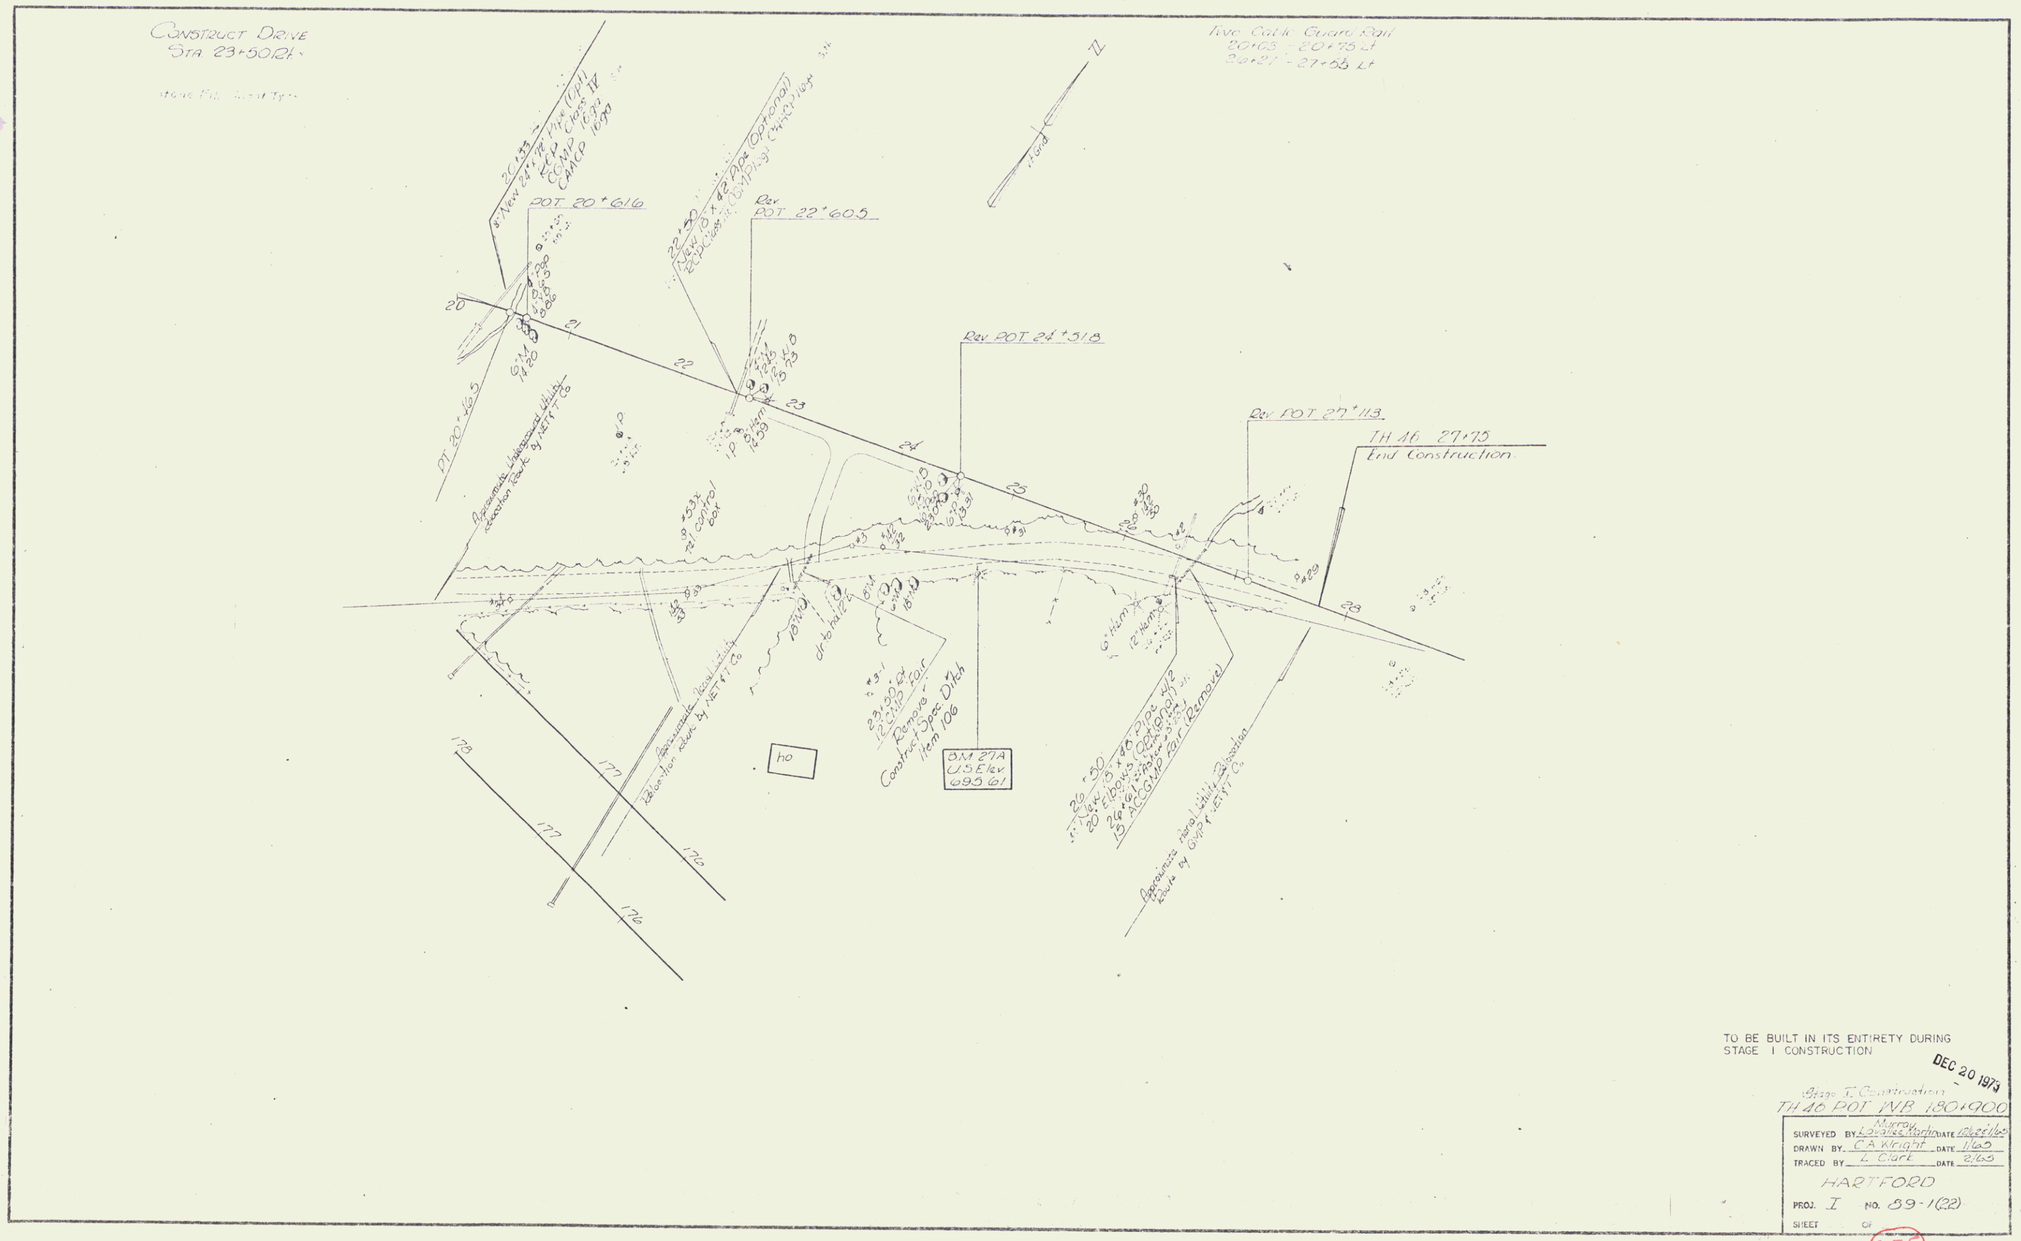
Construct Drive
Sta 23+50 Rt
Rev. Cable Guard Rail
20+03 - 20+75 Lt
26+37 - 27+55 Lt
POT 20+61.6
Rev. POT 22+60.5
Rev. POT 24+31.8
Rev. POT 27+11.3
TH 46 27+75
End Construction
DT 20+46.5
BM 27A
USElev
699.61
Construct Drive
Item 106
Remove Fair
Item 106
Remove Ditch
Item 106
TO BE BUILT IN ITS ENTIRETY DURING
STAGE I CONSTRUCTION
DEC 20 1973
Stage I Construction
TH 46 POT NR 180+900
SURVEYED BY Murray
DRAWN BY C.A. WRIGHT DATE 1/60
TRACED BY L. CLARK DATE 2/65
HARTFORD
PROJ. I NO. 89-1(22)
SHEET OF
35E

27