


PLAN
 SURVEYED BY
 DATE
 SCALE

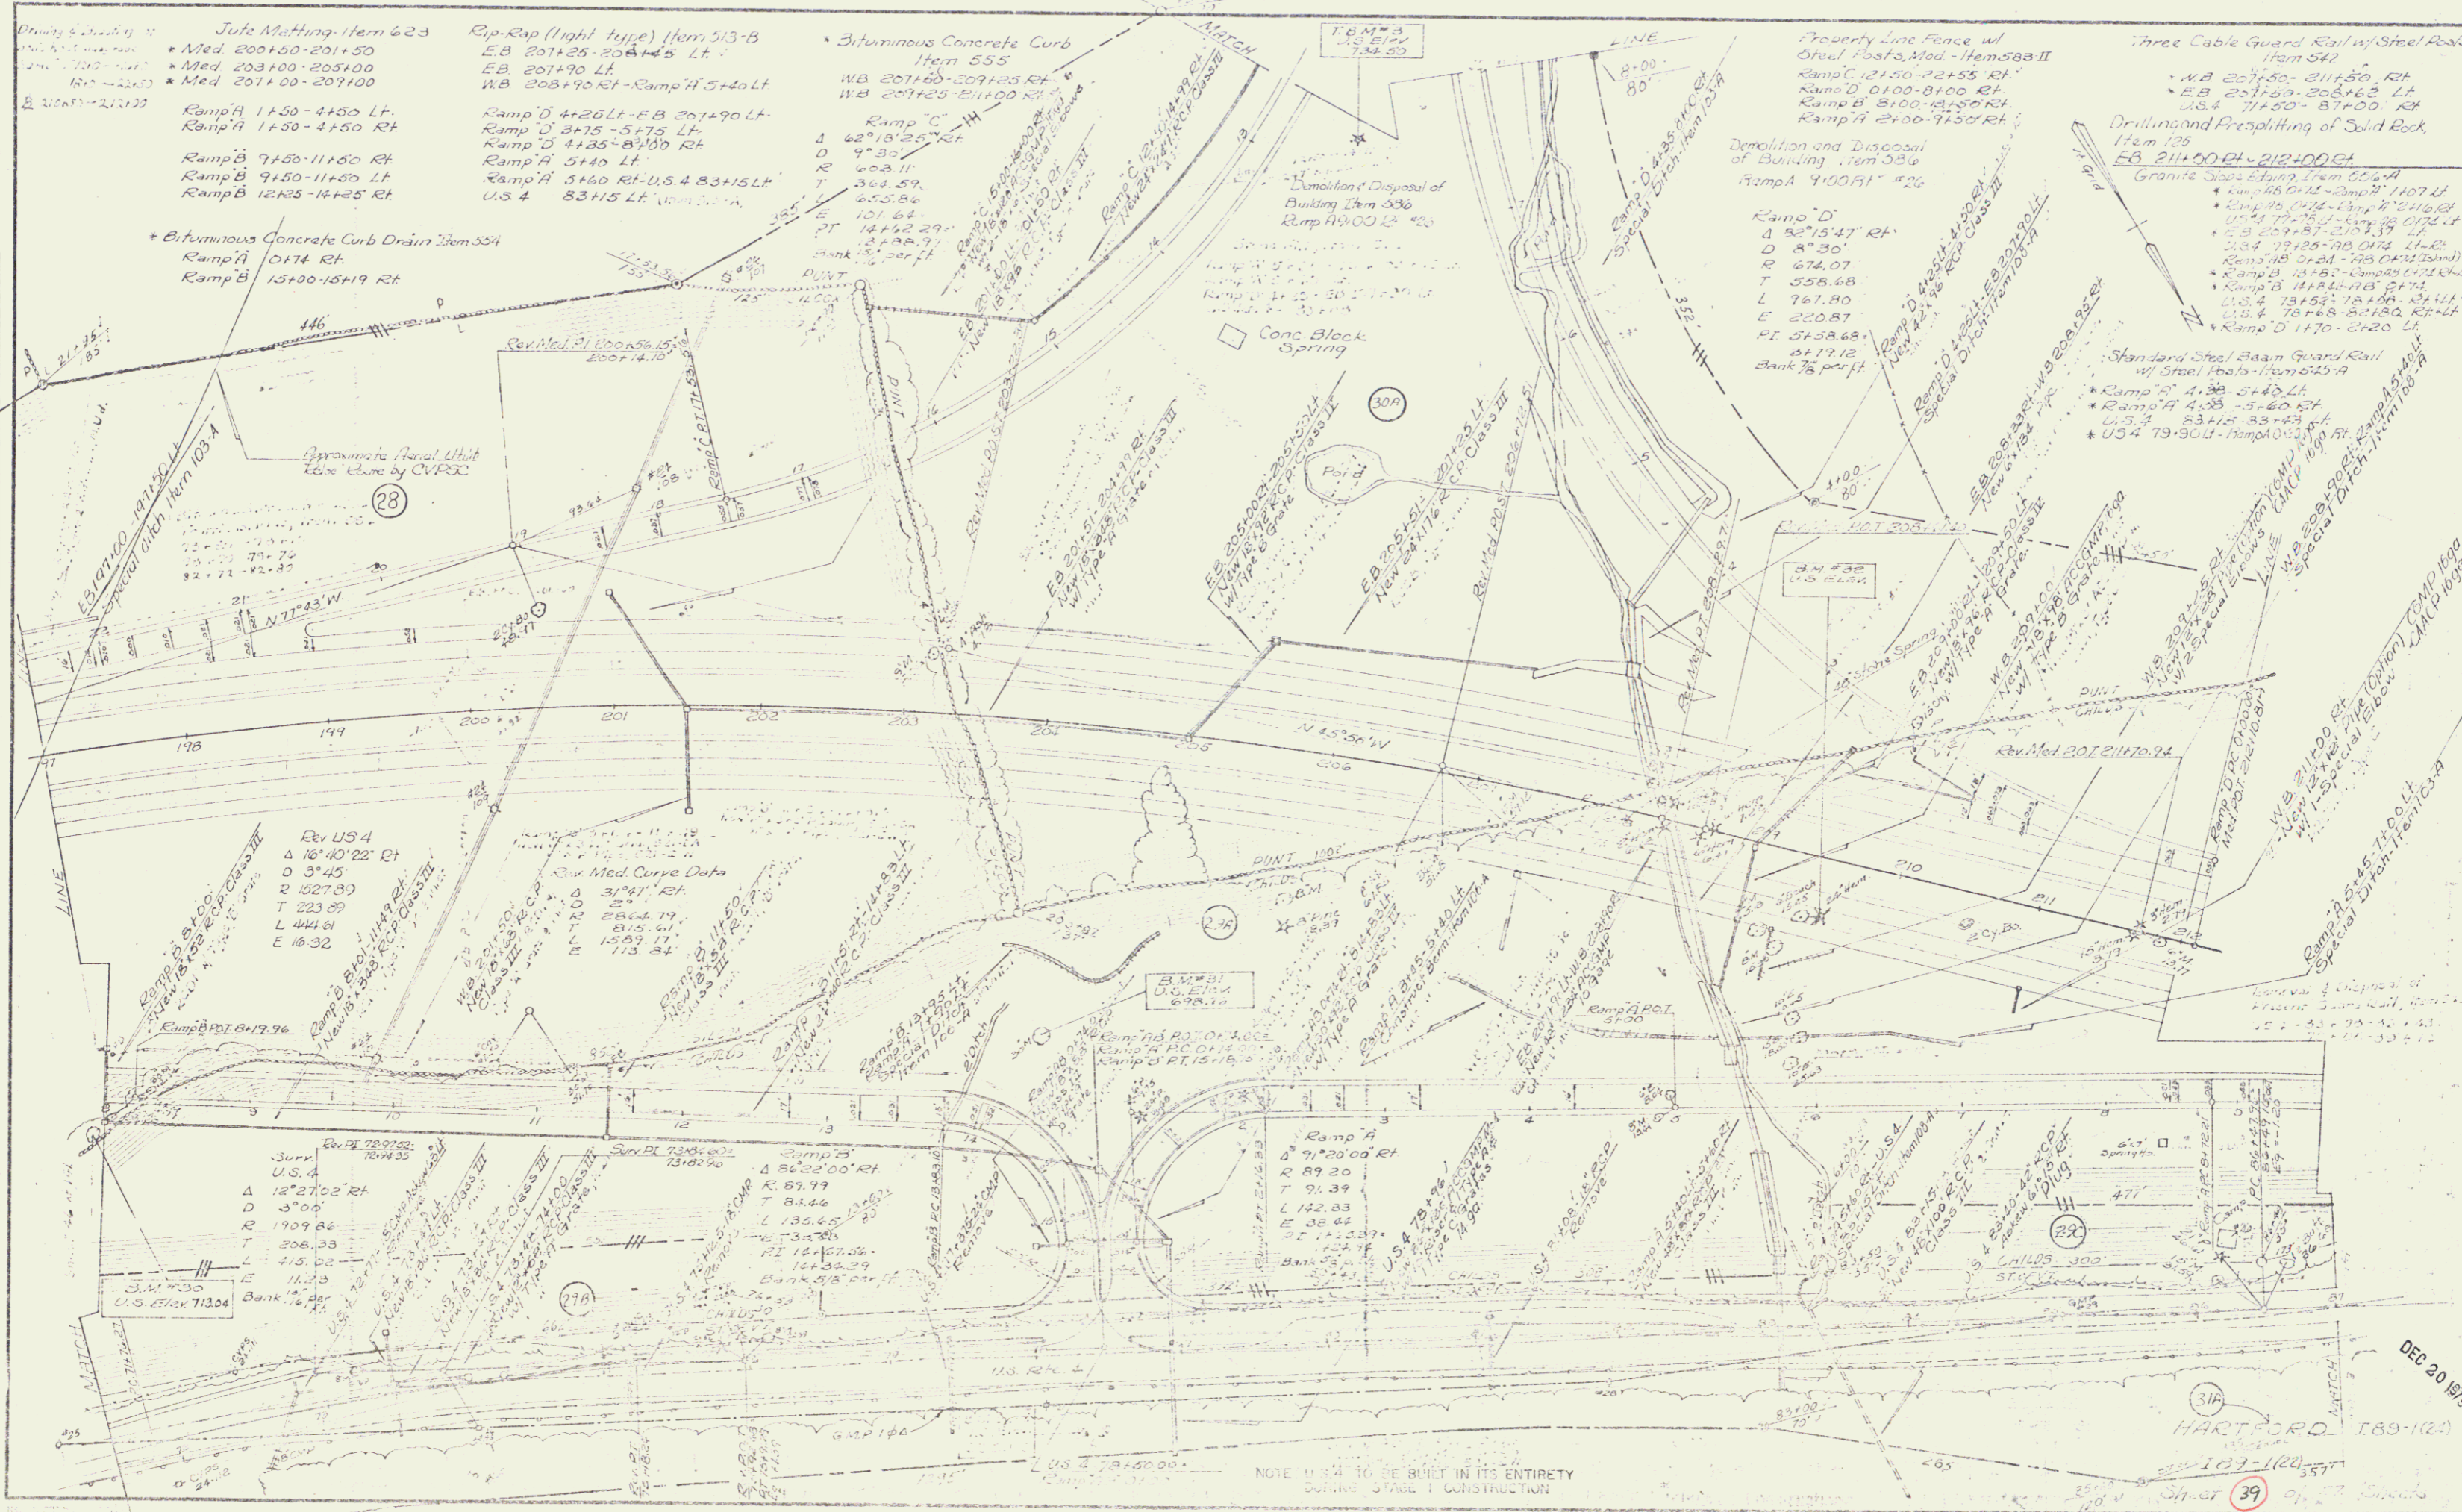

NOTE: THIS TO BE BUILT IN ITS ENTIRETY DURING STAGE I CONSTRUCTION