



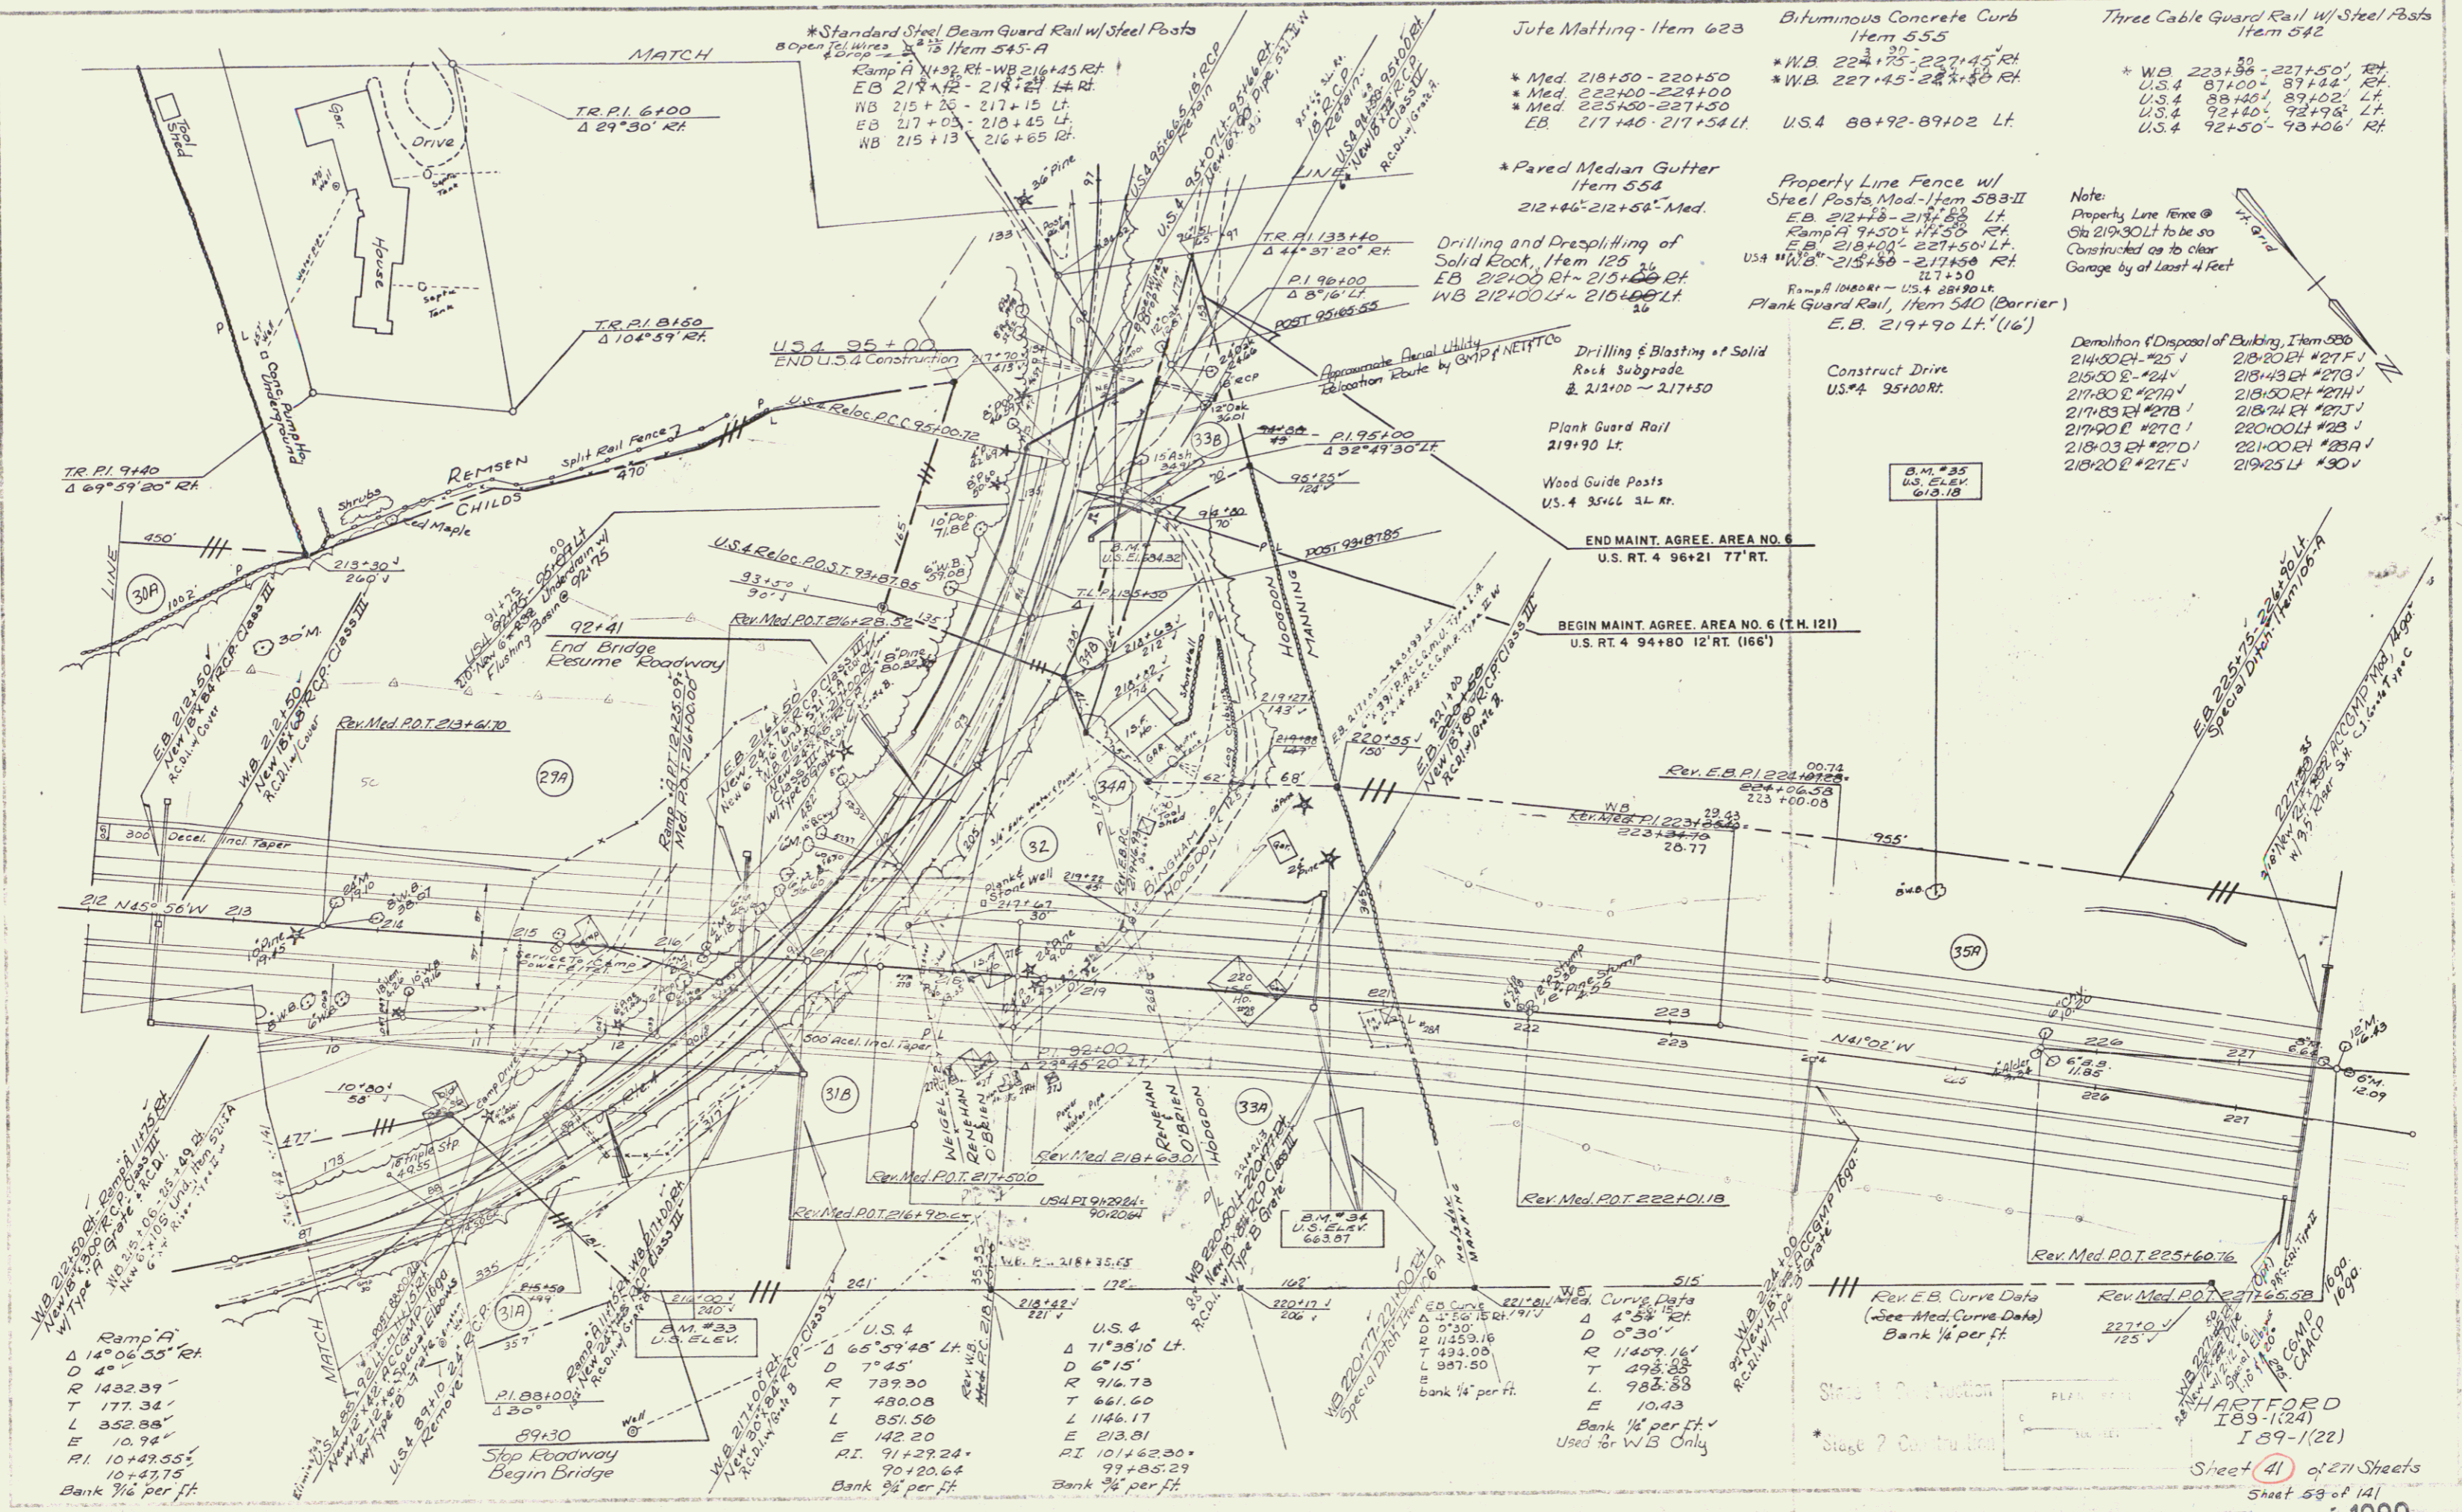

Ramp A
 $R 1432.39'$
 $T 177.34'$
 $L 352.88'$
 $E 10.94'$
 $PI 10+49.55'$
 $10+47.75'$
 Bank $1/2$ per ft

| | | | |
|-------------------|-------------------------------|-------------------|-------------------------------|

Rev. E.B. Curve Data
 (See Med. Curve Data)
 Bank $1/2$ per ft

Rev. Med. P.O.T. 227+66.58
 $227+10.4$
 $125'$

HARTFORD
 189-1(22)
 Sheet 41 of 27 Sheets
 Sheet 59 of 141

FEB 25 1980
 30