Bituminous Concrete Curb
Item 555 *
Northbound 362+00 to 363+00 Rt.

Three Cable Guard Rail w/Steel Posts
Item 542 *
Northbound 362+00 to 363+00 Rt.

Property Line Fence w/Steel Posts
Item 583-II
NB 362+00-362+75 Rt.
SB 362+00-363+00 Lt.

"CONTROL OF ACCESS IS COMPLETE ON THIS SHEET"

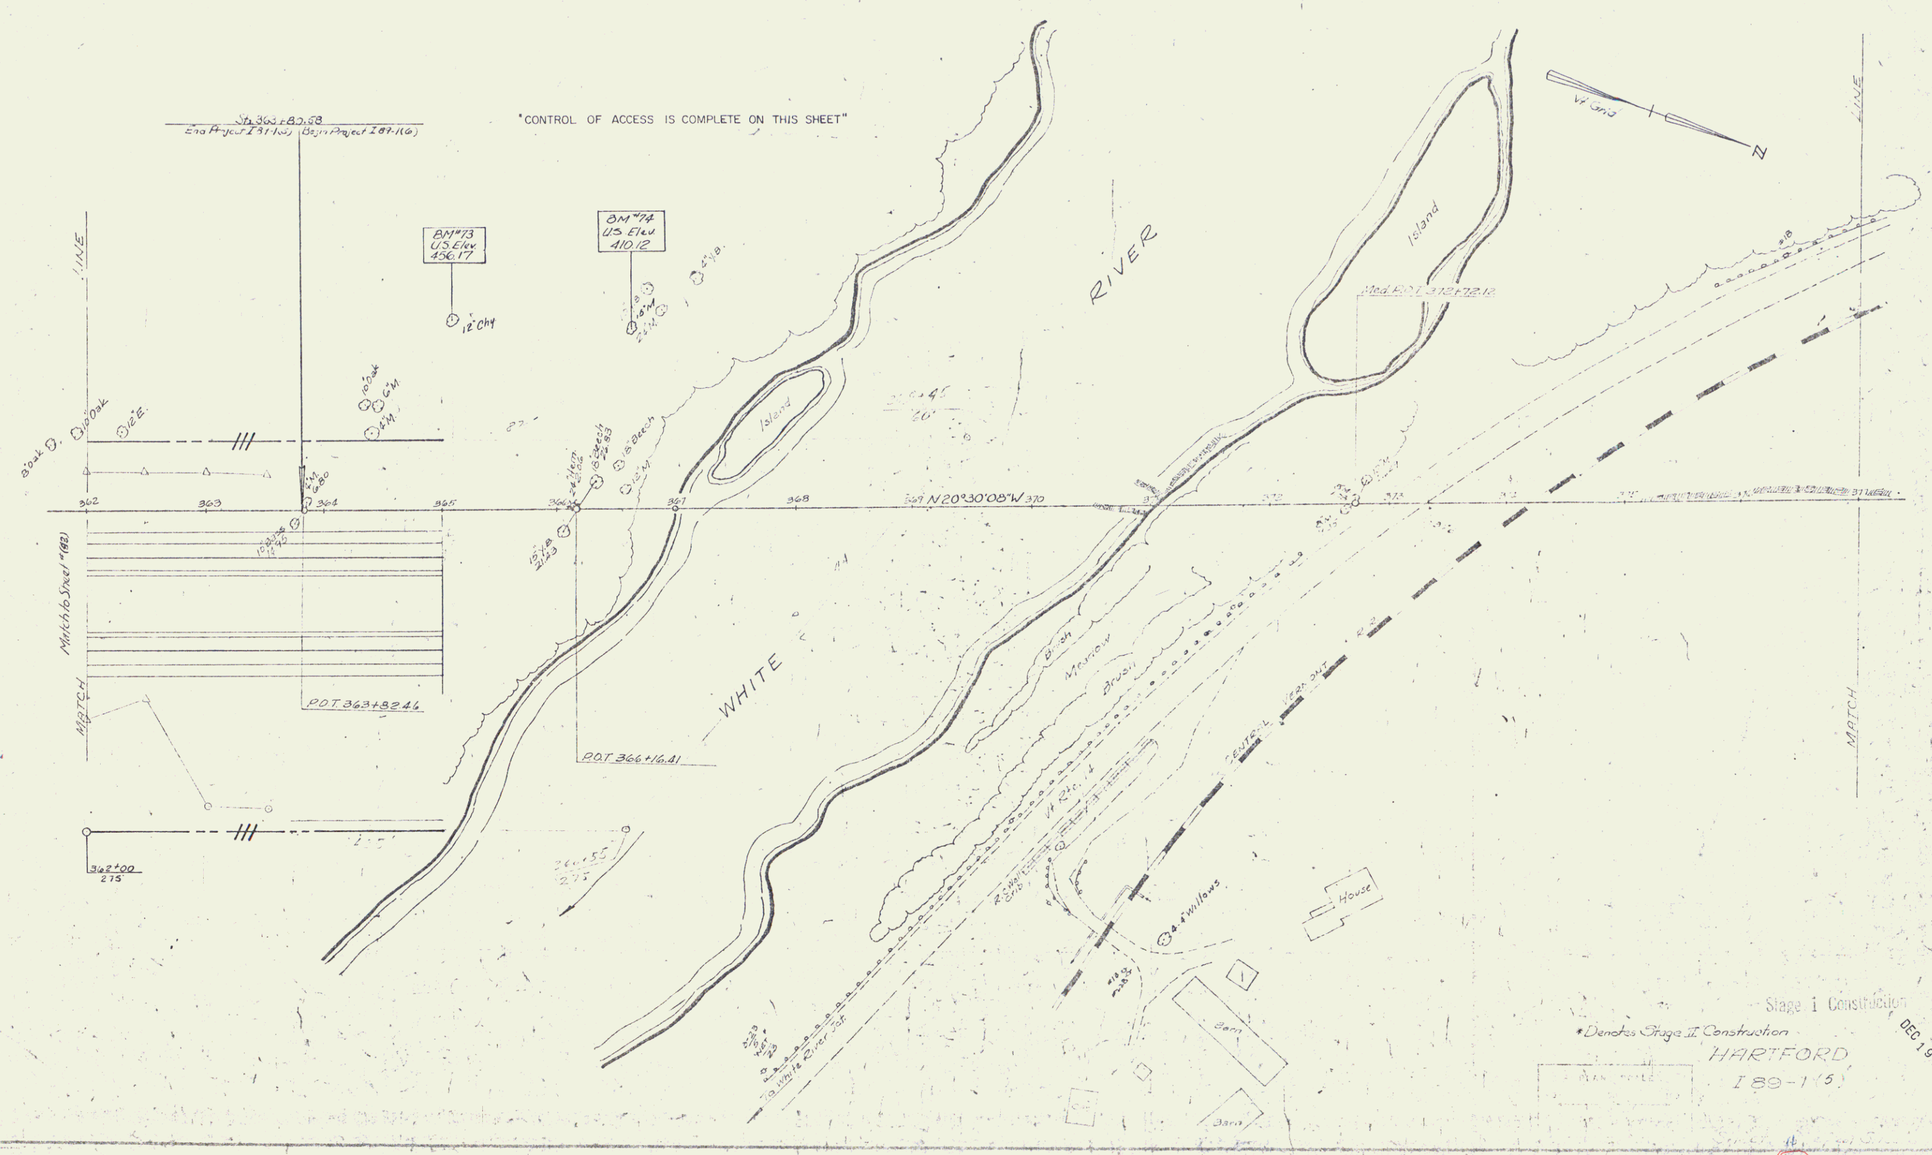


Stage 1 Construction
*Denotes Stage II Construction
HARTFORD
I 89-1(5)
DEC 19 1973

45

28