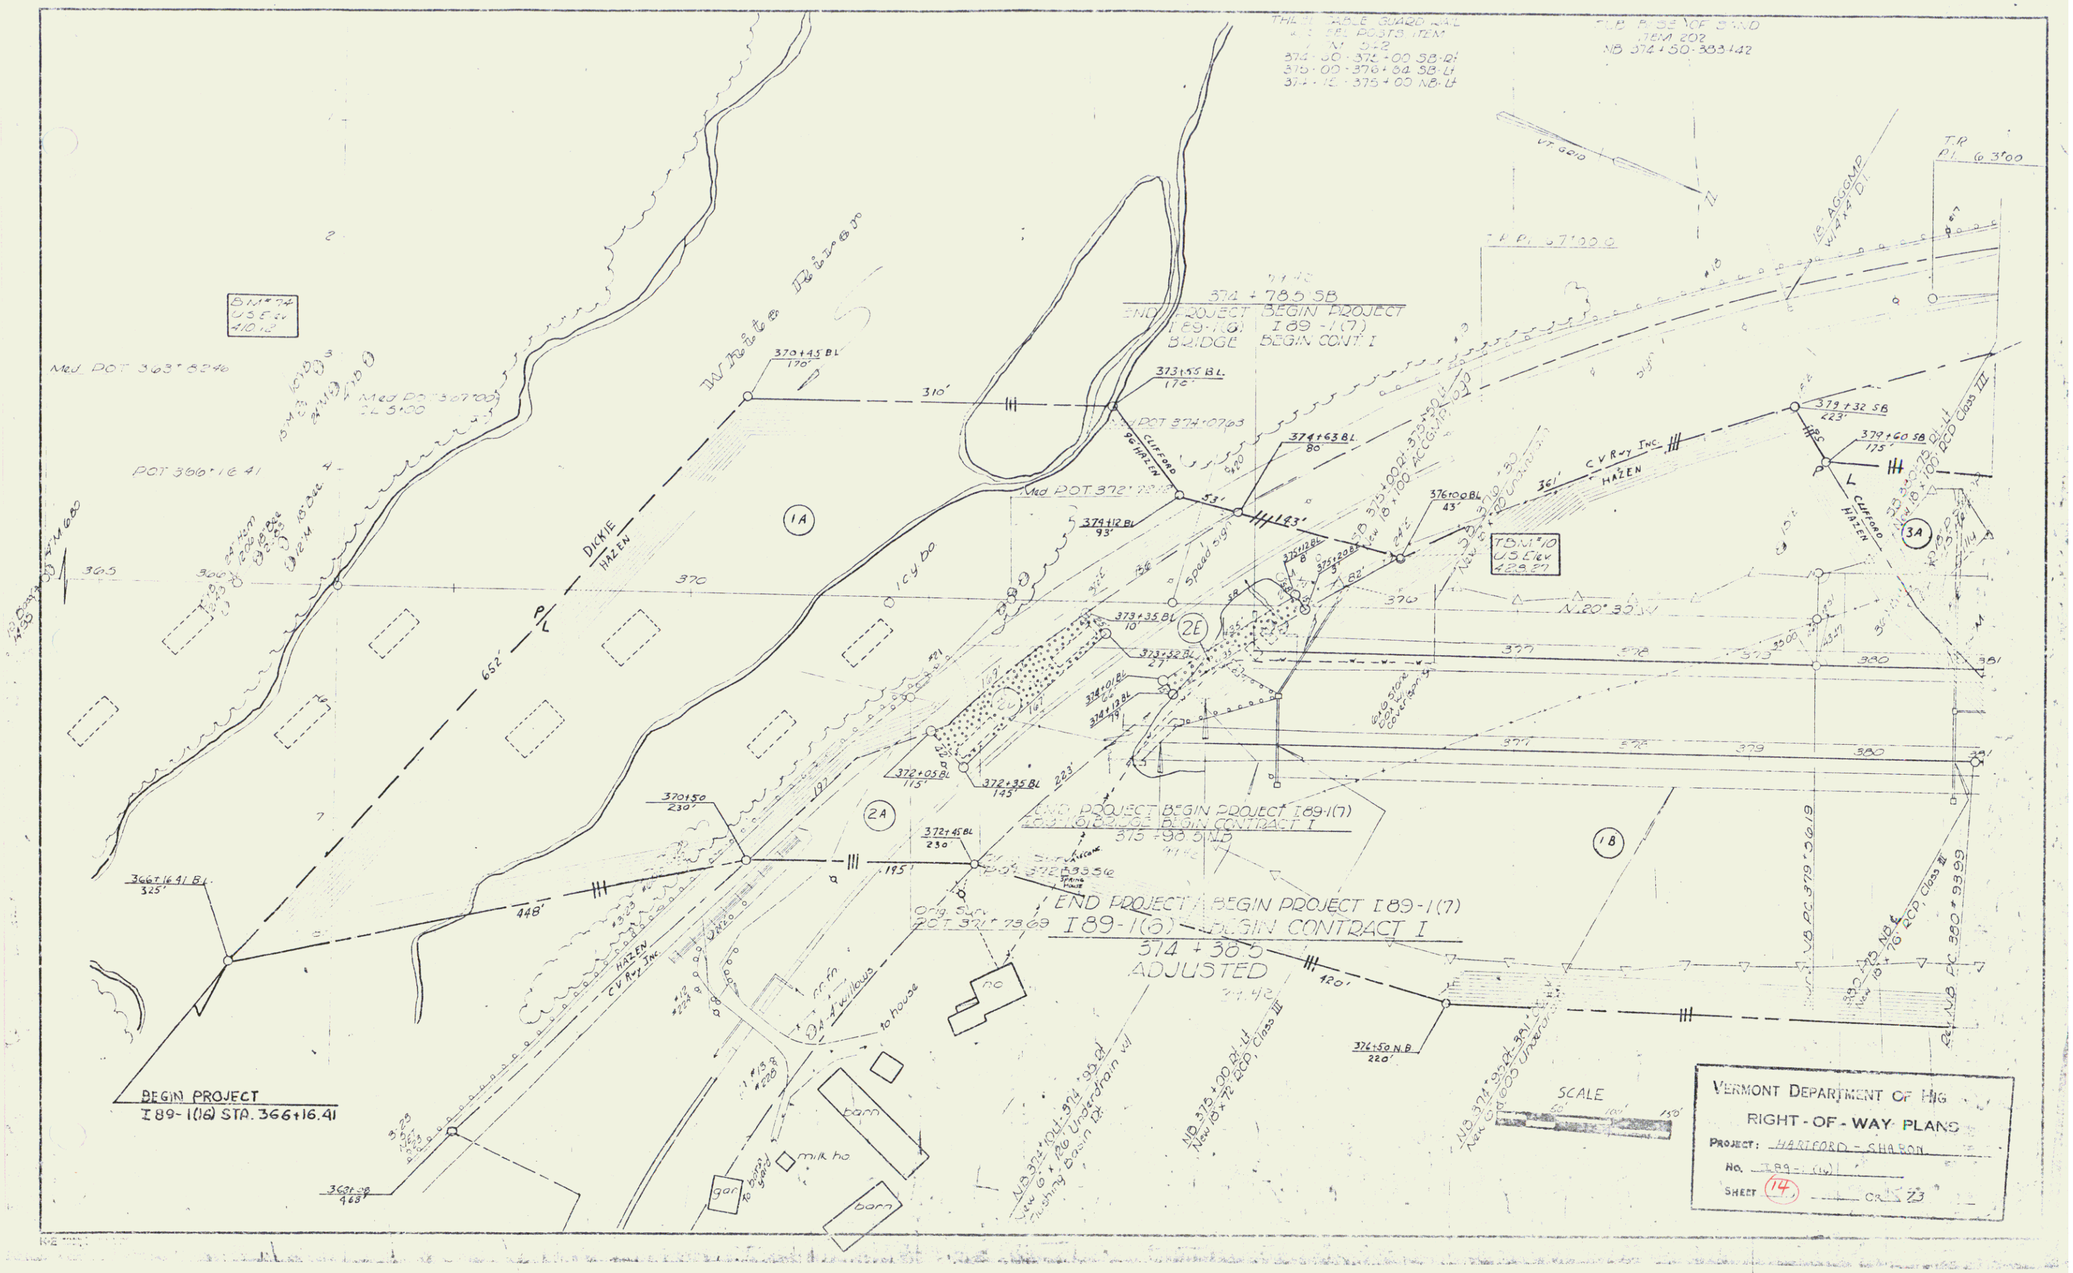
BEGIN PROJECT
I 89-1(16) STA. 366+16.41
END PROJECT BEGIN PROJECT I 89-1(7)
I 89-1(6) BEGIN CONTRACT I
374 + 38.5
ADJUSTED
374 + 78.5 SB
END PROJECT BEGIN PROJECT
I 89-1(6) I 89-1(7)
BRIDGE BEGIN CONT I
White River
DICKIE
HAZEN
CLIFFORD
HAZEN
C V R-y INC.
HAZEN
TBM #10
US Elev
428.27
BM #74
US Elev
410.12
1A
1B
2A
2E
3A
VERMONT DEPARTMENT OF HIGHWAYS
RIGHT-OF-WAY PLANS
PROJECT: HARTFORD - SHARON
NO. I 89-1 (16)
SHEET 14 OF 23
SCALE