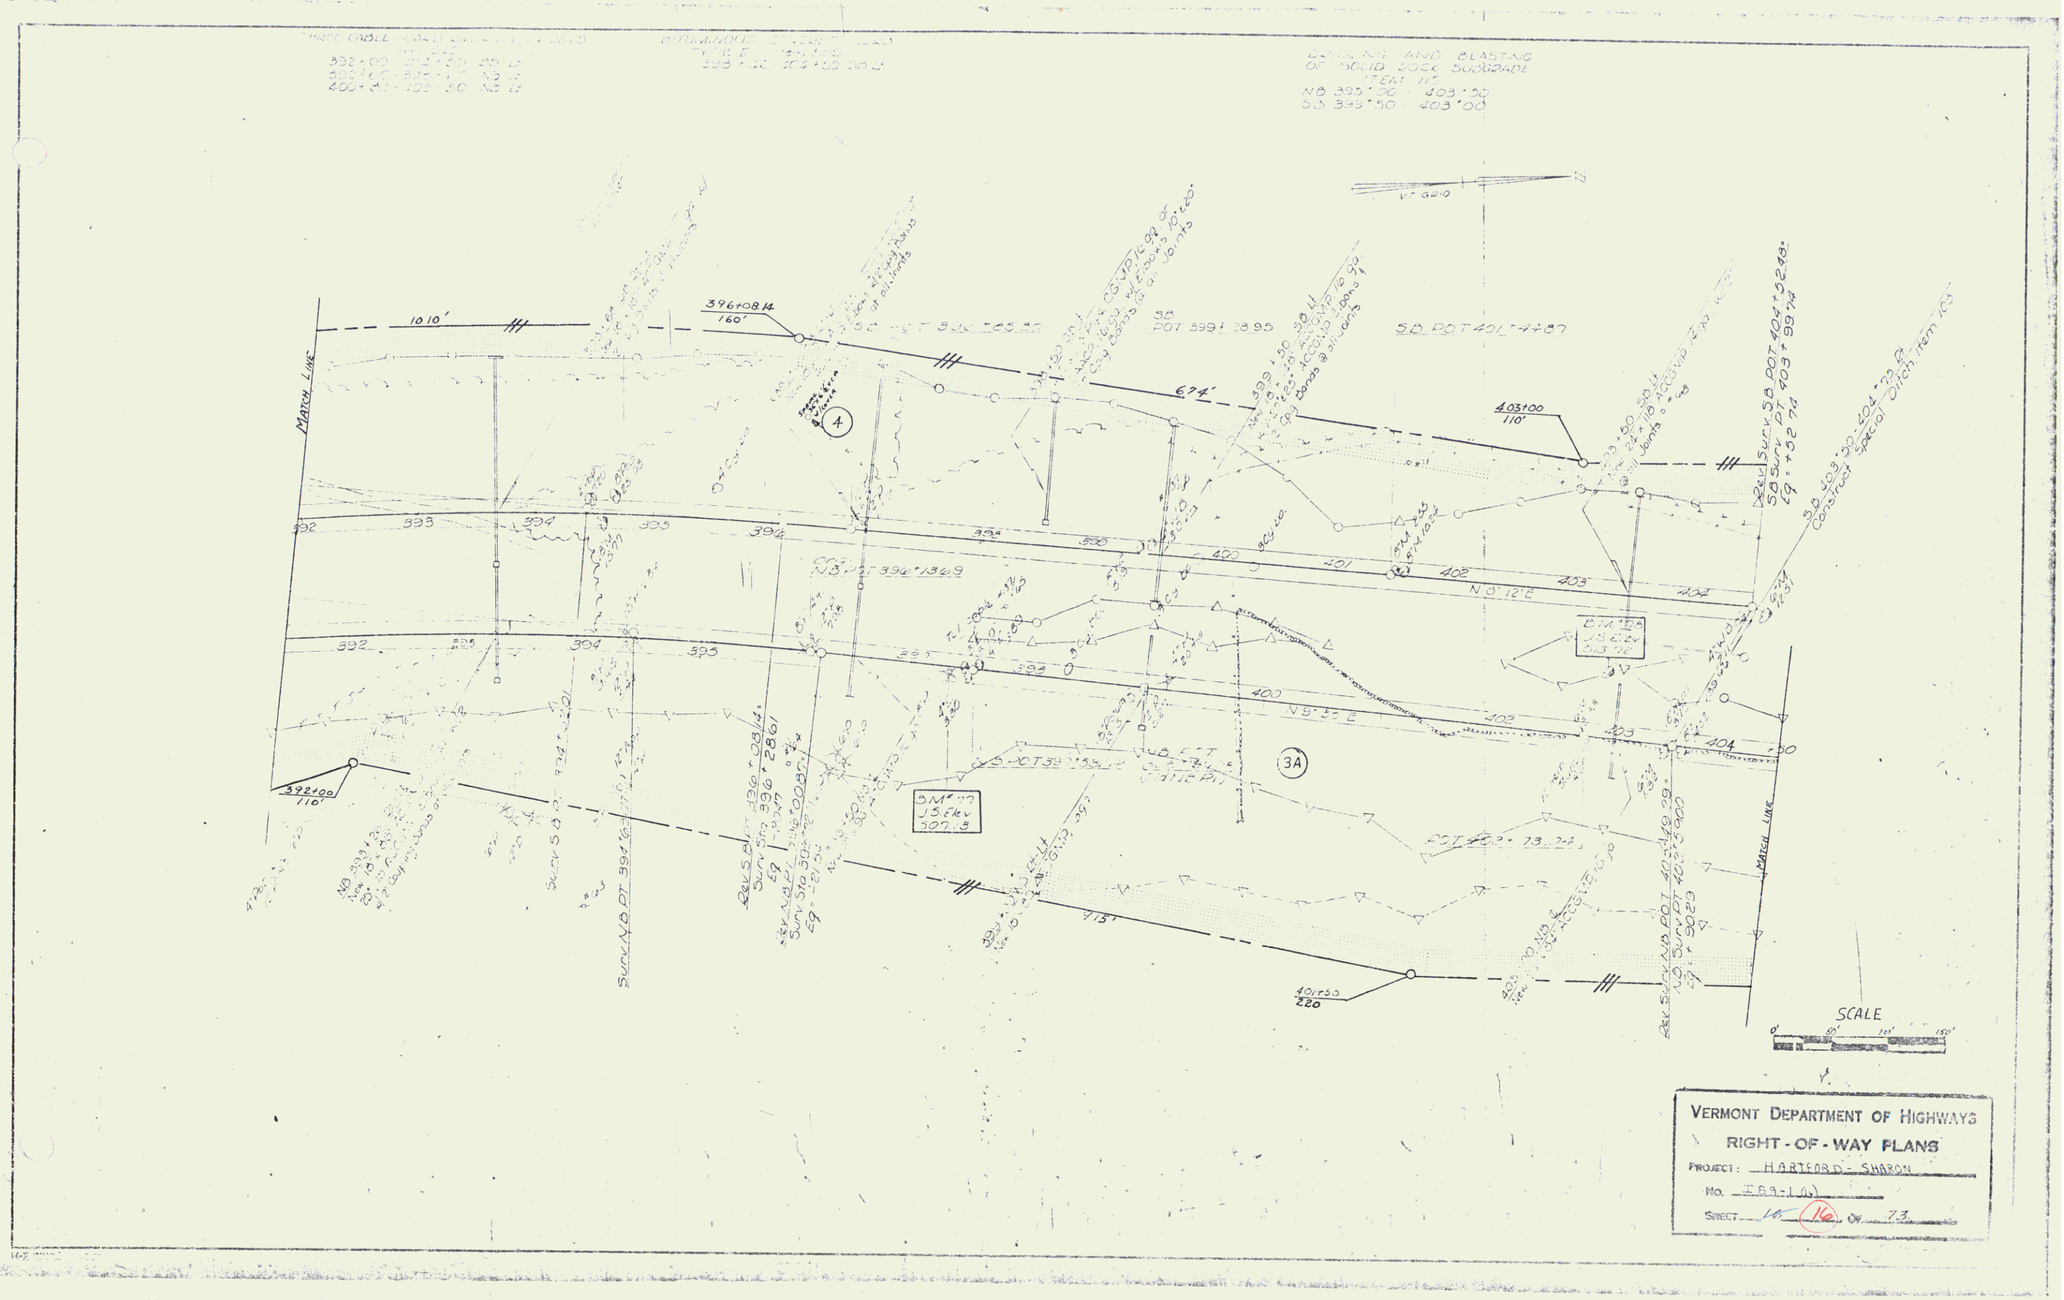
MATCH LINE
1010'
396+08.14
160'
674'
403+00
110'
392+00
110'
401+50
220
N 9° 12' E
N 9° 55' E
SCALE
0' 50' 100' 150'
VERMONT DEPARTMENT OF HIGHWAYS
RIGHT-OF-WAY PLANS
PROJECT: HARTFORD - SHARON
NO. F 89-1(4)
SHEET 15 (16) OF 73