THREE CABLE GUARD RAIL
W/STEEL POSTS, ITEM 542
NB
500 + 40 Lt - 504 + 56 Lt
507 + 40 Rt - 511 + 00 Rt
508 + 00 Lt - 511 + 00 Lt
SB
494 + 00 Lt - 495 + 60 Lt
497 + 40 Lt - 501 + 56 Lt
507 + 40 Rt - 510 + 00 Rt
507 + 40 Lt - 510 + 00 Lt

BITUMINOUS CONCRETE CURB
NB 508 + 25 - 511 + 00 Lt
SB 507 + 50 - 510 + 00 Lt

DRILLING & BLASTING of SOLID
ROCK SUBGRADE, ITEM 115
NB 495 + 00 - 500 + 25
NB 504 + 25 - 506 + 25
SB 503 + 50 - 506 + 00

JUTE MATTING, ITEM 623
SB 494 + 00 Rt - 499 + 25 Rt

CONSTRUCT DRIVE
NB 507 + 10 Rt

DRIVE GATE FOR PROPERTY
LINE FENCE Item 583-V
N.B 506 + 70 Rt

PROPERTY LINE FENCE w/STEEL
POSTS ITEM 583-II
N.B 504 + 64 Rt - N.B 506 + 64 Rt
N.B 506 + 76 Rt - N.B 508 + 76 Rt

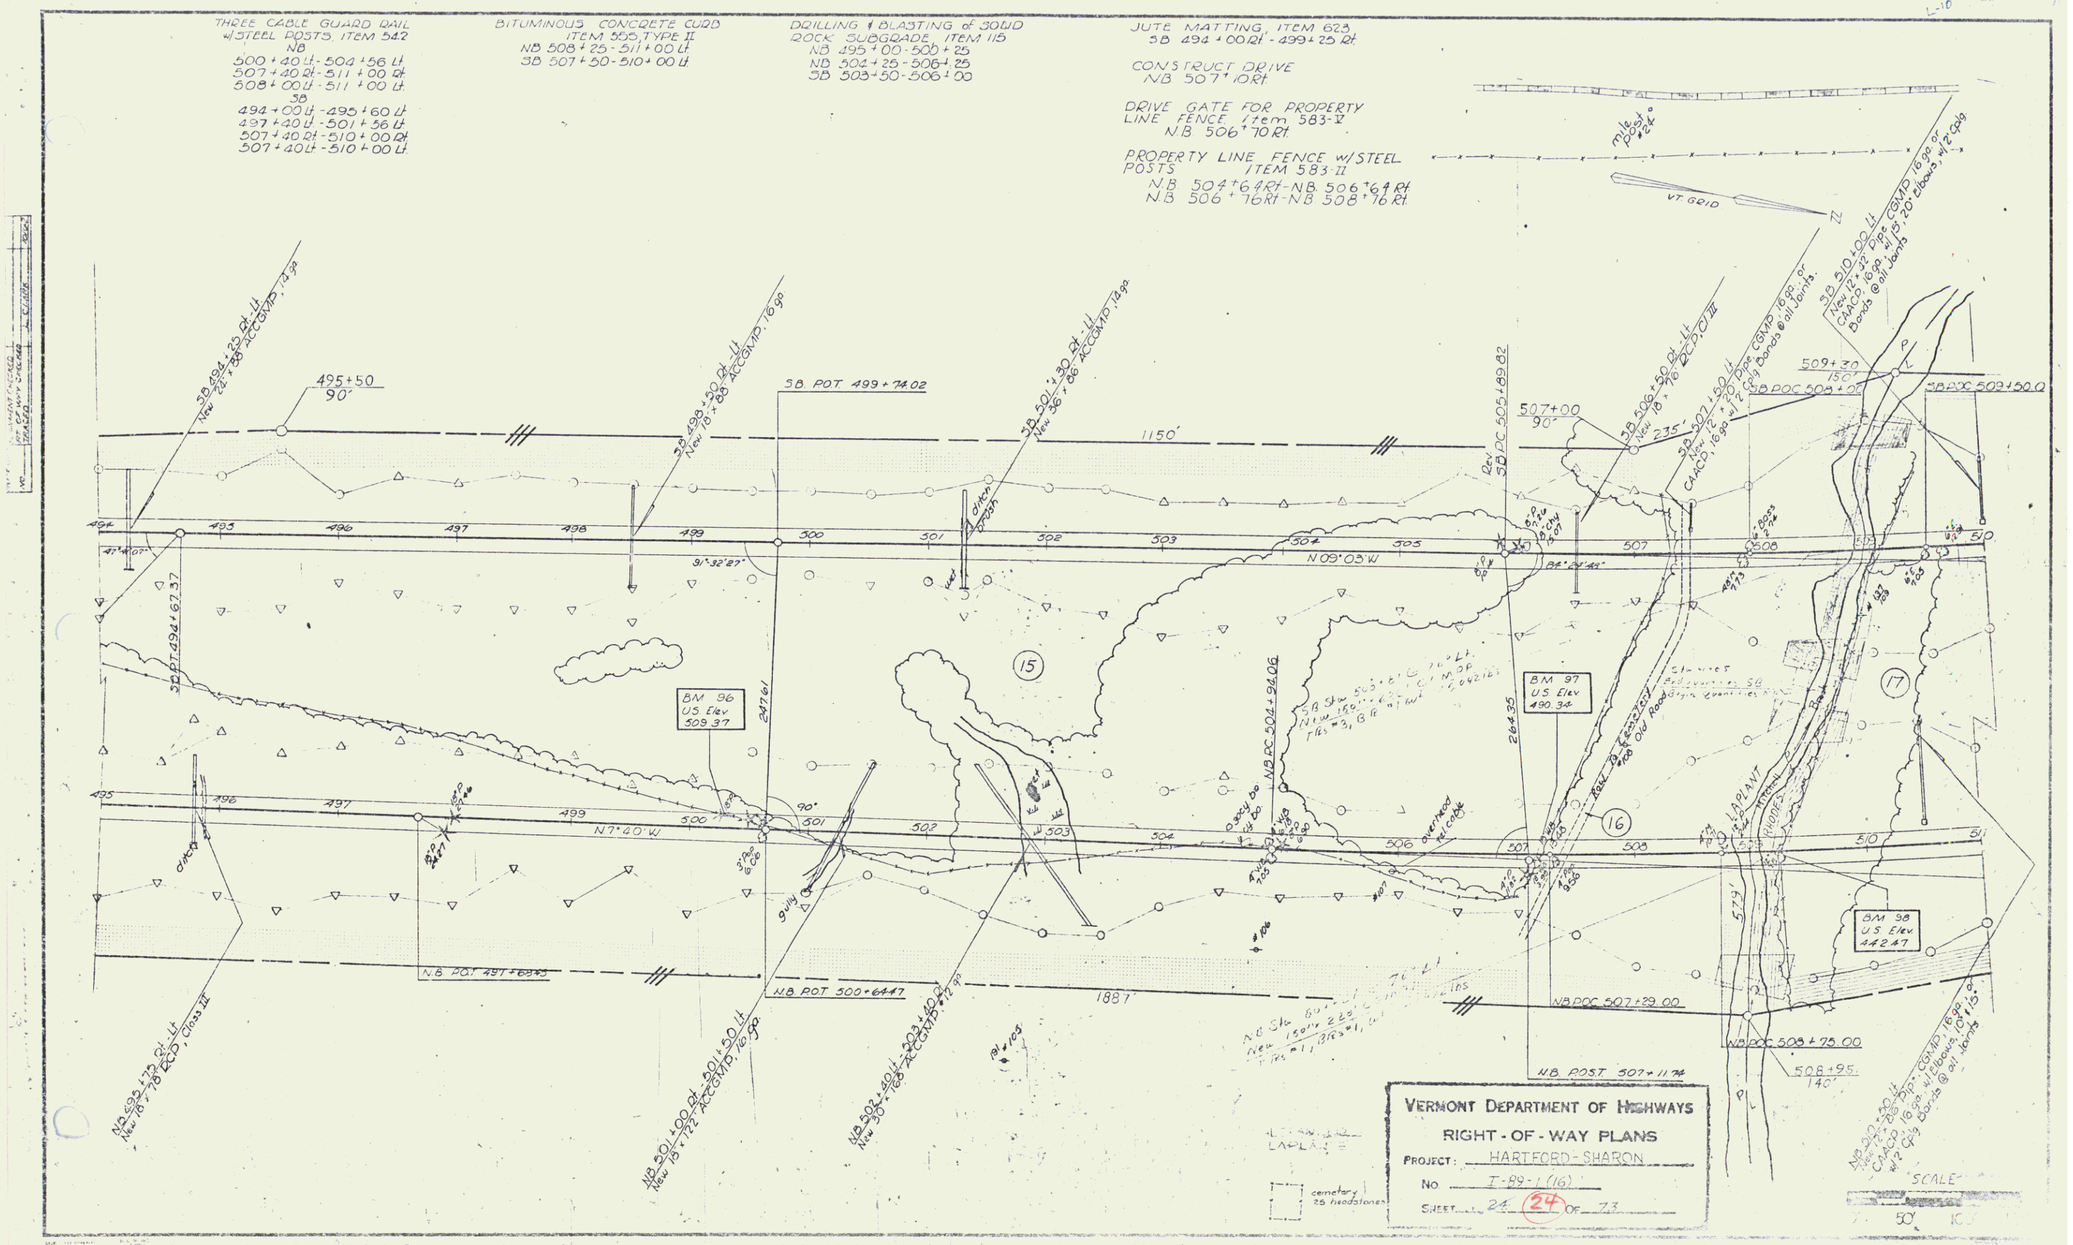

VERMONT DEPARTMENT OF HIGHWAYS
RIGHT - OF - WAY PLANS
PROJECT: HARTFORD - SHARON
No. T-89-1 (16)
SHEET 24 (24) OF 73