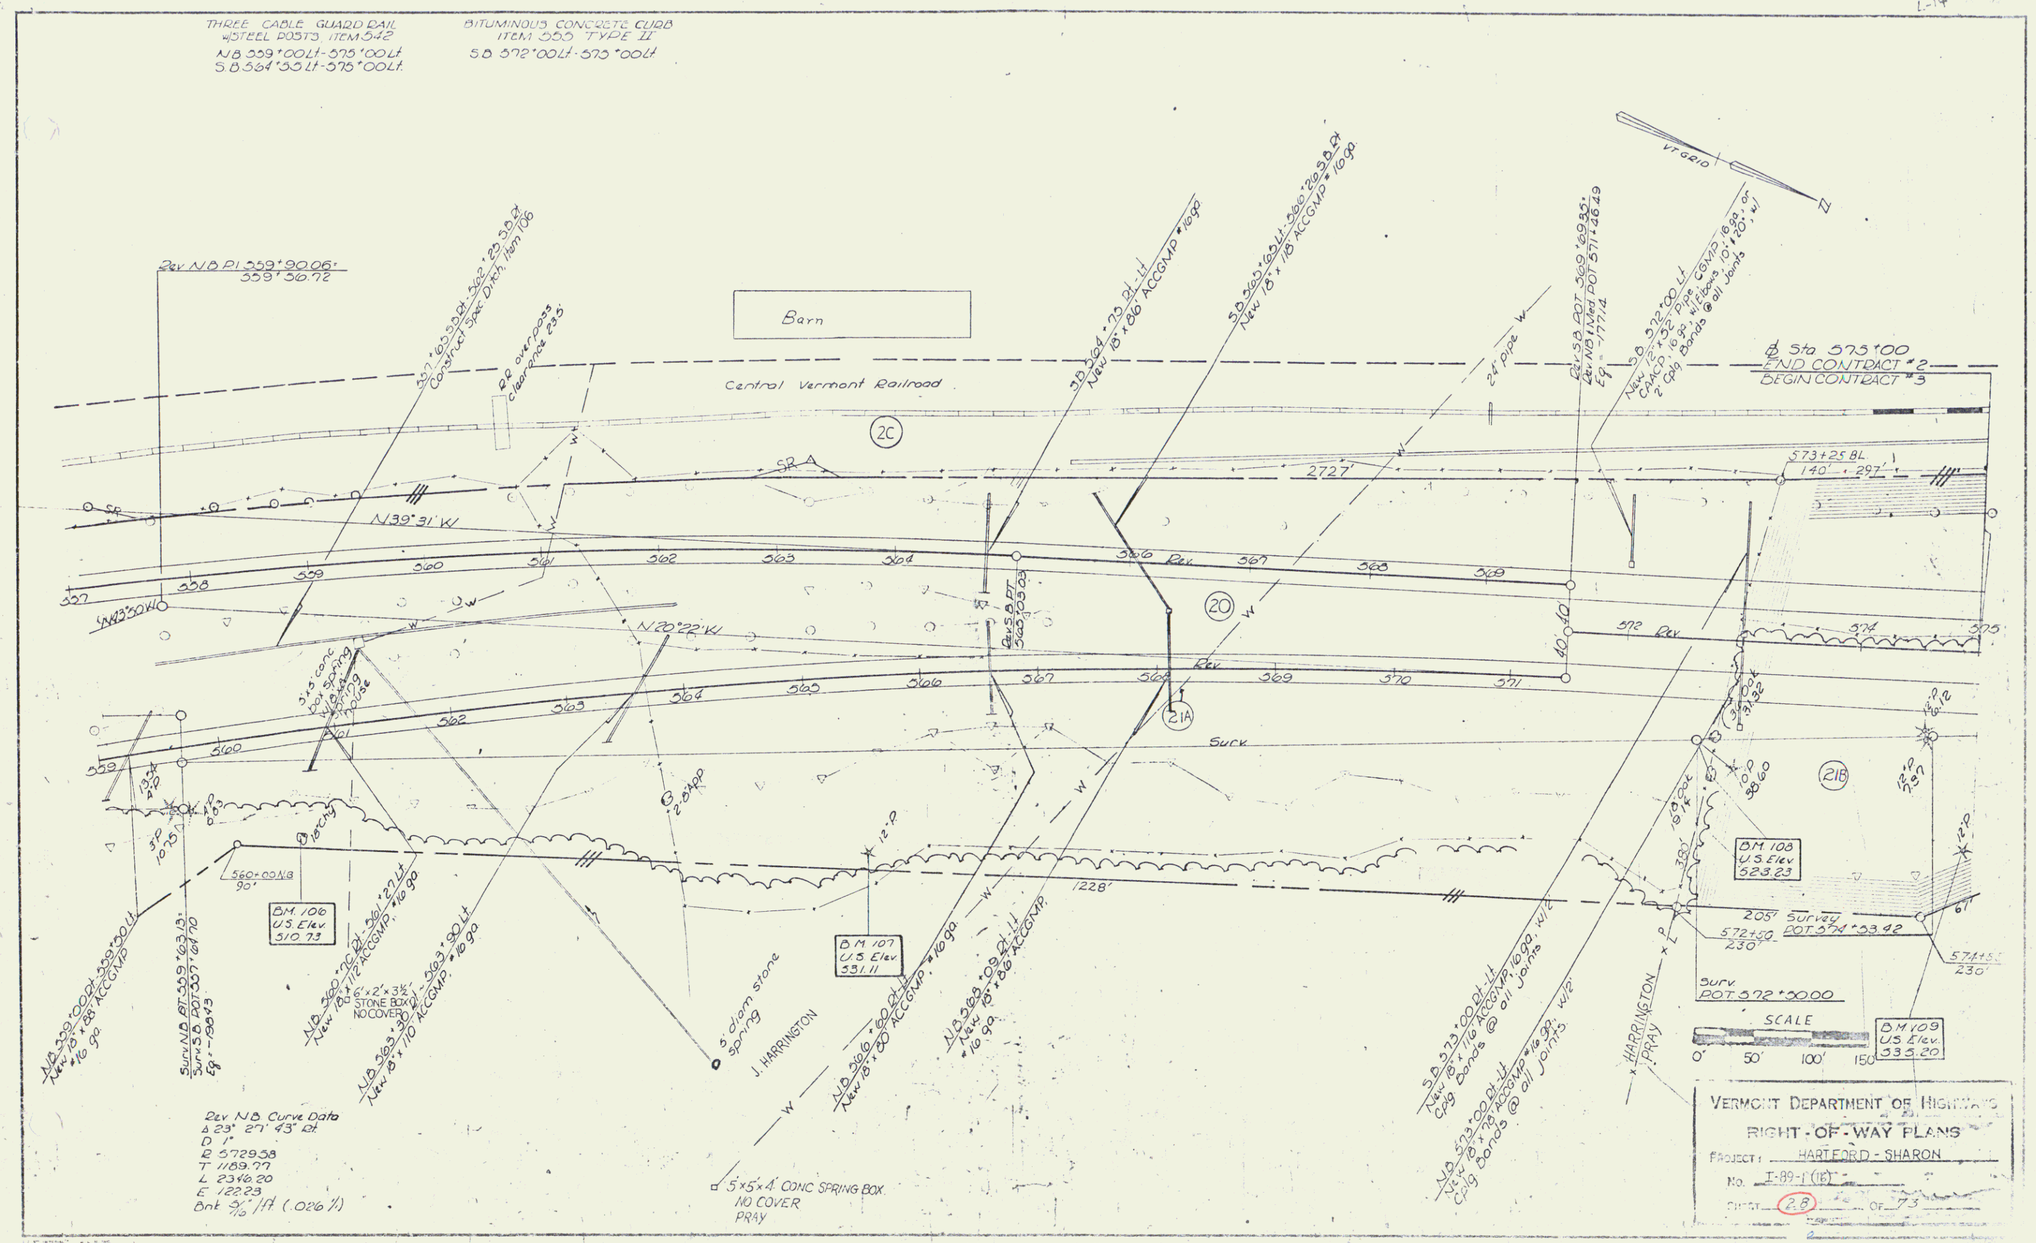
THREE CABLE GUARD RAIL W/STEEL POSTS, ITEM 542
NB 559'00 Lt - 575'00 Lt
SB 564'55 Lt - 575'00 Lt
BITUMINOUS CONCRETE CURB ITEM 555 TYPE II
SB 572'00 Lt - 575'00 Lt
Rev NB PI 559'90.06'
559'56.72
Barn
Central Vermont Railroad
RR overpass clearance 23.5
24" pipe
Sta 575'00
END CONTRACT #2
BEGIN CONTRACT #3
573+25 BL
140' - 297'
2727'
N39°31' W
N20°22' W
1228'
205' Survey
Surv POT 572'00.00
SCALE
0' 50' 100' 150
BM 106 U.S. Elev. 510.73
BM 107 U.S. Elev. 531.11
BM 108 U.S. Elev. 523.23
BM 109 U.S. Elev. 535.20
5' diam stone spring
J. HARRINGTON
HARRINGTON - PRAY
5'x5'x4' CONC SPRING BOX. NO COVER PRAY
Rev NB Curve Data
Δ 23° 27' 43" Rt
D 1°
R 5729.58
T 1189.77
L 2346.20
E 122.23
Bnk 5/10 /ft (.026'/')
VERMONT DEPARTMENT OF HIGHWAYS
RIGHT-OF-WAY PLANS
PROJECT: HARTFORD - SHARON
No. I-89-1 (18)
SHEET 2.8 OF 73