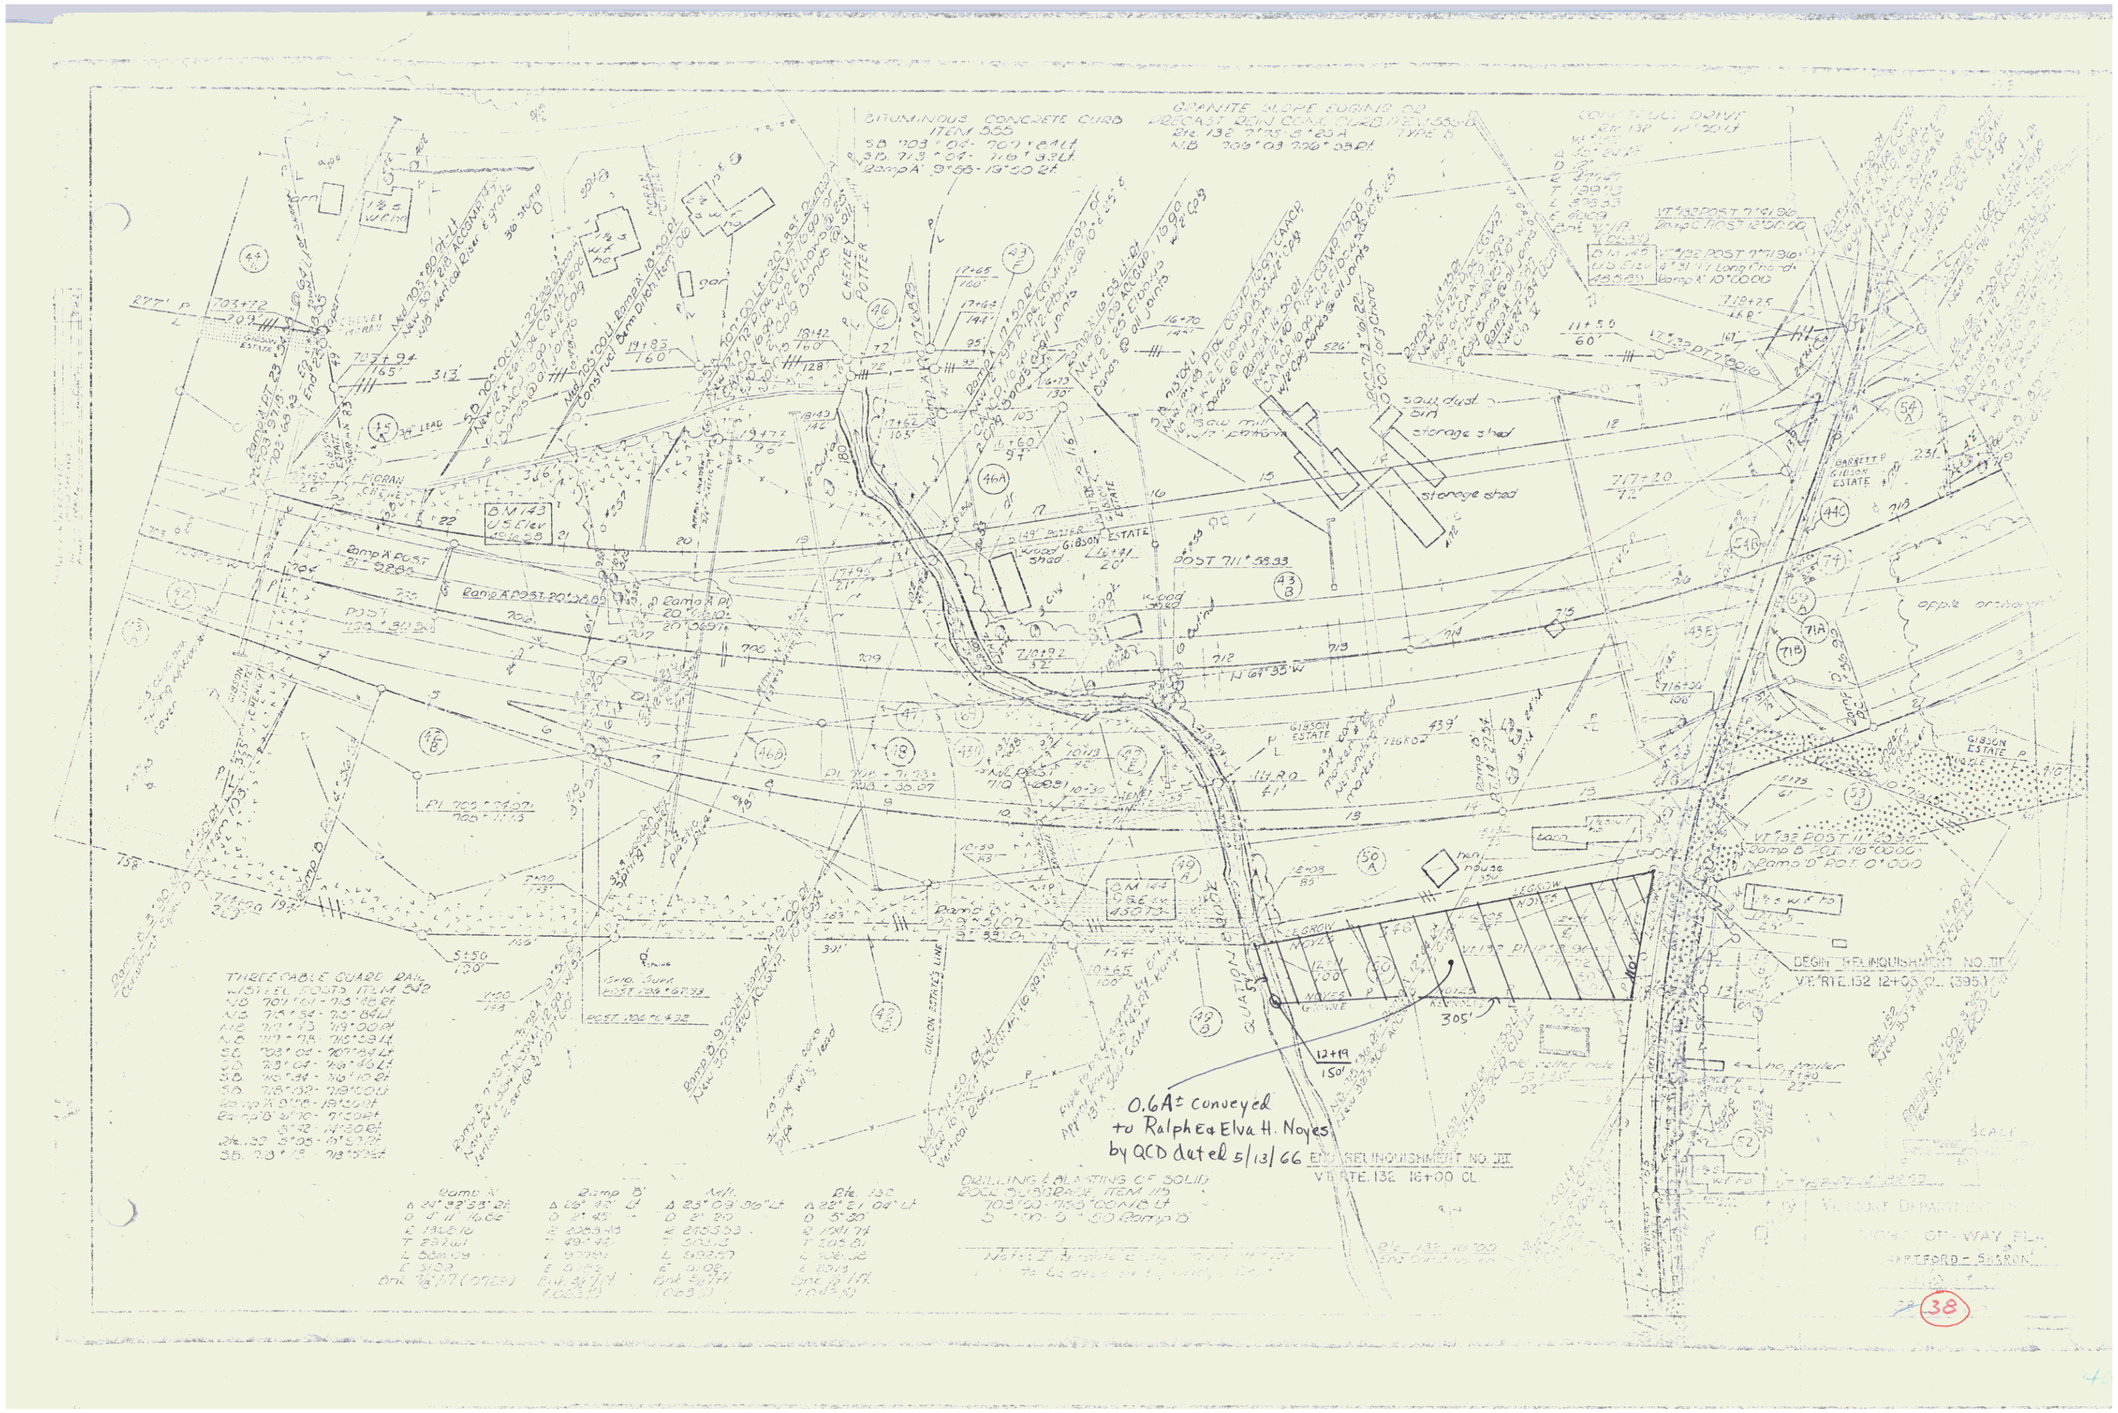
BITUMINOUS CONCRETE CURB
ITEM 555
GRANITE SLOPE EDGING CD
PRECAST DRN CONC TOP & ITEM 556-0
COV TRUCK DRIVE
storage shed
sawdust bin
storage shed
GIBSON ESTATE
BARNETT & GIBSON ESTATE
apple orchard
MORAN CREEK
CHENEY POTTER
BM 143 US Elev 1456.29
BM 144 US Elev 1430.73
Ramp A POST 81°52.86
Ramp A POST 70°56.00
Ramp A Pl 20°06.10
Ramp A POST 711°58.93
Ramp B POST 716°00.00
Ramp B POST 0°0.00
VT 132 POST 7°91.90
Ramp C POST 10°00.00
VT 132 POST 11°20.92
Ramp D POST 0°0.00
THREE CABLE GUARD RAIL
WISHBONE POSTS ITEM 630
DEGIN RELINQUISHMENT NO. III
VT RTE. 152 12+00 CL. (395)
END RELINQUISHMENT NO. III
VT RTE. 152 16+00 CL.
0.6A± conveyed
to Ralph & Elva H. Noyes
by QCD dated 5/13/66
DRILLING & BLASTING OF SOLID
ROCK SUBGRADE, ITEM 115
305'
12+19
150'
no trailer
VERMONT DEPARTMENT OF
RIGHT OF WAY PLAN
HARTFORD - SHARON
38