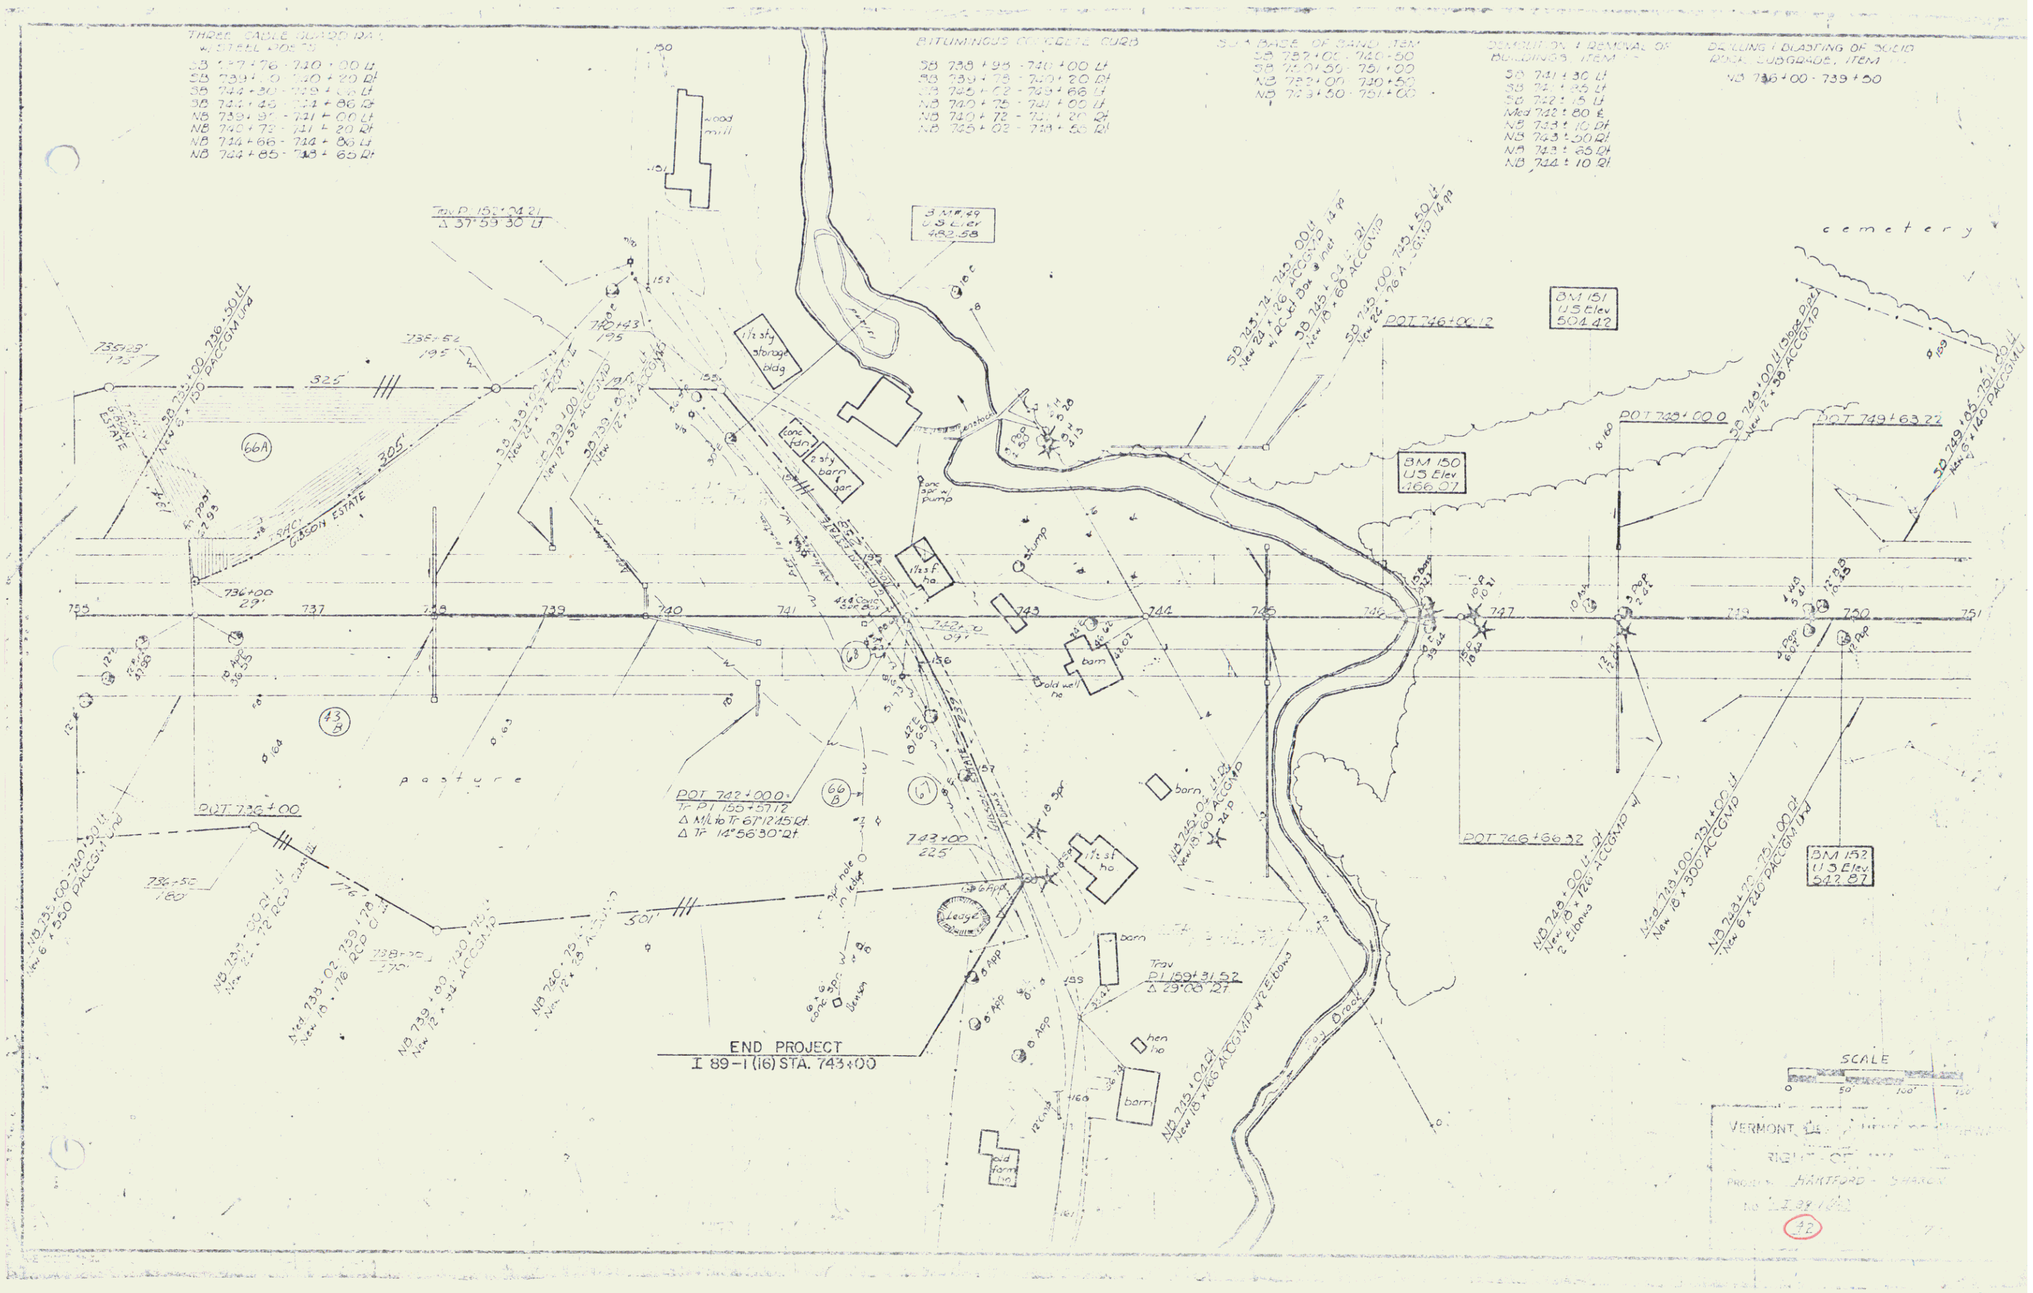
THREE CABLE GUARD RAIL W. STEEL POSTS
BITUMINOUS CONCRETE CURB
SUB BASE OF GRAVEL ITEM
DEMOLITION & REMOVAL OF BUILDINGS ITEM
DRILLING & BLASTING OF SOLID ROCK SUBGRADE, ITEM
cemetery
BM 151 U.S. Elev. 504.42
BM 150 U.S. Elev. 466.07
BM 152 U.S. Elev. 622.87
POT 746+66.32
POT 749+63.22
POT 743+00.0
POT 736+00
END PROJECT
I 89-1 (16) STA. 743+00
SCALE
VERMONT
RIGHT OF WAY
PROJECT HARTFORD - SHARON
NO. I 89-1(16)
12