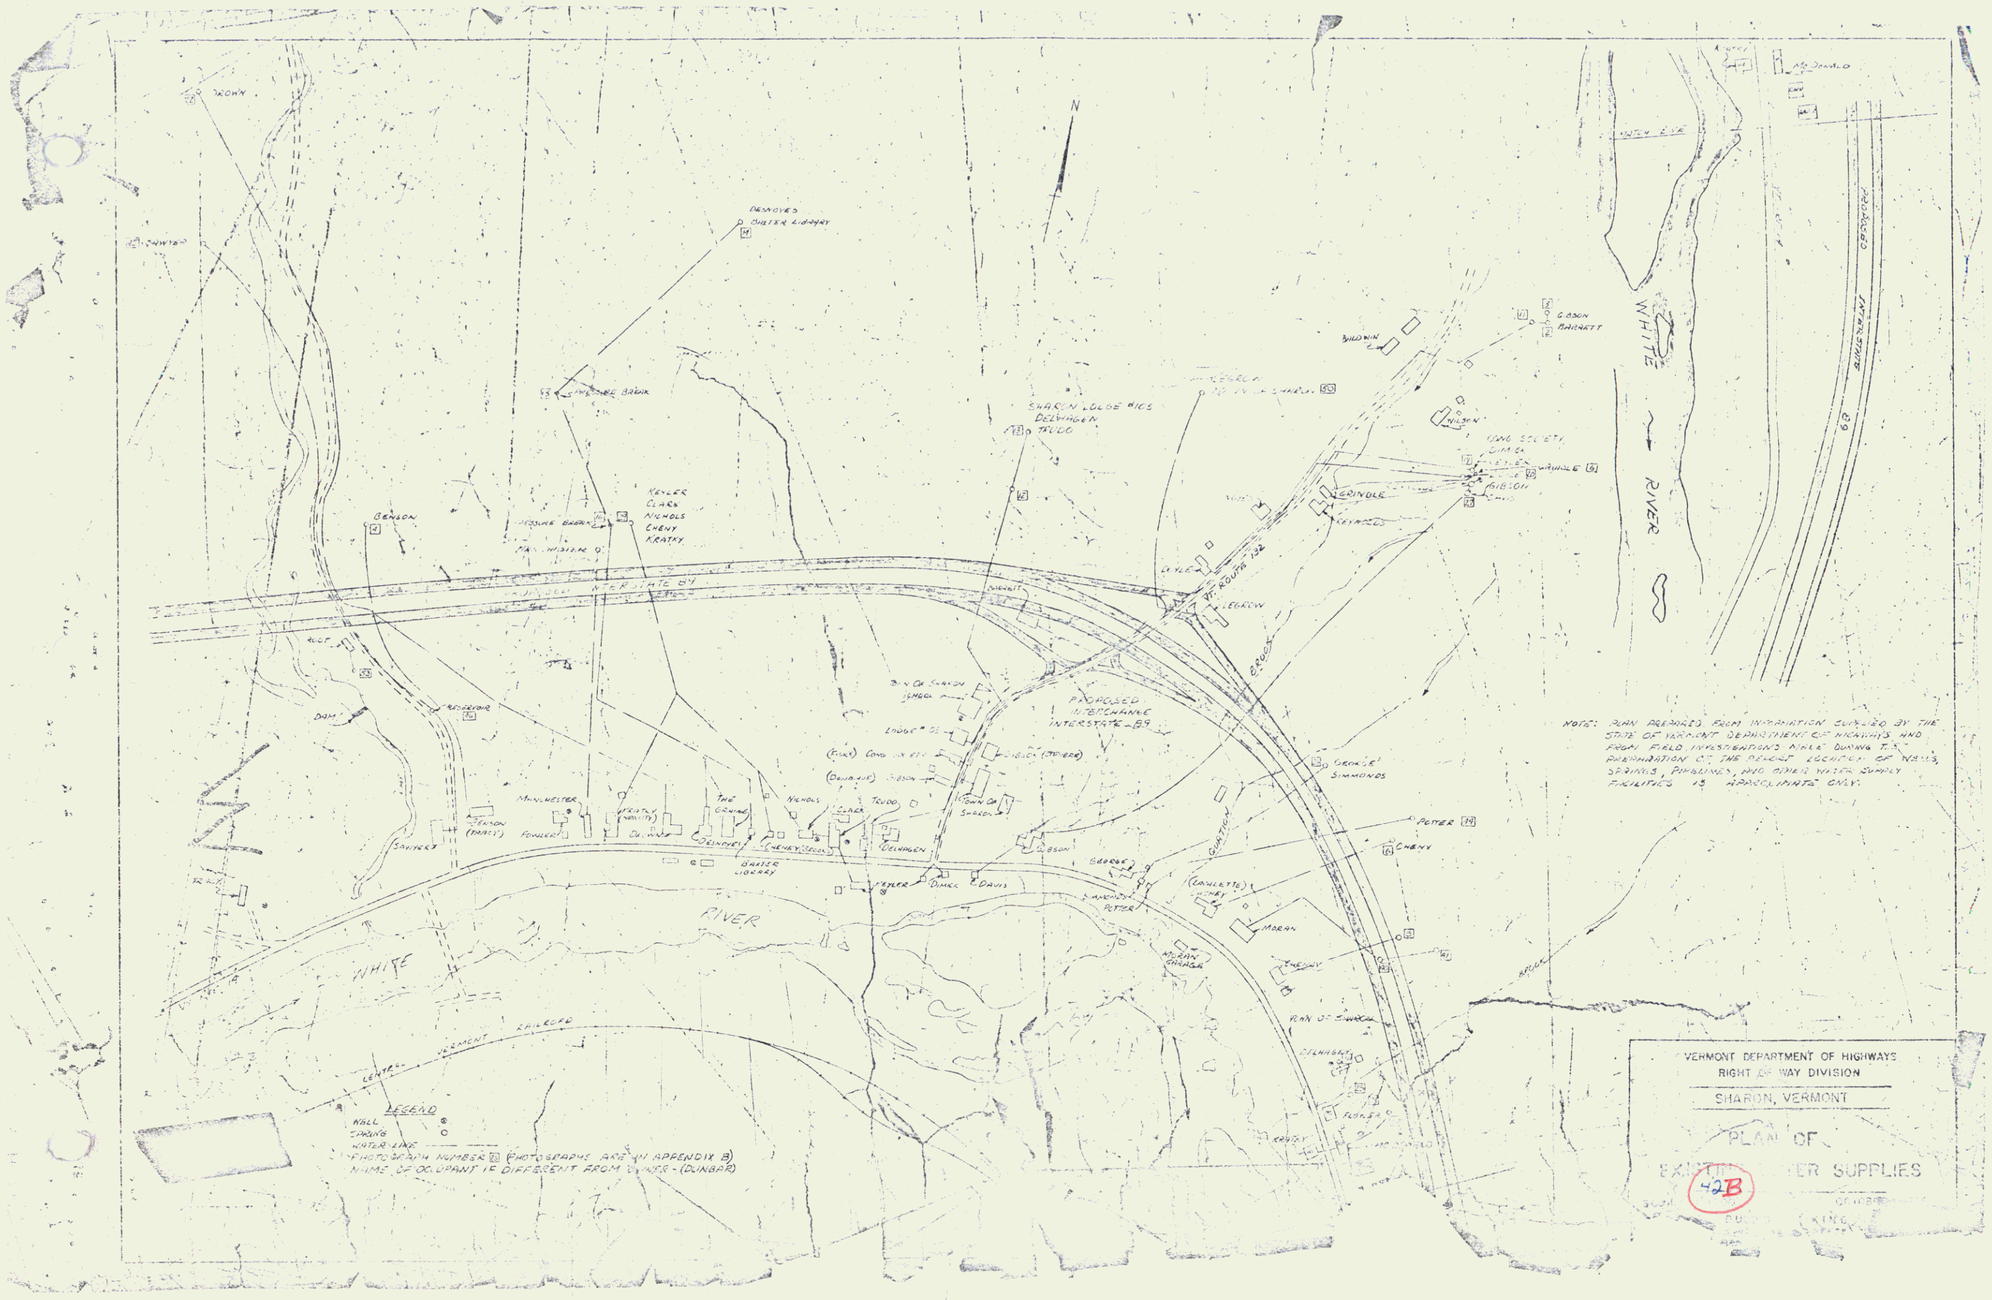
WHITE
RIVER
PROPOSED
INTERSTATE 89
PROPOSED
NOTE: PLAN PREPARED FROM INFORMATION FURNISHED BY THE STATE OF VERMONT DEPARTMENT OF HIGHWAYS AND FROM FIELD INVESTIGATIONS MADE DURING THE PREPARATION OF THE DRAFT LOCATION OF WELLS, SPRINGS, PIPELINES, AND OTHER WATER SUPPLY FACILITIES IS APPROXIMATE ONLY.
VERMONT DEPARTMENT OF HIGHWAYS
RIGHT OF WAY DIVISION
SHARON, VERMONT
PLAN OF
EXISTING WATER SUPPLIES
LEGEND
WELL
SPRING
WATER LINE
PHOTOGRAPH NUMBER (PHOTOGRAPHS ARE IN APPENDIX B)
NAME OF OCCUPANT IF DIFFERENT FROM OWNER - (DUNBAR)
42B
46