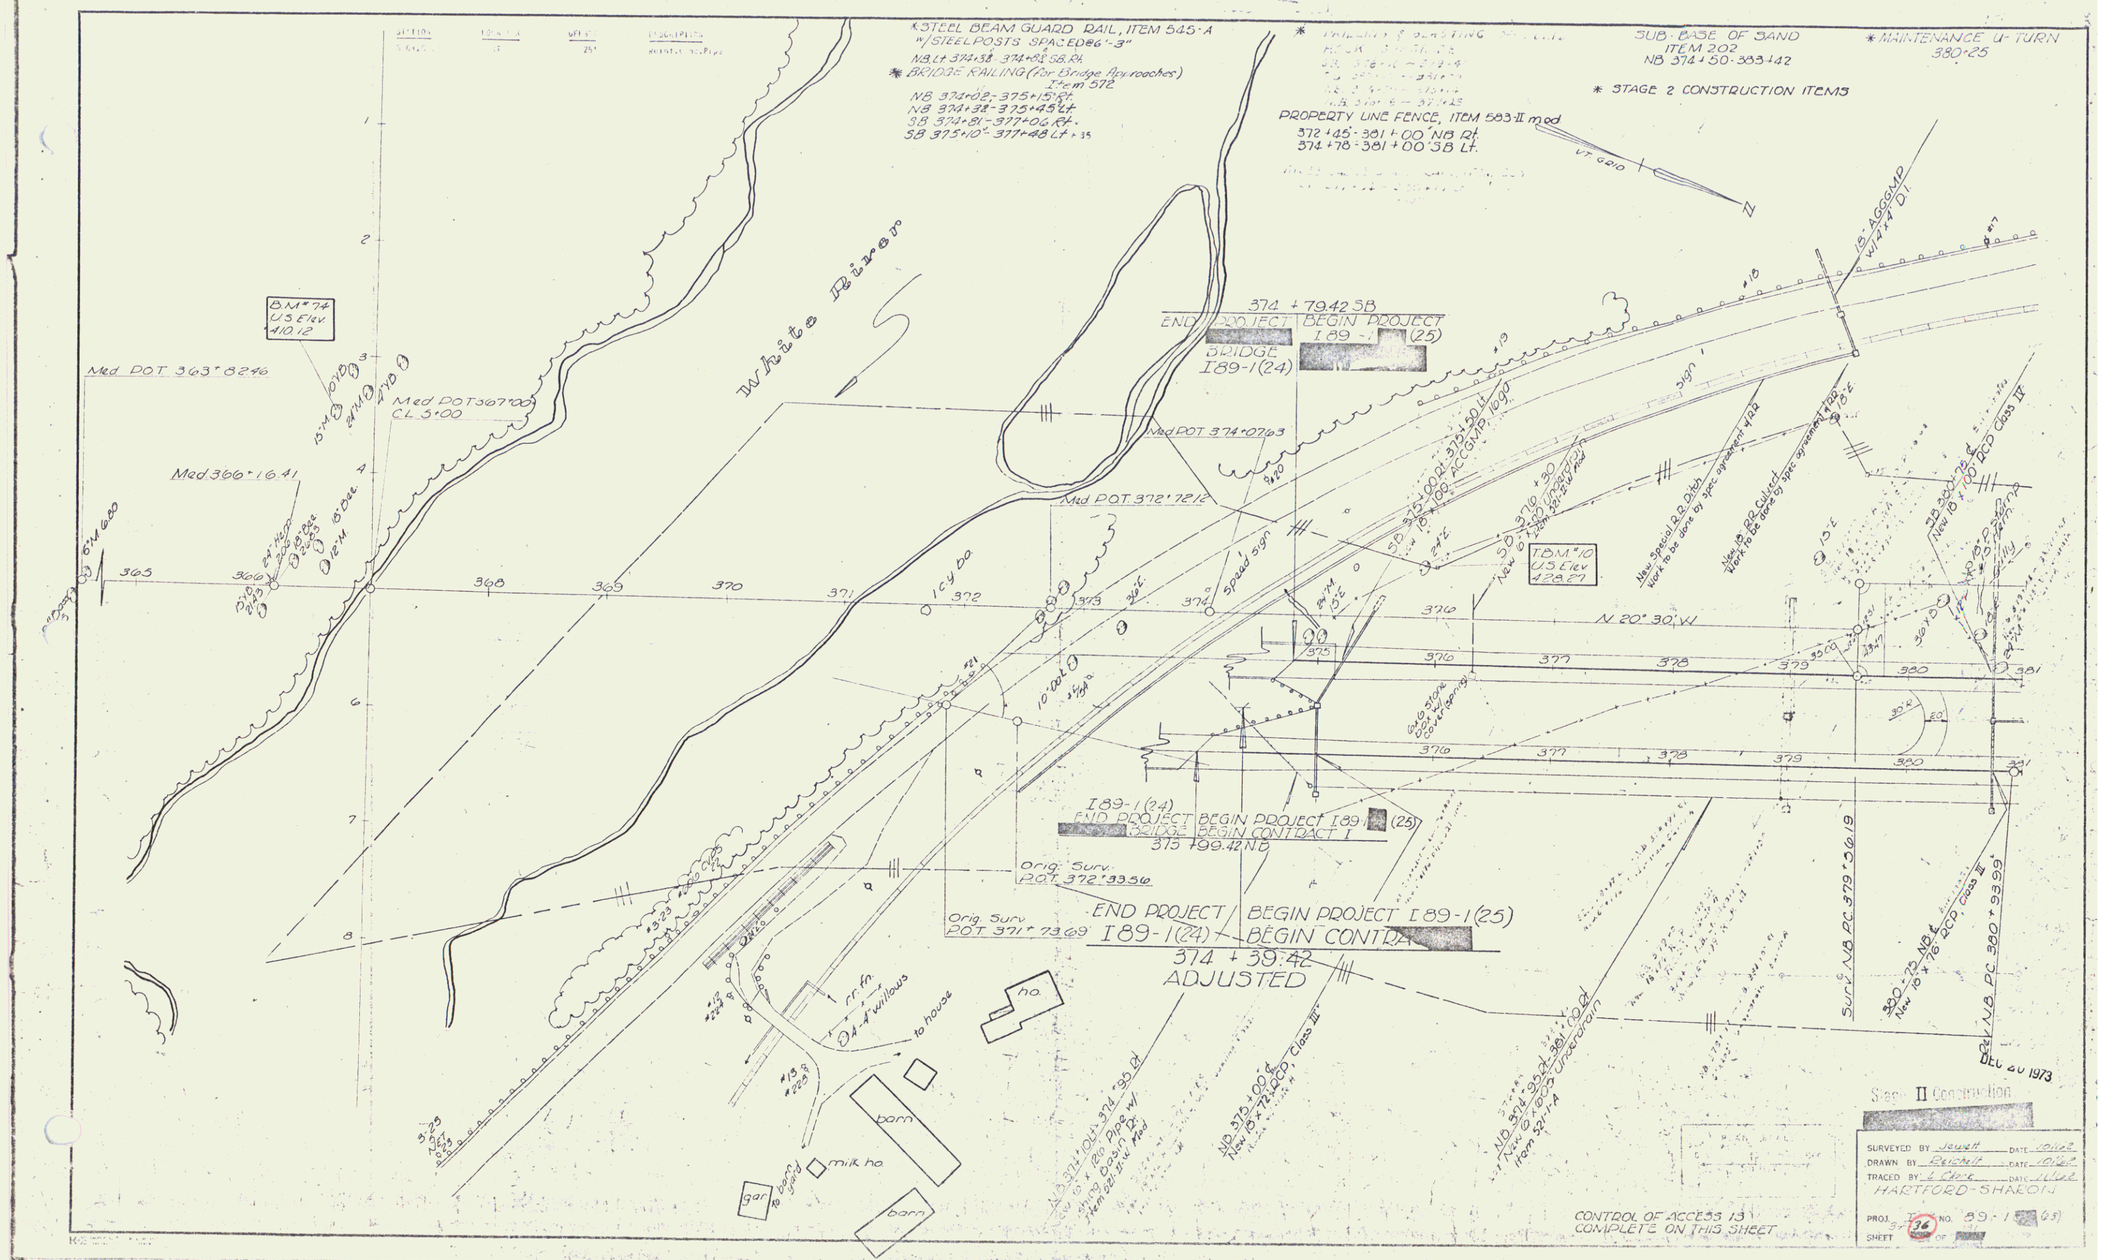
*STEEL BEAM GUARD RAIL, ITEM 545-A
w/STEEL POSTS SPACED @ 6'-3"
NB Lt 374+38 - 374+82 SB Rt
* BRIDGE RAILING (For Bridge Approaches)
Item 572
NB 374+02 - 375+15 Rt
NB 374+38 - 375+45 Lt
SB 374+81 - 377+06 Rt
SB 375+10 - 377+48 Lt
PROPERTY LINE FENCE, ITEM 583-II mod
372+45 - 381+00 NB Rt
374+78 - 381+00 SB Lt
SUB-BASE OF SAND
ITEM 202
NB 374+50 - 383+42
* MAINTENANCE U-TURN
380+25
* STAGE 2 CONSTRUCTION ITEMS
White River
BM #74
U.S. Elev.
410.12
Med POT 363+82.46
Med POT 367+00
CL 3+00
Med 366+16.41
Med POT 374+07.63
Med POT 372+72.12
374 + 79.42 SB
END PROJECT
BEGIN PROJECT
I 89 - (25)
BRIDGE
I 89-1(24)
T.B.M. #10
U.S. Elev.
428.27
N. 20° 30' W.
I 89-1(24)
END PROJECT
BEGIN PROJECT I 89-1 (25)
BRIDGE
BEGIN CONTRACT
373 + 99.42 NB
Orig. Surv.
POT 372+93.56
Orig. Surv.
POT 371+73.69
END PROJECT
I 89-1(24)
BEGIN PROJECT I 89-1(25)
BEGIN CONTRACT
374 + 39.42
ADJUSTED
Surv. NB PC 379+56.19
Surv. NB PC 380+99.99
DEC 20 1973
Stage II Construction
SURVEYED BY Jewett DATE 10/62
DRAWN BY Reichert DATE 10/62
TRACED BY L. Cote DATE 11/62
HARTFORD-SHARON
PROJ. NO. 89-1 (25)
SHEET 36 OF
CONTROL OF ACCESS 13
COMPLETE ON THIS SHEET
barn
milk ho
gar
house
ho