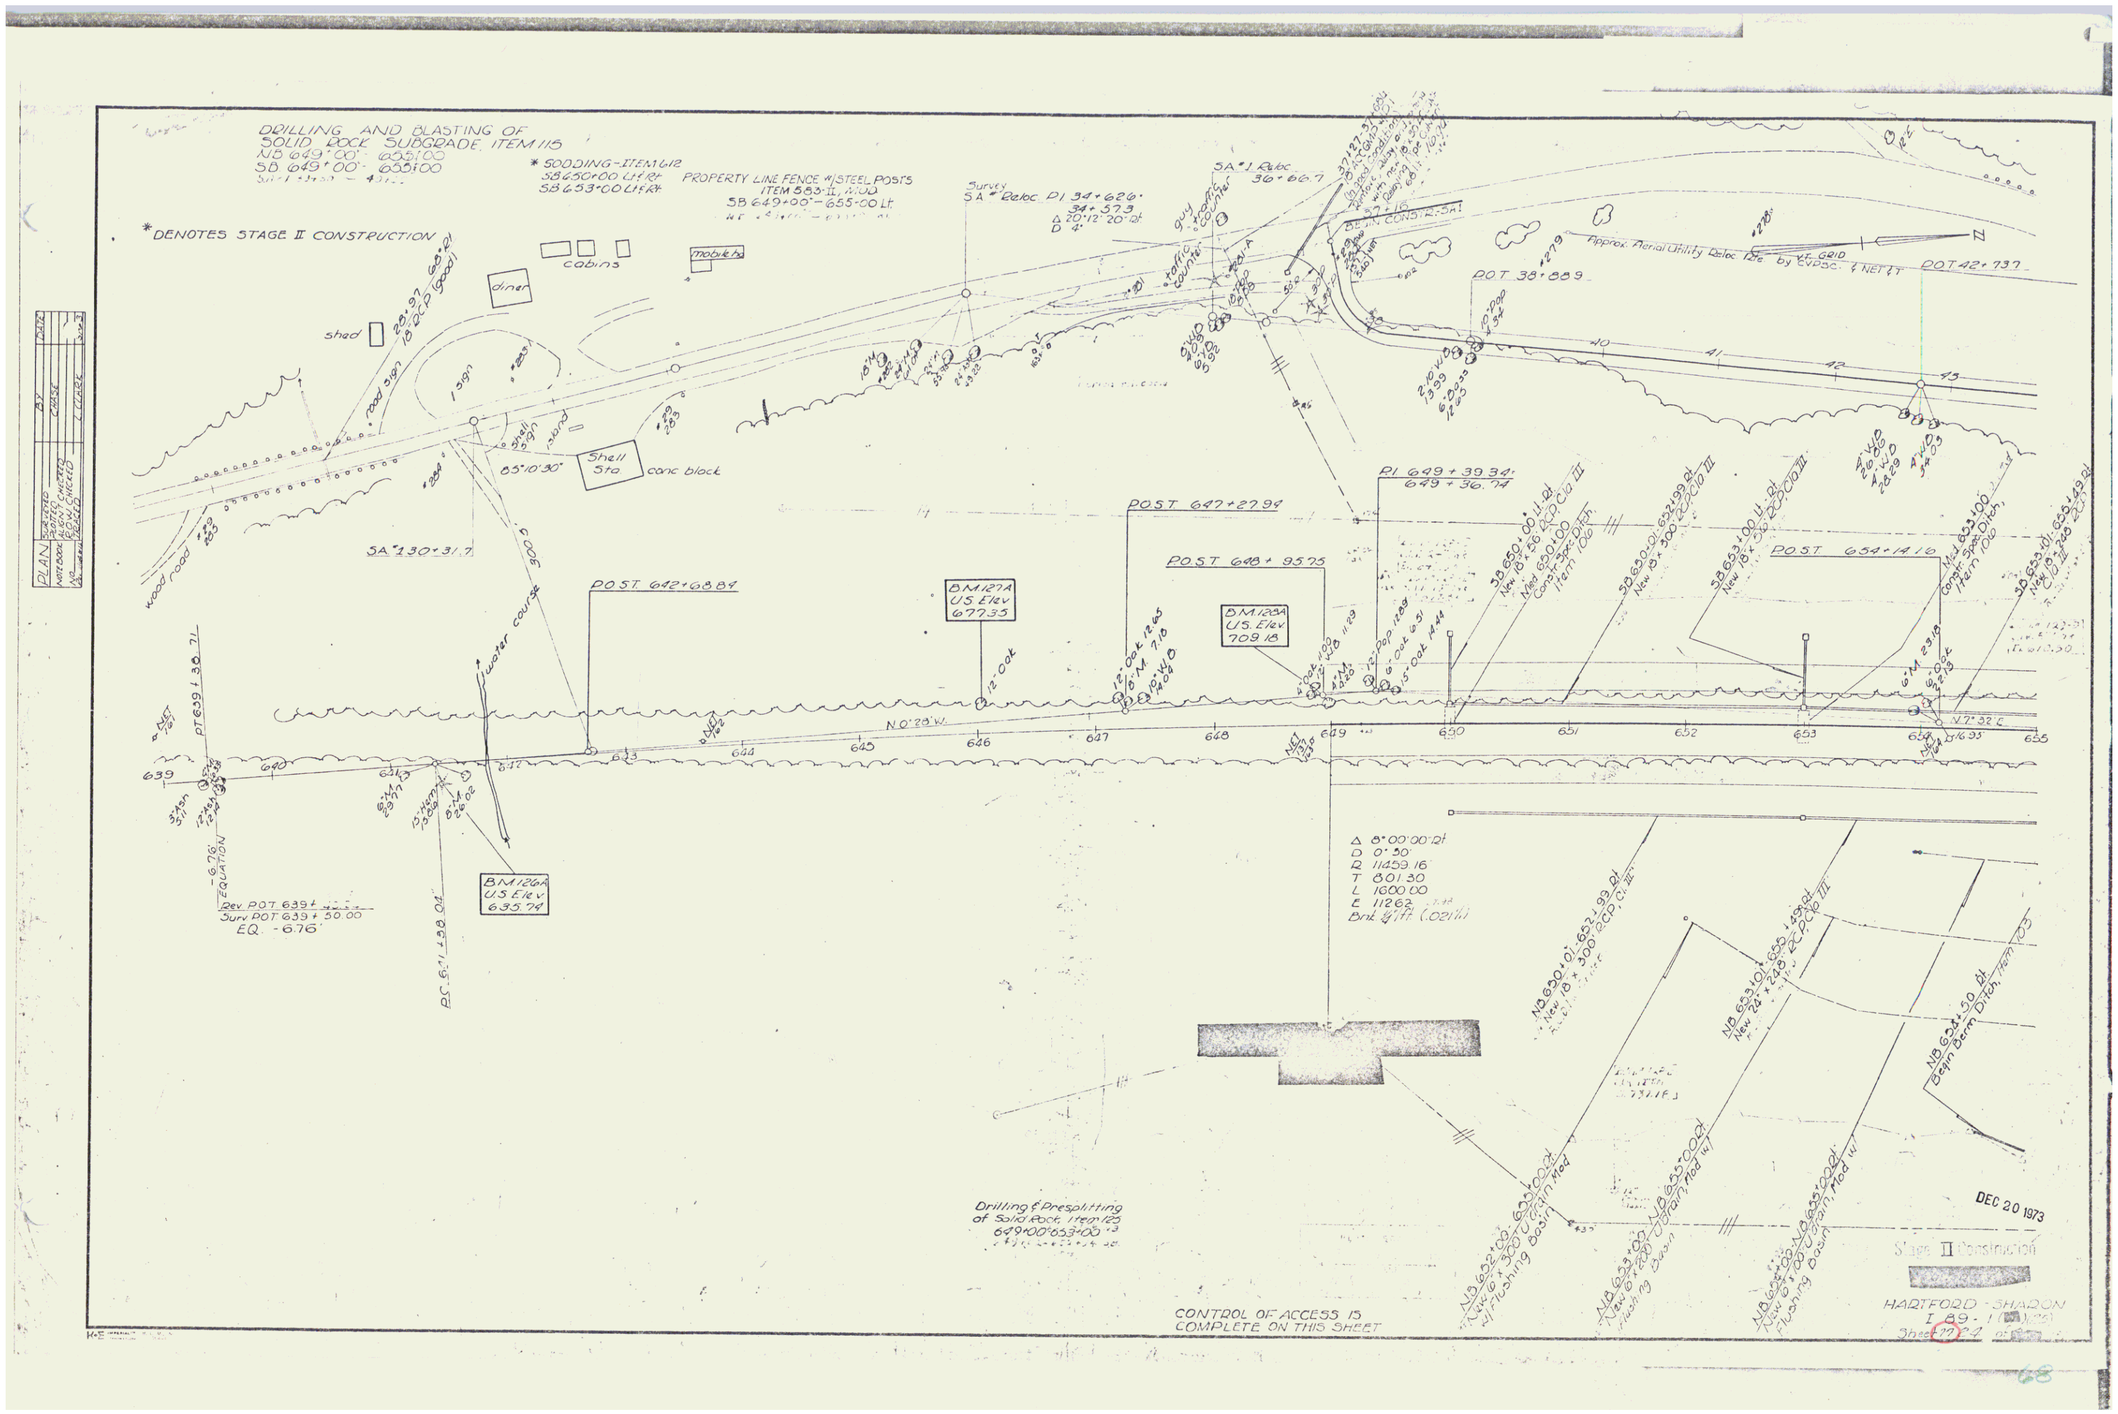
DRILLING AND BLASTING OF SOLID ROCK SUBGRADE, ITEM 115
NB 649+00 - 655+00
SB 649+00 - 655+00
* SODDING - ITEM 612
SB 650+00 Lt/Rt
SB 653+00 Lt/Rt
PROPERTY LINE FENCE W/STEEL POSTS
ITEM 583-II, WOOD
SB 649+00 - 655+00 Lt.
* DENOTES STAGE II CONSTRUCTION
cabins
mobile hs
diner
shed
Shell Sta
conc block
wood road
water course
POST 642+68.84
POST 647+27.99
POST 648+95.75
POST 654+14.10
BM 127A U.S. Elev 677.35
BM 128A U.S. Elev 709.18
BM 126A U.S. Elev 635.79
PI 649+39.34
649+36.74
Approx. Aerial Utility Reloc. by EVPSC. & NETT
POT 38+88.9
POT 42+73.7
N 0°28' W.
N 7°32' E.
Δ 8°00'00" Rt
D 0°30'
R 11459.16
T 801.30
L 1600.00
E 11262
Drilling & Presplitting of Solid Rock, Item 120
649+00-653+00
CONTROL OF ACCESS IS COMPLETE ON THIS SHEET
DEC 20 1973
Stage II Construction
HARTFORD - SHARON
I-89