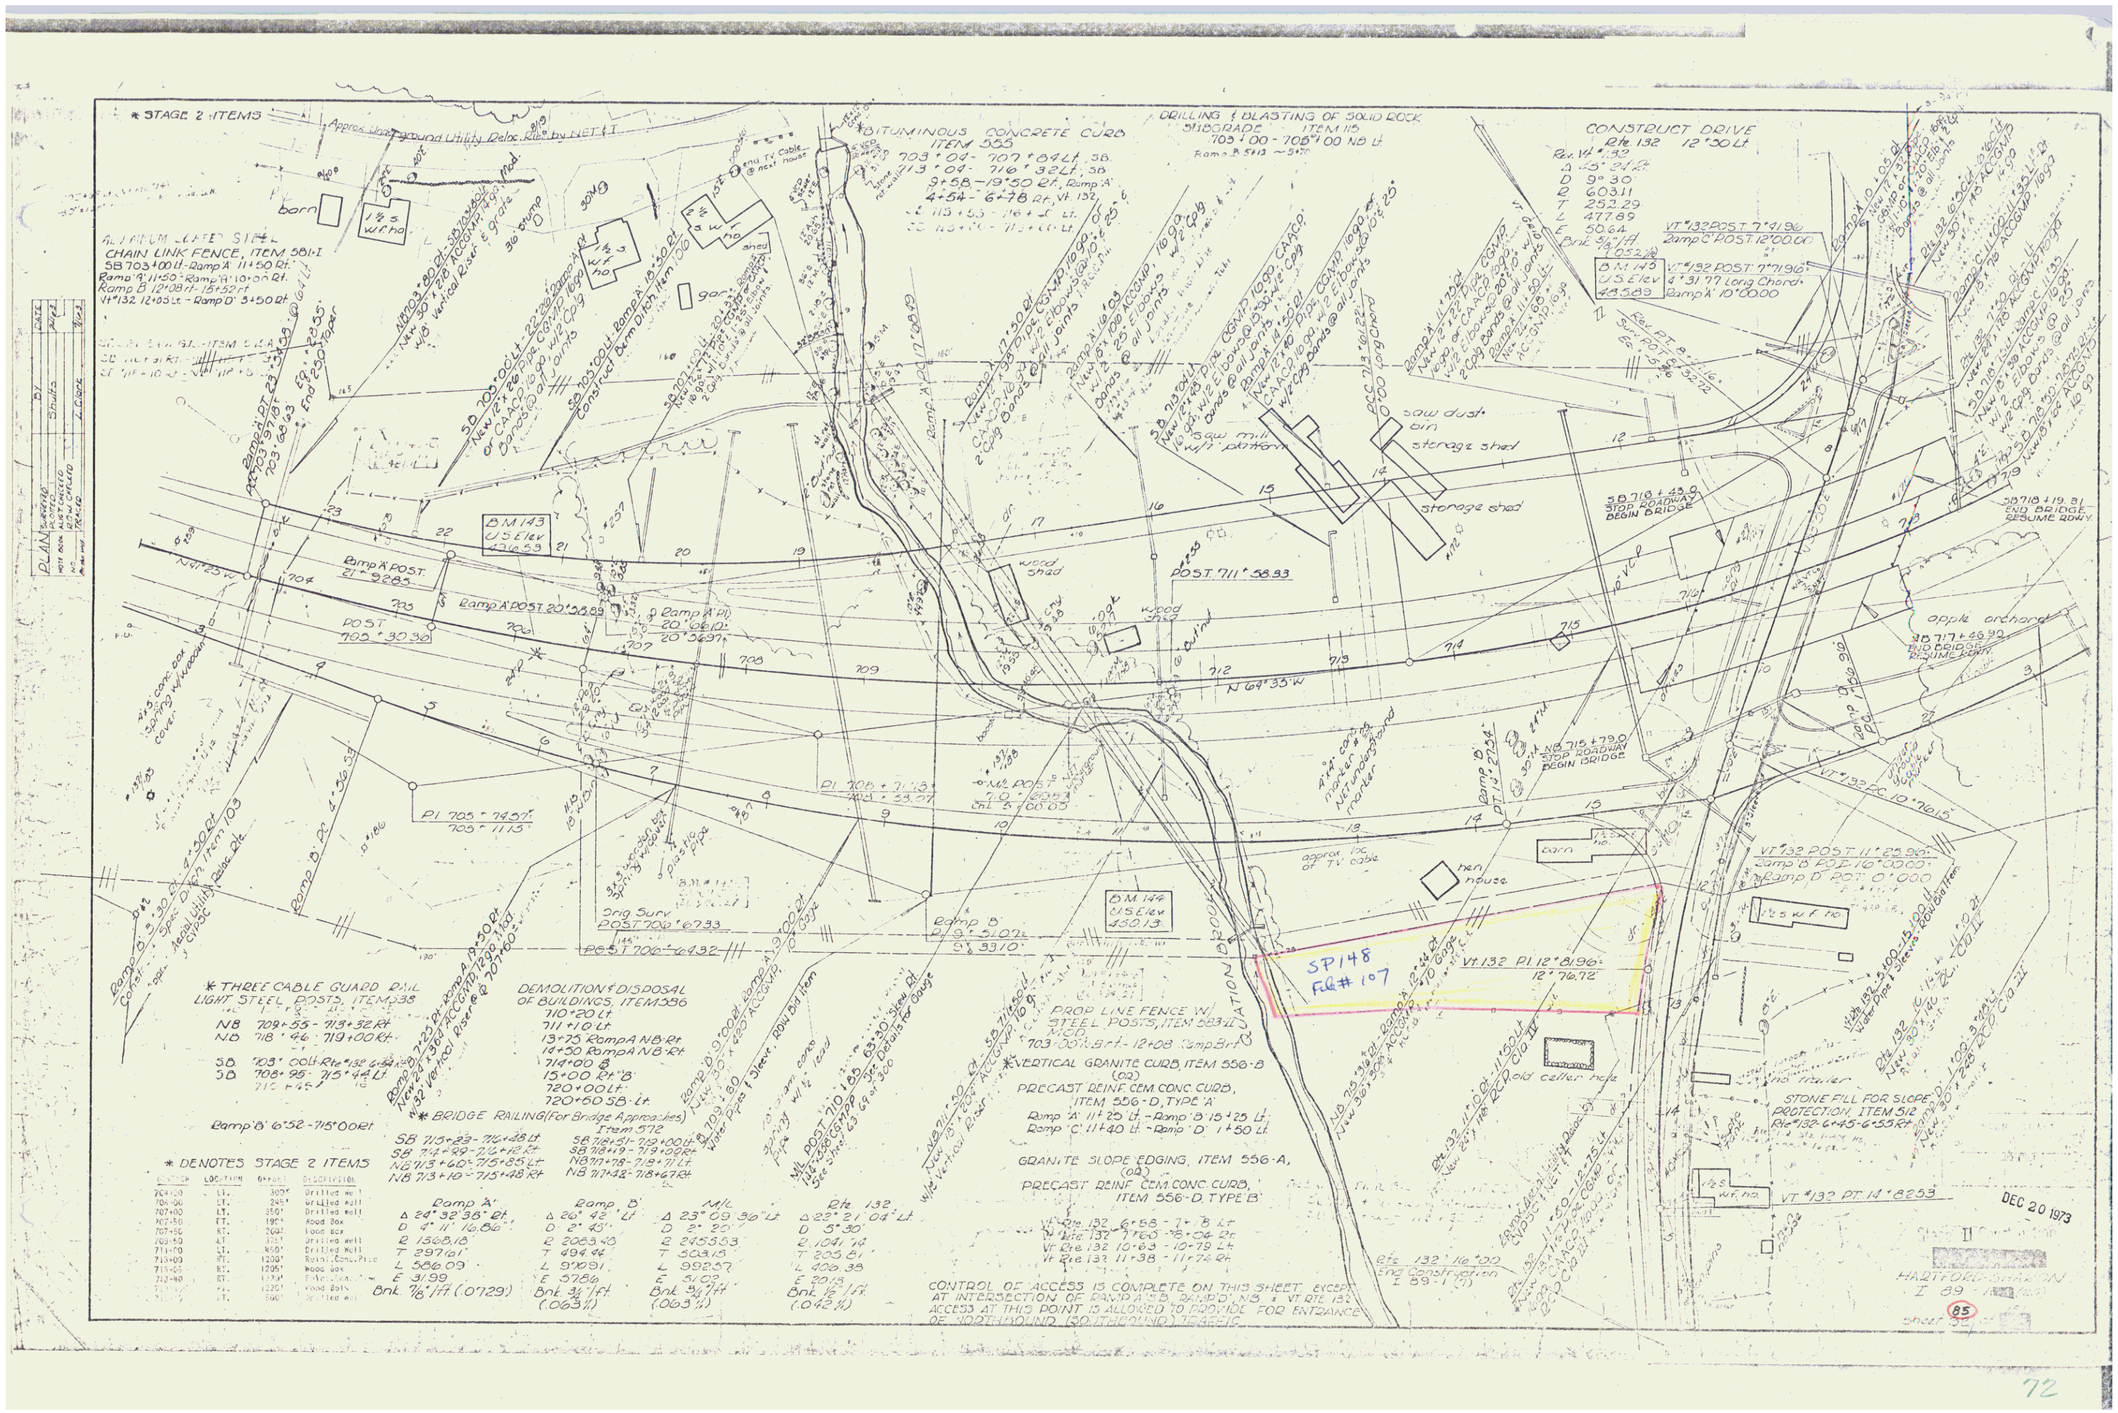
* STAGE 2 ITEMS
Approx. Underground Utility Reloc. Rte. 132 by NET & T
BITUMINOUS CONCRETE CURB ITEM 555
DRILLING & BLASTING OF SOLID ROCK SUBGRADE ITEM 115
CONSTRUCT DRIVE Rte. 132 12'-30' Lt
ALUMINUM GATES SITE L CHAIN LINK FENCE, ITEM 581-I
BM 143 USElev 436.53
BM 144 USElev 450.13
saw mill with platform
saw dust bin
storage shed
wood shed
barn
hen house
old cellar hole
apple orchard
Orig Surv POST 700+16.33
POST 711+58.33
POST 705+30.30
Ramp 'A' POST 21+92.85
Ramp 'A' POST 20+38.89
Ramp 'B' POST 6+52
Ramp 'B' PI 3+51.02
Ramp 'B' PI 5+33.70
PI 705+74.57
PI 705+71.13
Mil POST 7.0+22.95
Mil POST 7.0+00.05
Mil POST 710+85.63
Rte. 132 PI 12+81.96
Rte. 132 PC 10+76.15
VT. 132 POST 11+25.96
VT. 132 PT. 14+82.53
VT. 132 PI 12+81.96
12+76.72
SP148 FLG# 107
STONE FILL FOR SLOPE PROTECTION, ITEM 512
PROP. LINE FENCE W/ STEEL POSTS, ITEM 583-II MOD.
VERTICAL GRANITE CURB, ITEM 556-B (02)
PRECAST REINF. CEM. CONC. CURB, ITEM 556-D, TYPE 'A'
GRANITE SLOPE EDGING, ITEM 556-A, (02)
PRECAST REINF. CEM. CONC. CURB, ITEM 556-D, TYPE 'B'
THREE CABLE GUARD RAIL LIGHT STEEL POSTS, ITEM 338
DEMOLITION & DISPOSAL OF BUILDINGS, ITEM 336
BRIDGE RAILING (For Bridge Approaches) Item 572
* DENOTES STAGE 2 ITEMS
CONTROL OF ACCESS IS COMPLETE ON THIS SHEET EXCEPT AT INTERSECTION OF RAMP A & B, RAMP D & VT. RTE. 132. ACCESS AT THIS POINT IS ALLOWED TO PROVIDE FOR ENTRANCE OF NORTHBOUND (SOUTHBOUND) TRAFFIC
DEC 20 1973
HARTFORD-BRAKEN I 89
85
72