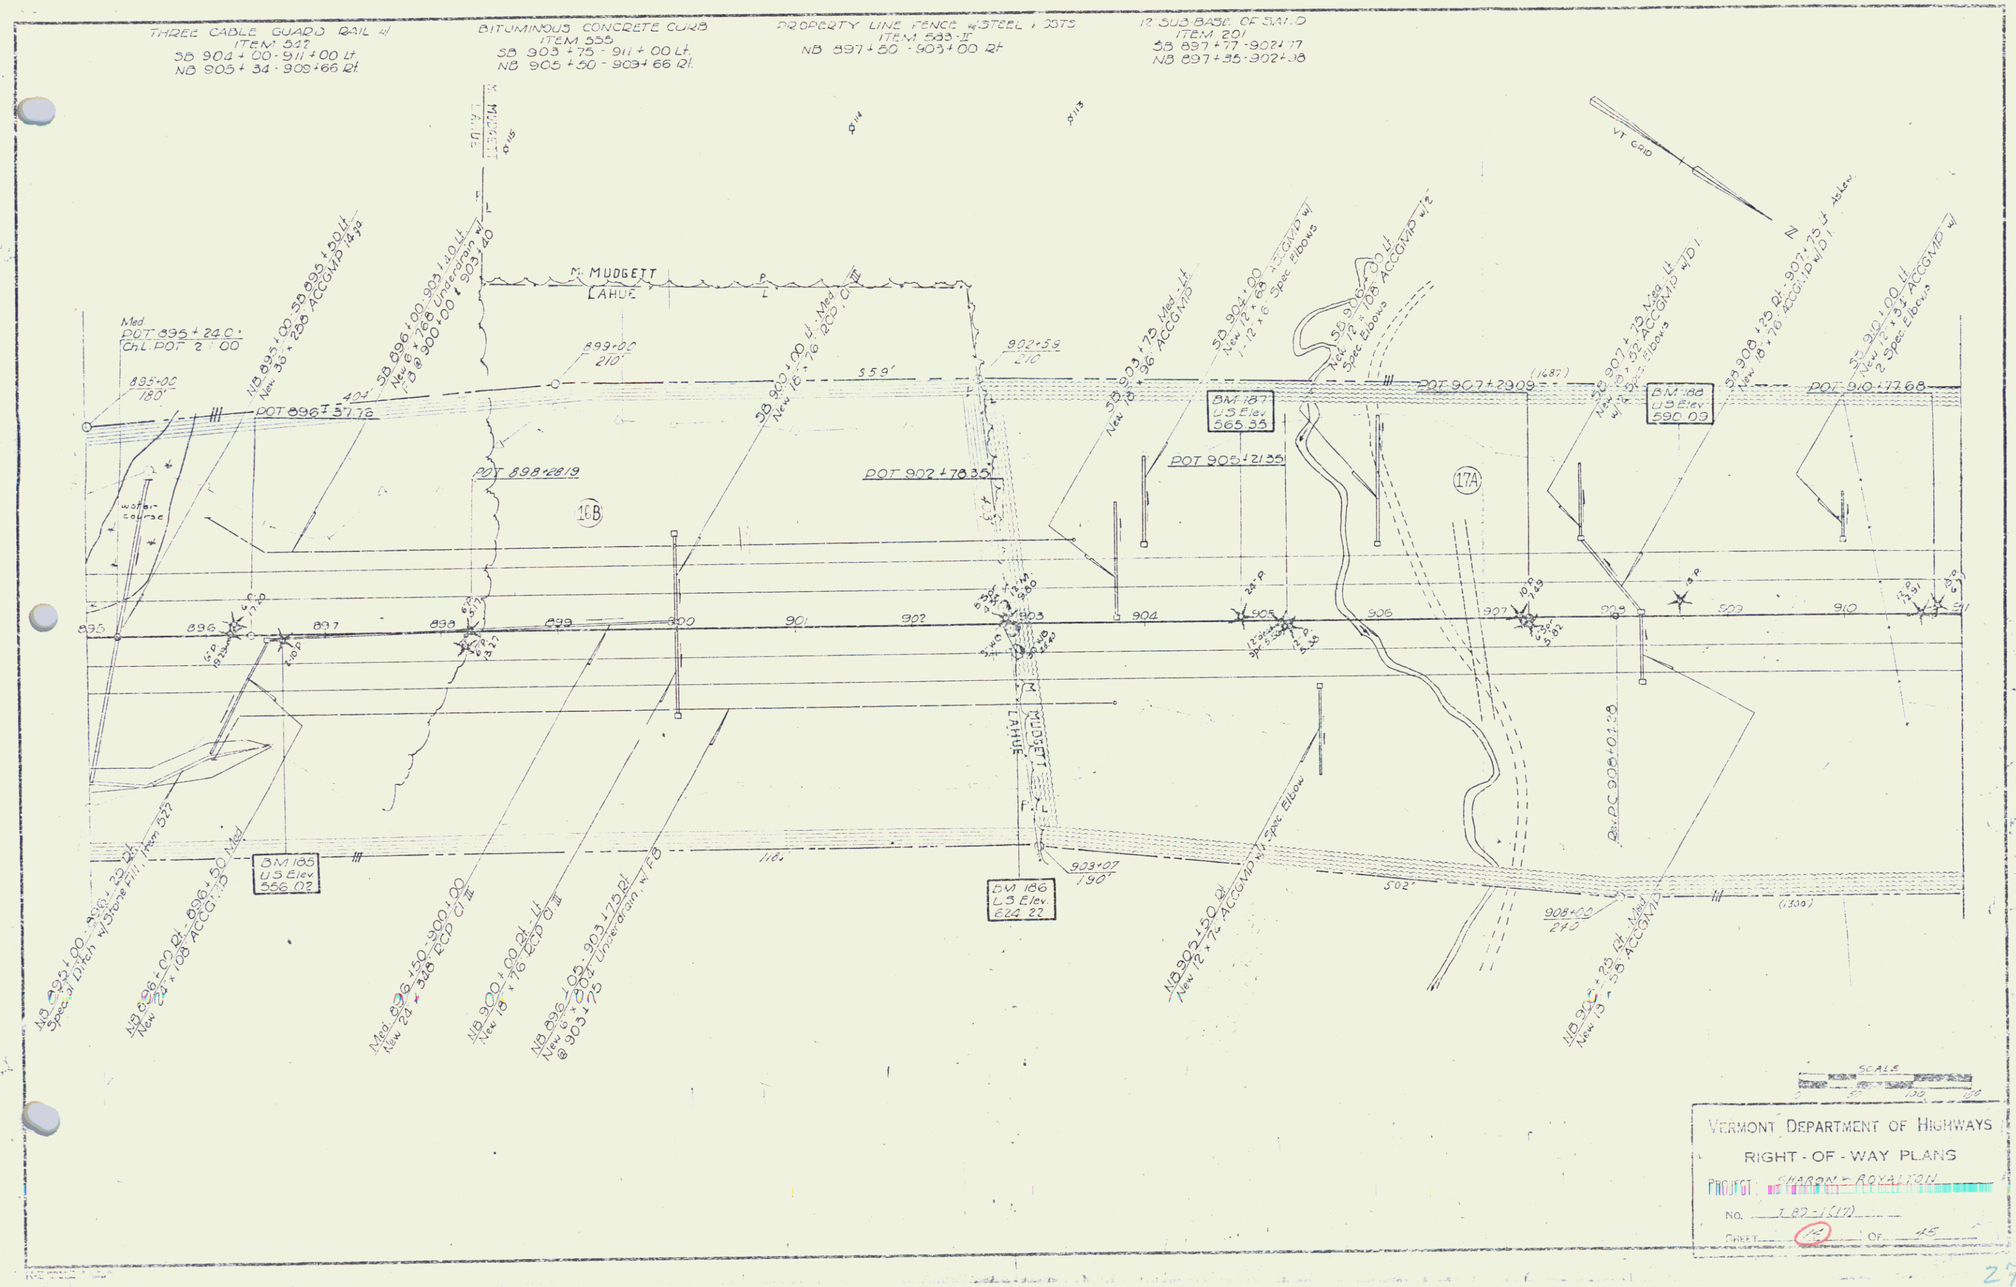
THREE CABLE GUARD RAIL w/
ITEM 542
SB 904+00 - 911+00 Lt.
NB 905+34 - 909+66 Rt.
BITUMINOUS CONCRETE CURB
ITEM 555
SB 903+75 - 911+00 Lt.
NB 905+50 - 909+66 Rt.
PROPERTY LINE FENCE w/STEEL POSTS
ITEM 589-11
NB 897+50 - 903+00 Rt.
12" SUB-BASE OF SAND
ITEM 201
SB 897+77 - 902+77
NB 897+35 - 902+38
M. MUDGETT
LAHUE
POT 896+37.76
POT 898+28.19
POT 902+78.35
POT 905+21.55
POT 907+29.09
POT 910+17.68
BM 187
U.S. Elev.
565.35
BM 188
U.S. Elev.
590.09
BM 185
U.S. Elev.
566.02
BM 186
U.S. Elev.
612.22
water course
16B
17A
VT GRID
SCALE
VERMONT DEPARTMENT OF HIGHWAYS
RIGHT-OF-WAY PLANS
PROJECT: SHARON - ROYALTON
NO. I 89-1(17)
SHEET 42 OF 45