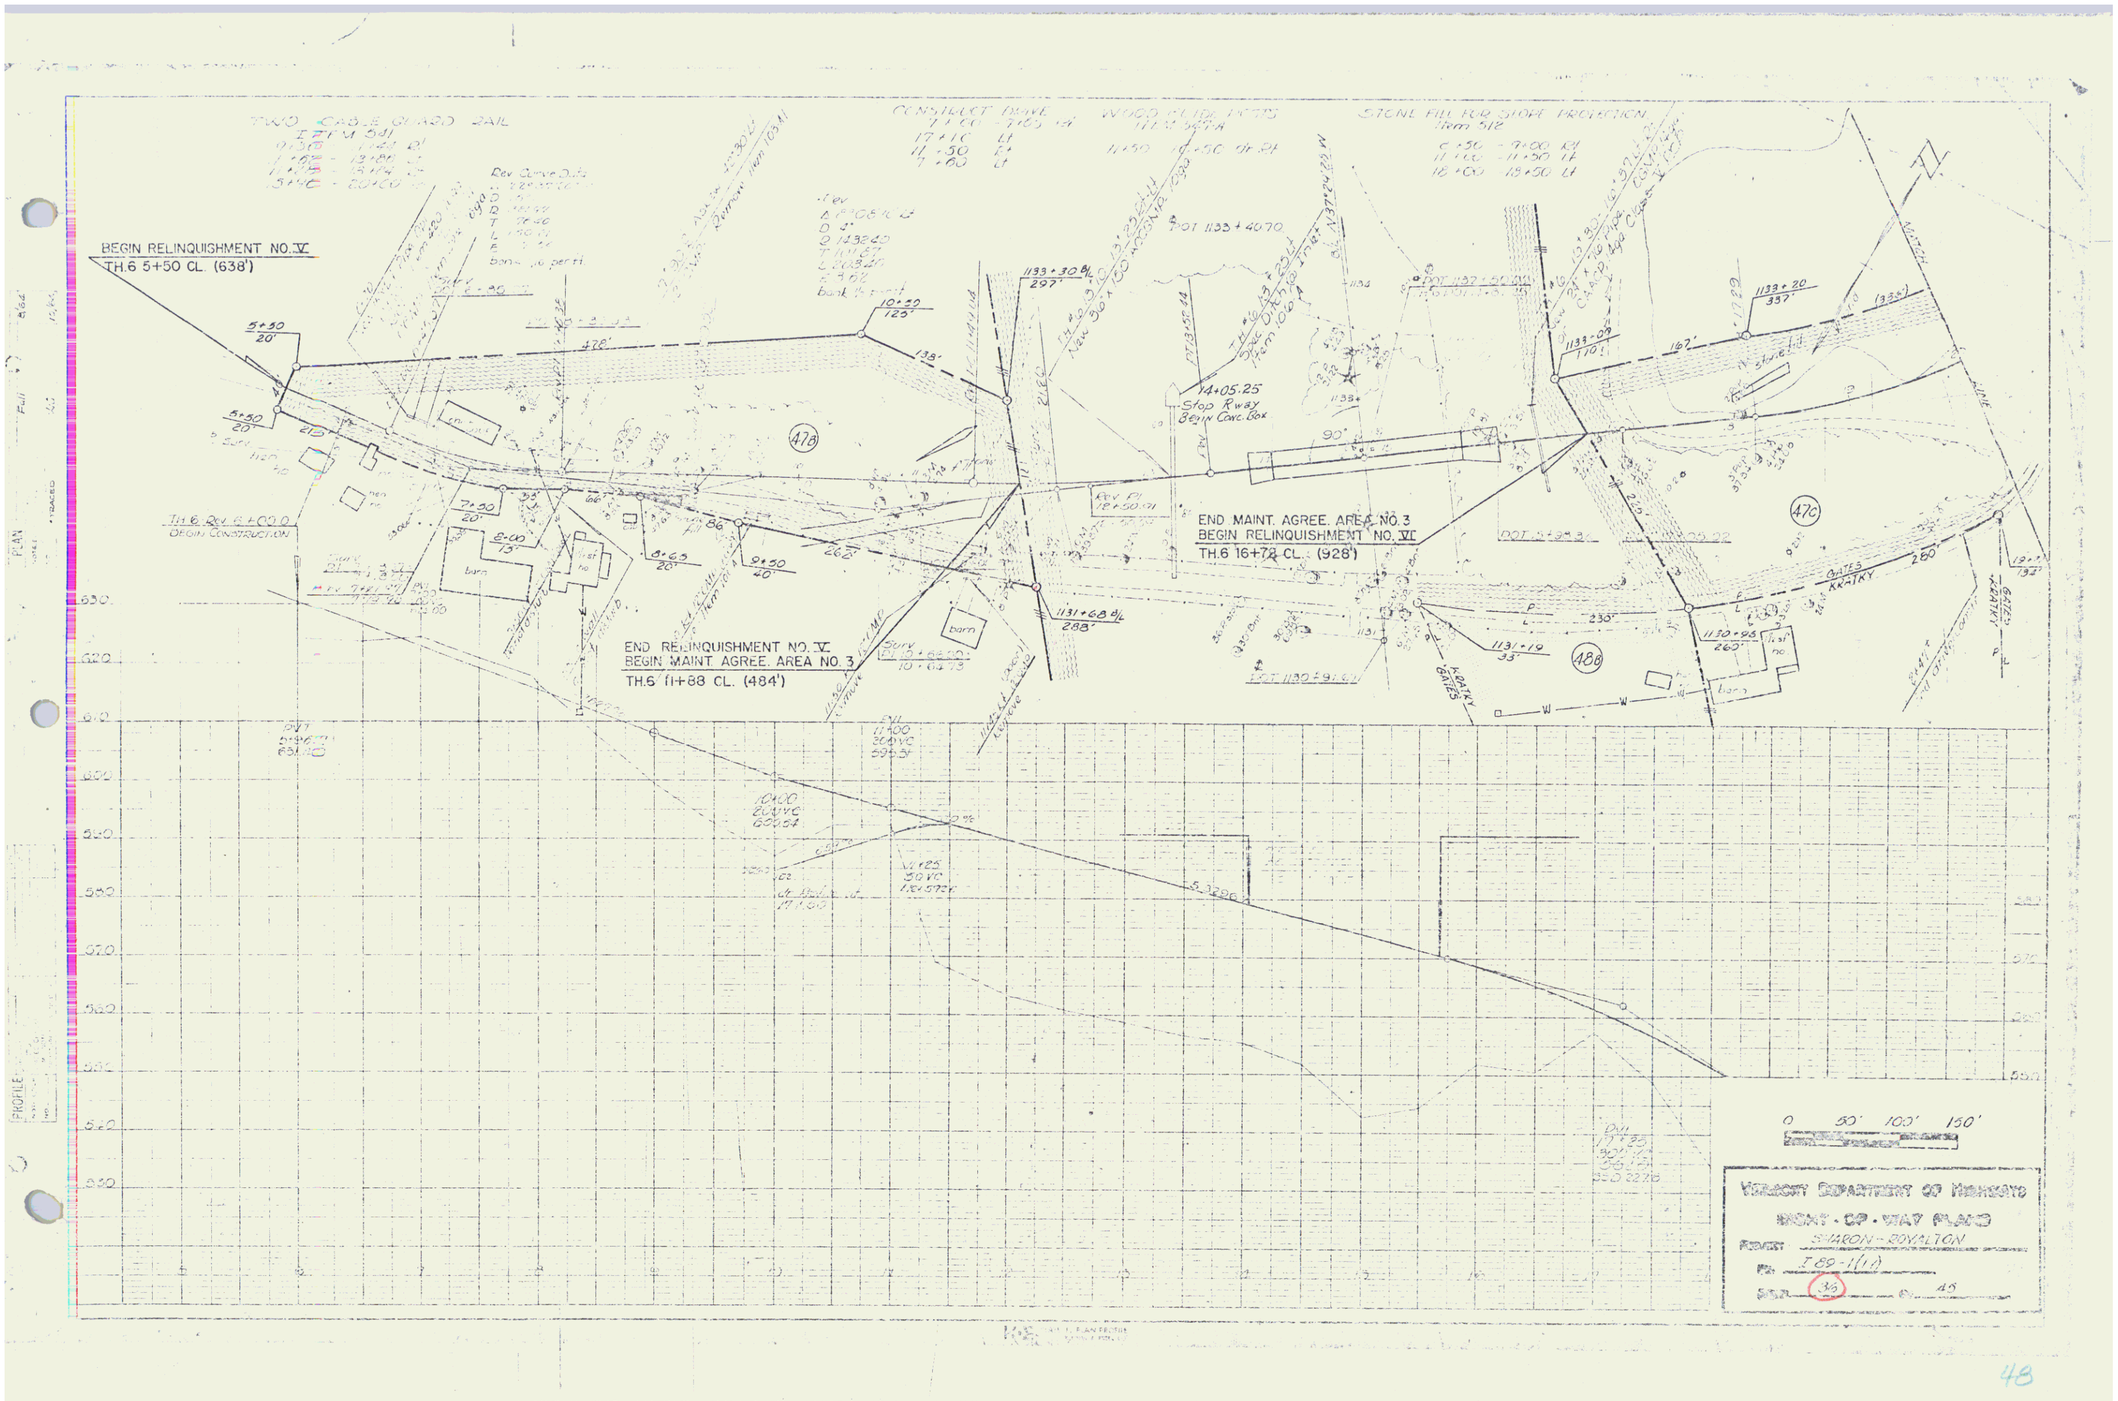
BEGIN RELINQUISHMENT NO. V
TH.6 5+50 CL. (638')
END RELINQUISHMENT NO. V
BEGIN MAINT. AGREE. AREA NO. 3
TH.6 11+88 CL. (484')
END MAINT. AGREE. AREA NO. 3
BEGIN RELINQUISHMENT NO. VI
TH.6 16+78 CL. (928')
TH.6 Rev. 6+00.0
BEGIN CONSTRUCTION
14+05.25
Stop R way
Begin Conc. Box
47B
47C
48B
barn
KNATKY
KNATKY GATES
0 50' 100' 150'
VERMONT DEPARTMENT OF HIGHWAYS
RIGHT-OF-WAY PLANS
PROJECT SHARON - ROYALTON
I 89-1(1)
PLAN 3/3 OF 48

48