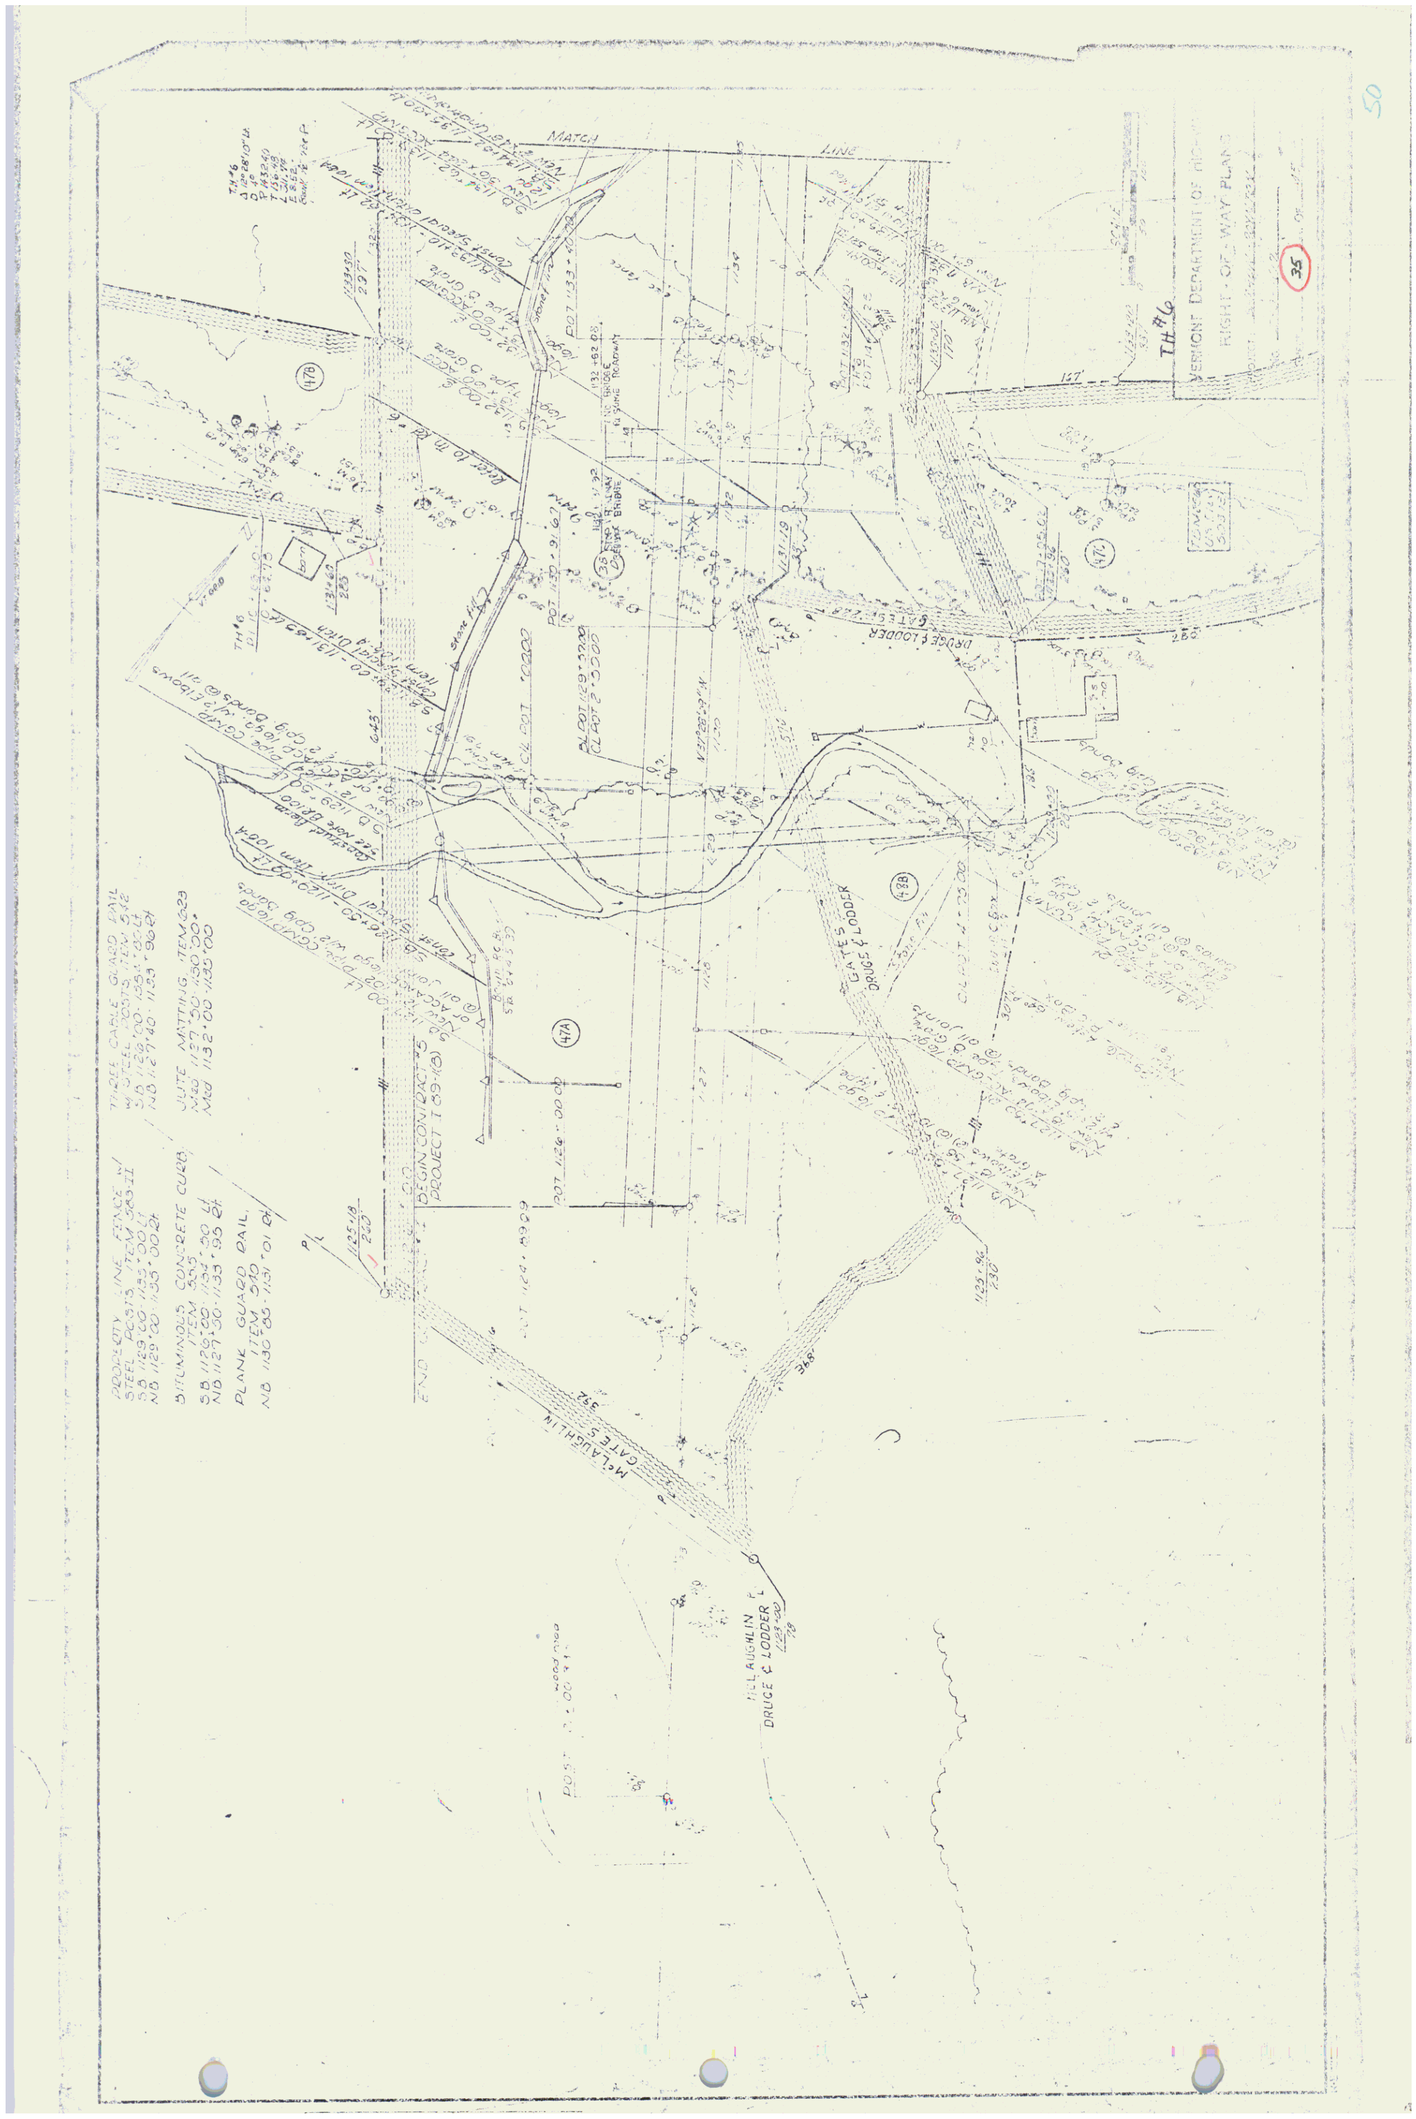
VERMONT DEPARTMENT OF HIGHWAYS
RIGHT-OF-WAY PLANS
TH #6
35
50
MATCH LINE
BEGIN CONTRACT
PROJECT T 69
END
GATES & LODDER
McLAUGHLIN
DRUGE & LODDER
PROPERTY LINE FENCE
STEEL POSTS, ITEM 960-11
BITUMINOUS CONCRETE CURB
ITEM 520
PLANK GUARD RAIL
ITEM 540
THREE CABLE GUARD RAIL
WOOD POSTS, ITEM 540-12
JUTE MATTING, ITEM 623