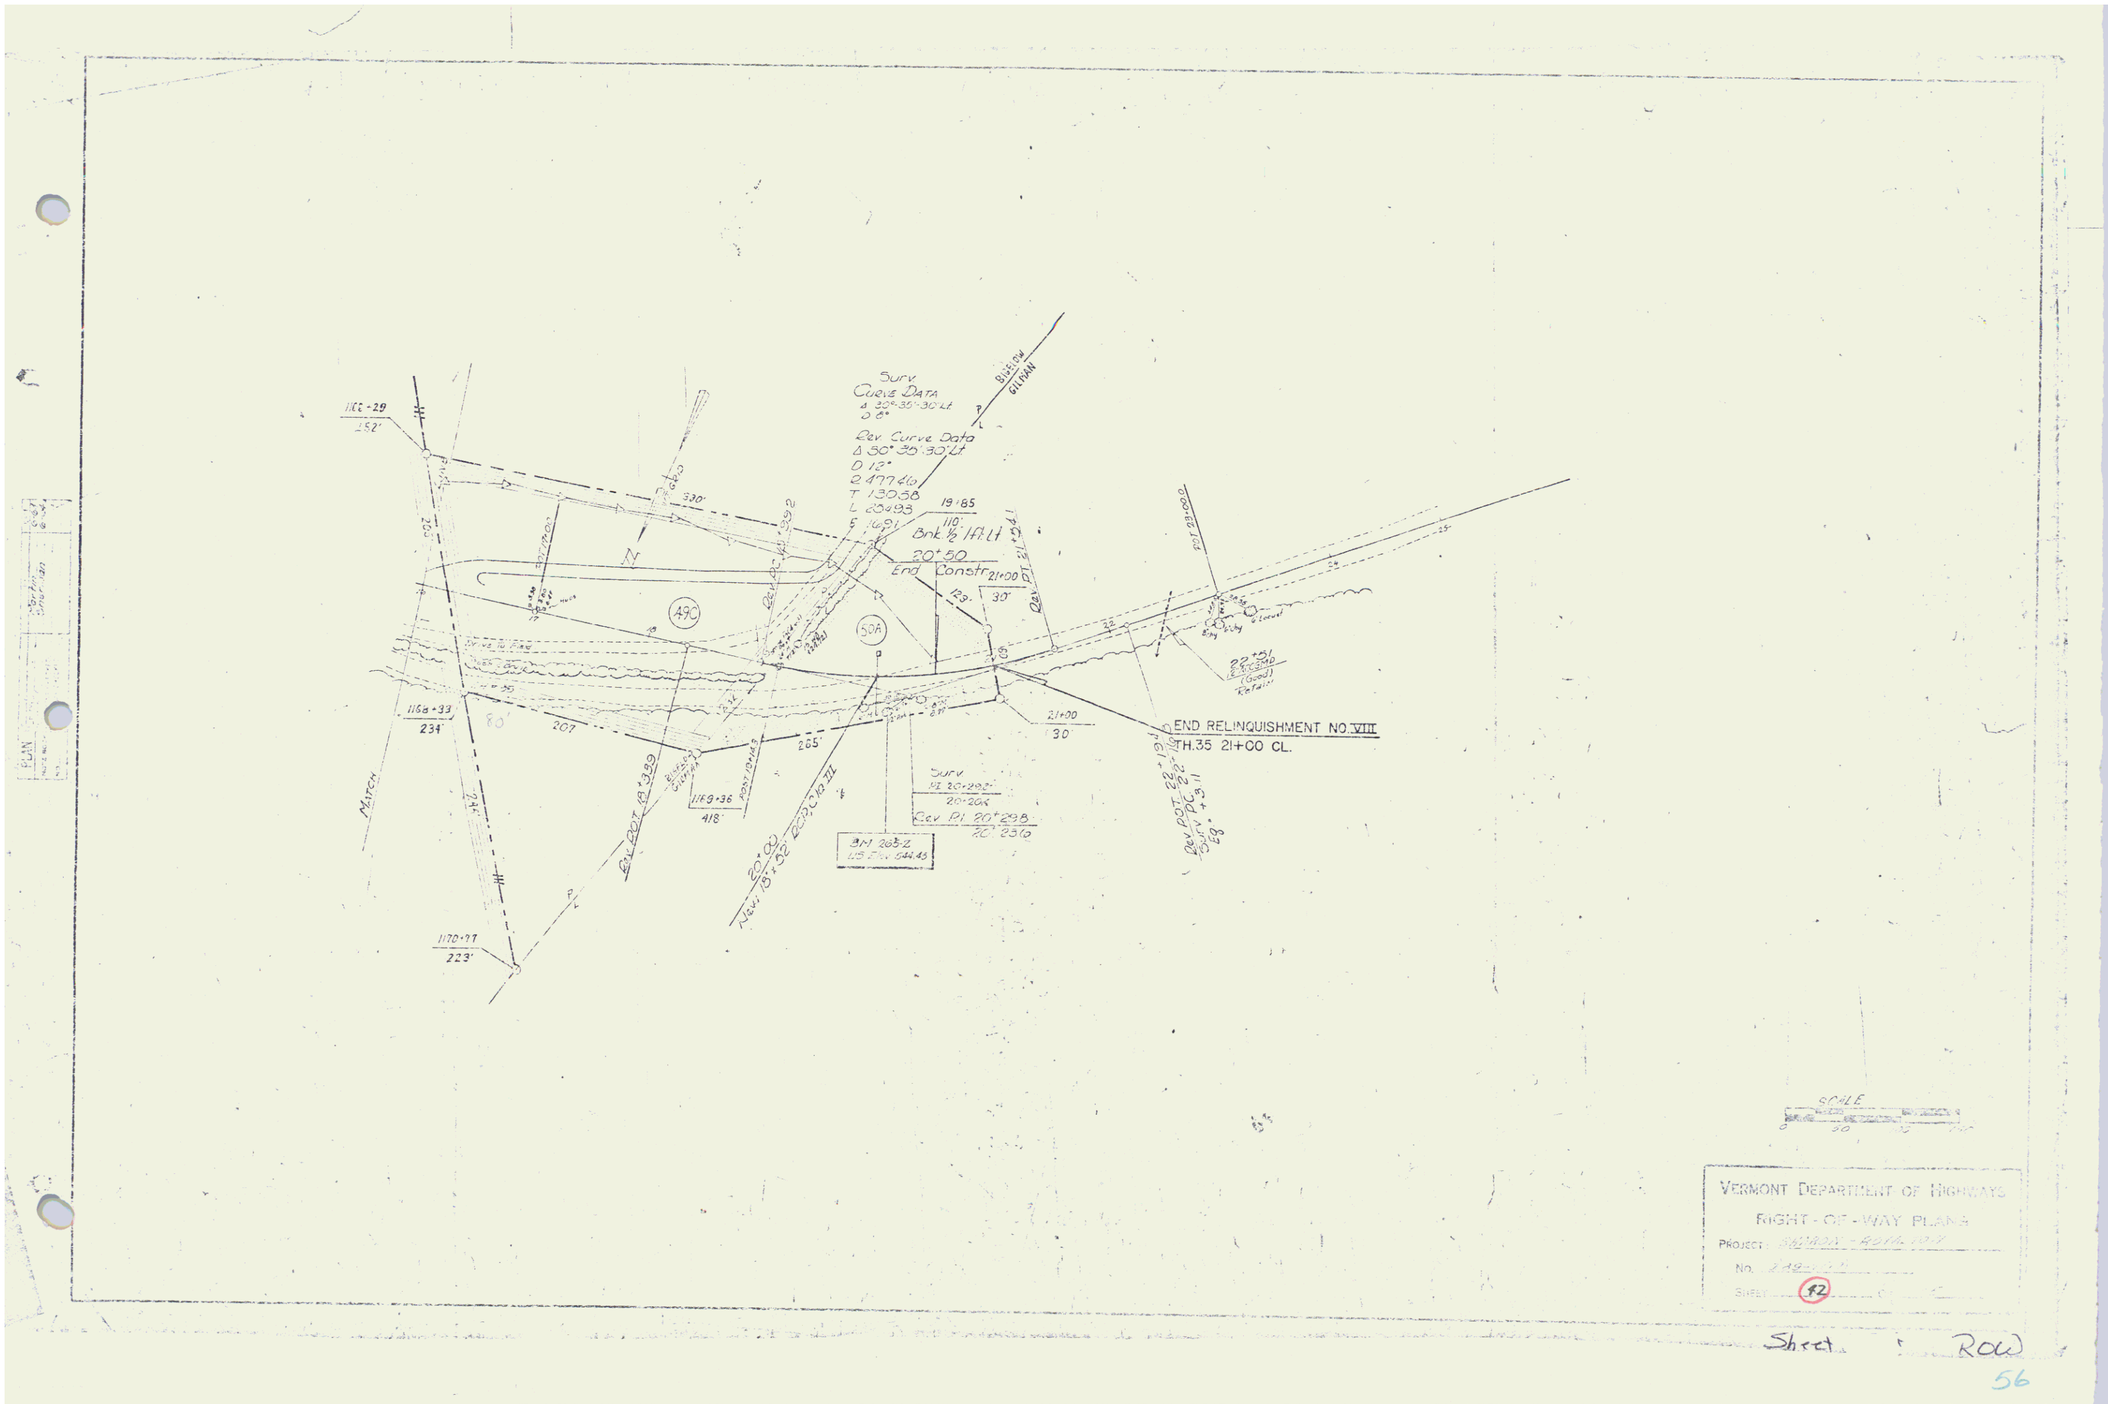
END RELINQUISHMENT NO. VIII
TH.35 21+00 CL.
SCALE
VERMONT DEPARTMENT OF HIGHWAYS
RIGHT-OF-WAY PLANS
PROJECT
NO.
SHEET
Sheet Row
56