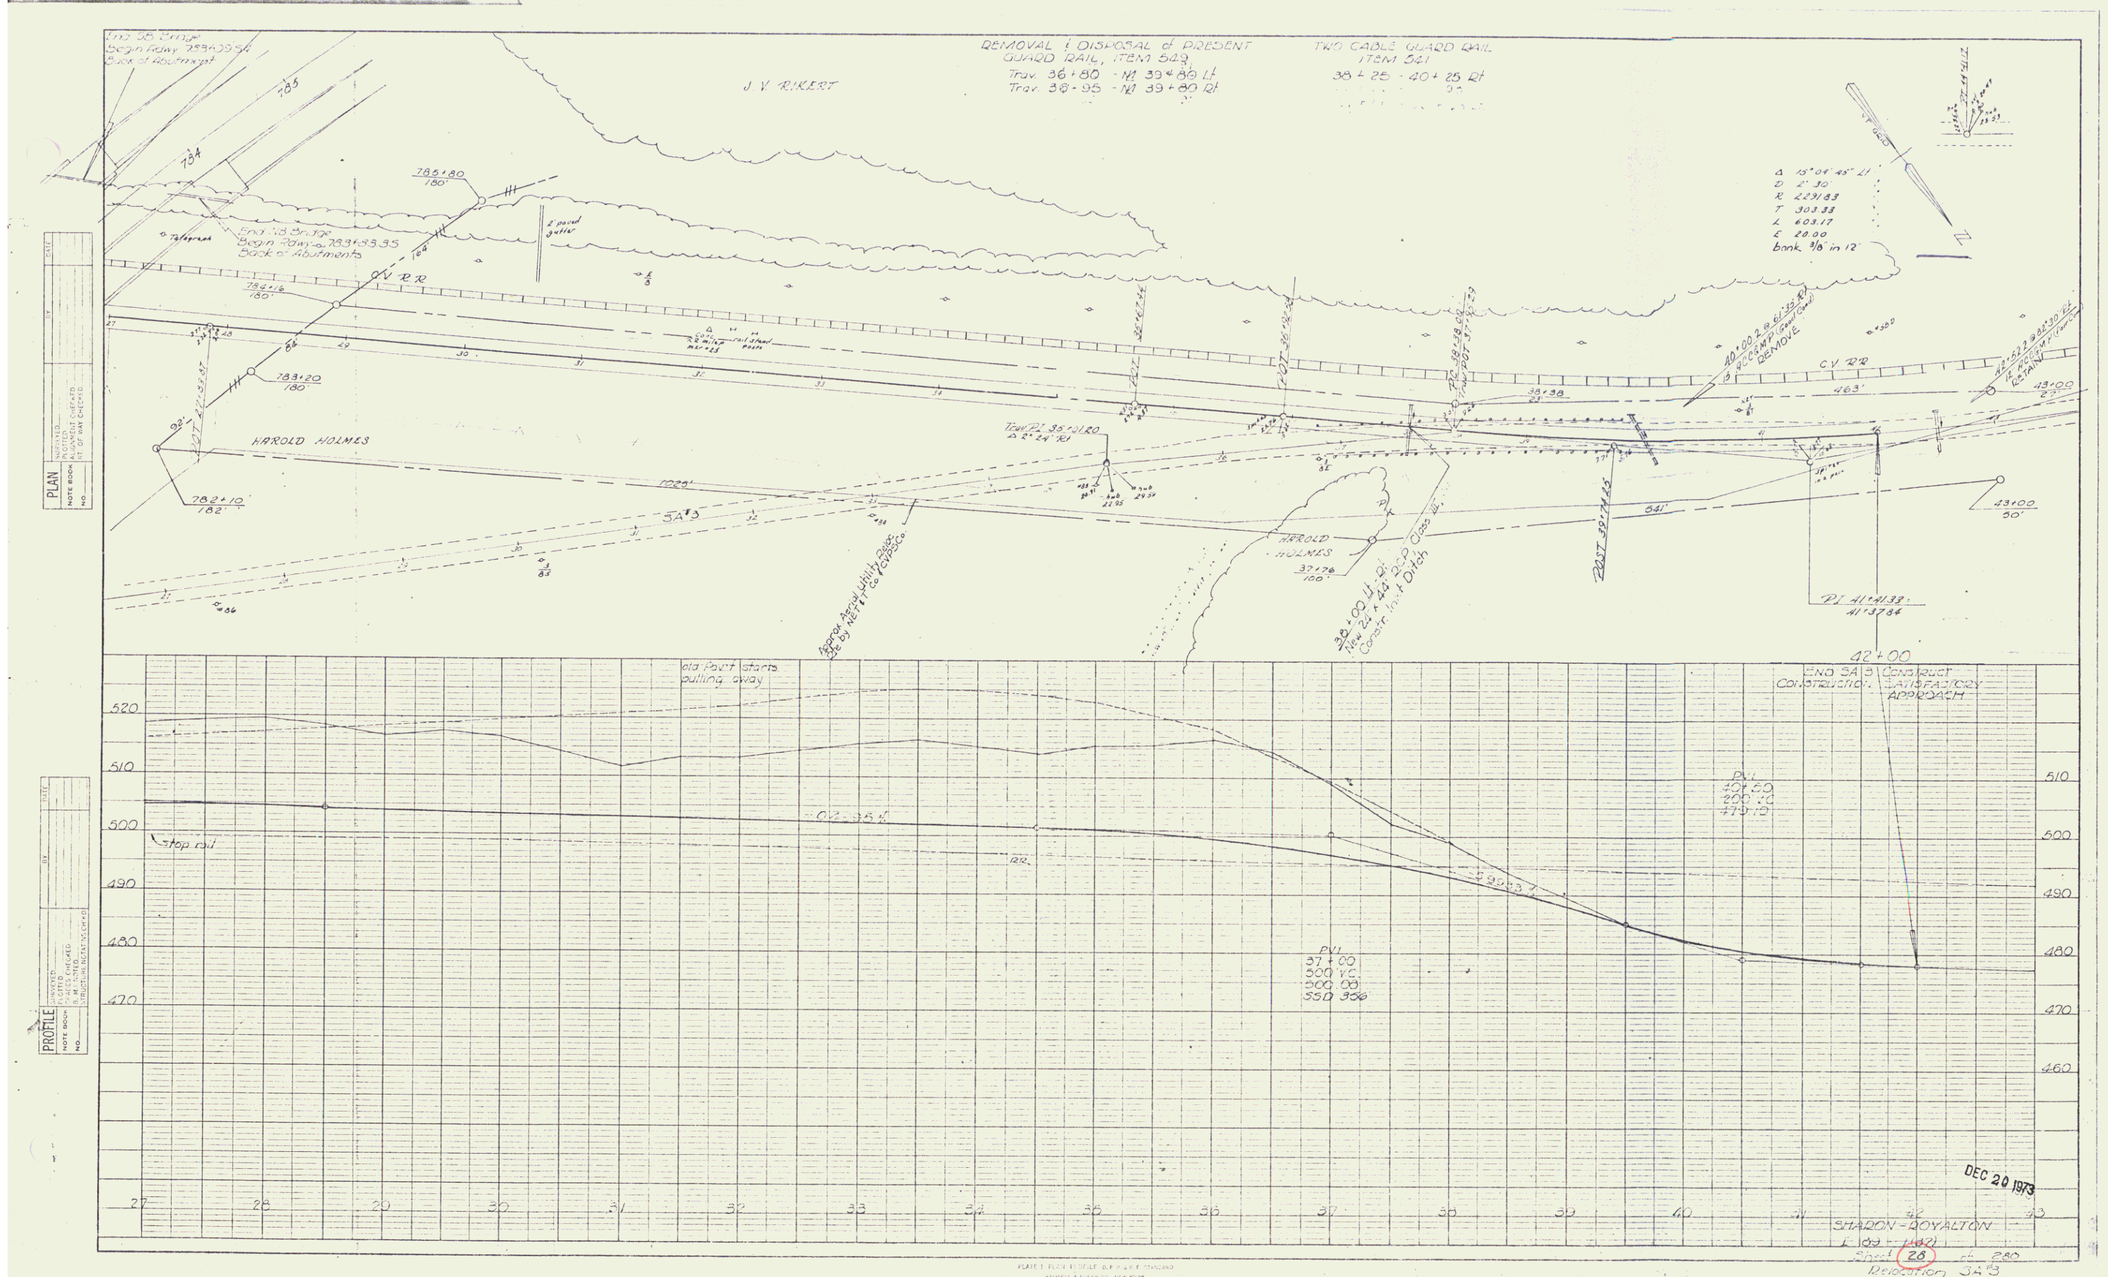
J. V. RIKERT
REMOVAL & DISPOSAL of PRESENT GUARD RAIL, ITEM 542
Trav. 36+80 - N1 39+80 Lt
Trav. 38+95 - N1 39+80 Rt
TWO CABLE GUARD RAIL ITEM 541
38+25 - 40+25 Rt
End 25 Bridge
Begin Rdwy 789+09.54
Back of Abutment
End 18 Bridge
Begin Rdwy 789+85.55
Back of Abutments
C V RR
HAROLD HOLMES
SA 3
Approx Aerial Utility Poles Re by NEPT & Co Tel Co
Old Road starts pulling away
Stop all
END SA 3 CONSTRUCTION
CONSTRUCT SATISFACTORY APPROACH
PVI 37+00 500 YC 900.00 550 356
PVI 40+50 400 YC 470.10
DEC 20 1973
SHARON - ROYALTON
Relocation SA 3
PLAN
PROFILE
72