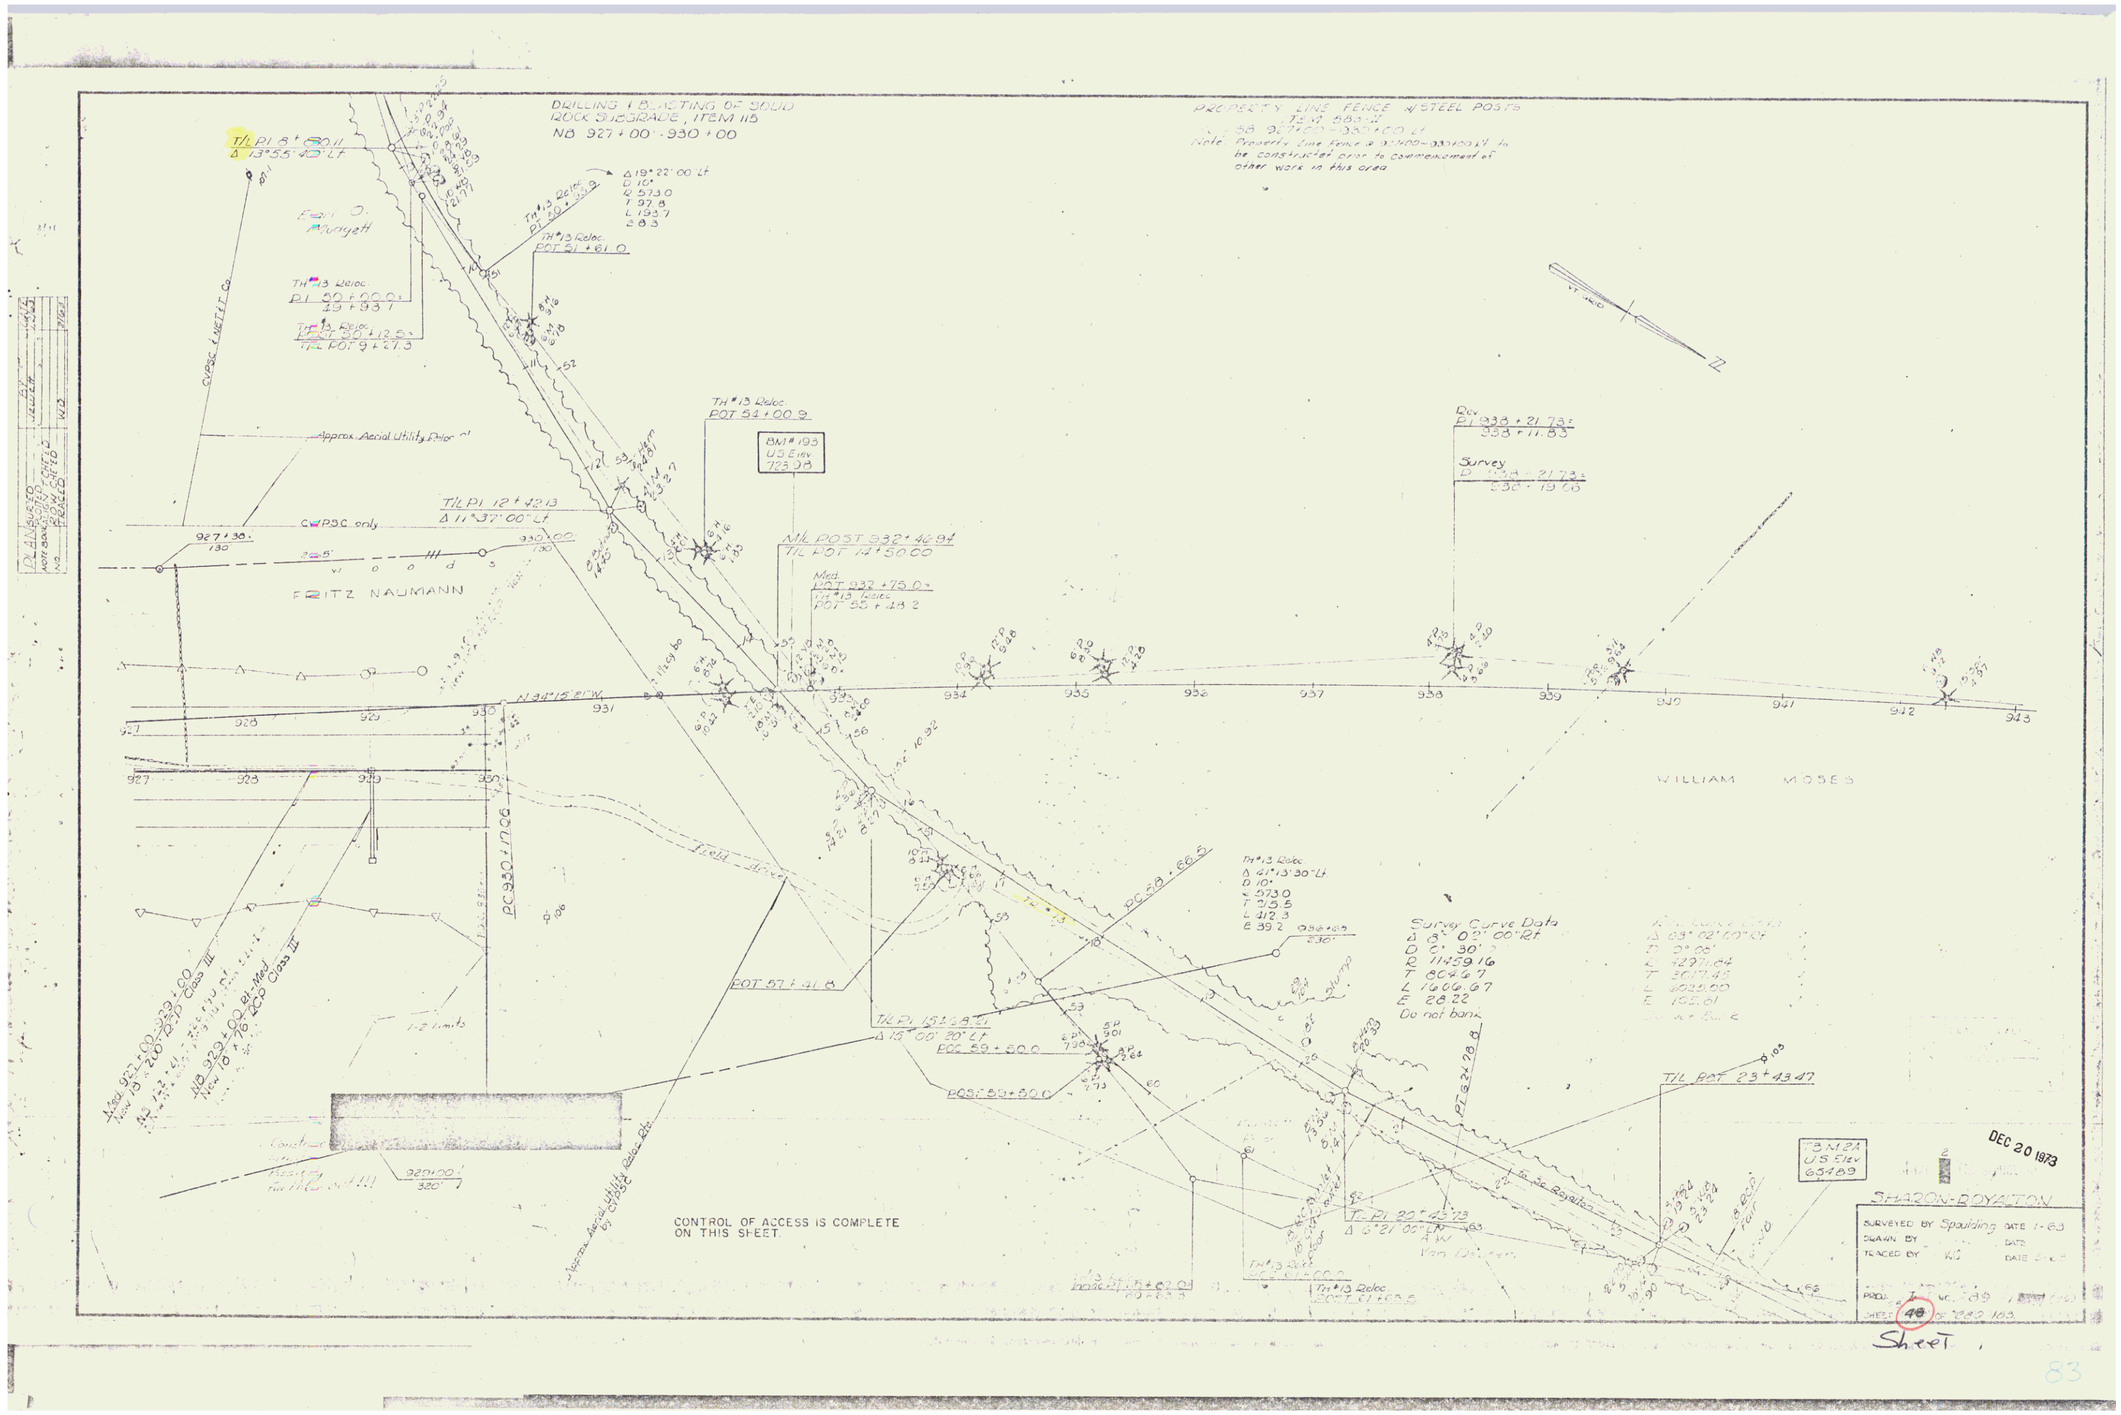
DRILLING & BLASTING OF SOLID ROCK SUBGRADE, ITEM 115
NB 927+00 - 930+00
PROPERTY LINE FENCE W/STEEL POSTS
Note: Property line fence @ 931+00-933+50 Lt to be constructed prior to commencement of other work in this area
T/L PI 8+80.11
Δ 13°55'45" Lt
Δ 19°22'00" Lt
D 10°
R 573.0
T 97.8
L 193.7
E 8.3
TH #13 Reloc.
POT 51+61.0
TH #13 Reloc.
PI 50+00.0±
49+93.7
TH #13 Reloc.
POT 50+12.5±
T/L POT 9+27.3
Approx. Aerial Utility Poles
T/L PI 12+42.13
Δ 11°37'00" Lt
CWP&C only
927+38±
130
930+00
FRITZ NAUMANN
TH #13 Reloc.
POT 54+00.9
BM #195
US Elev
723.93
N/L POST 932+46.94
T/L POT 12+50.00
Med.
POT 932+75.0±
TH #13 Reloc.
POT 55+48.2
Survey
PI 938+21.73±
938+11.83
Survey
PI 938+21.73±
938+19.68
WILLIAM MOSES
N 34°15' 21" W
927
928
929
930
931
932
933
934
935
936
937
938
939
940
941
942
943
PC 930+17.06
TH #13 Reloc.
Δ 21°13'30" Lt
D 10°
R 573.0
T 95.5
L 212.3
E 39.2
PC 58+66.5
Survey Curve Data
Δ 8° 02' 00" Rt
D 0° 30'
R 11459.16
T 804.67
L 1606.67
E 28.22
Do not bank
POT 57+41.8
T/L PI 15+68.01
Δ 15° 00' 20" Lt
POC 59+50.0
POC 59+50.0
PI 62+78.8
T/L POT 23+43.47
TB M2A
US Elev
DEC 20 1973
T/L PI 20+45.73
Δ 6°21' 00" Rt
SURVEYED BY Spaulding DATE 1-63
DRAWN BY DATE
TRACED BY WJ DATE
PROJ. NO. 89
CONTROL OF ACCESS IS COMPLETE ON THIS SHEET.

Sheet