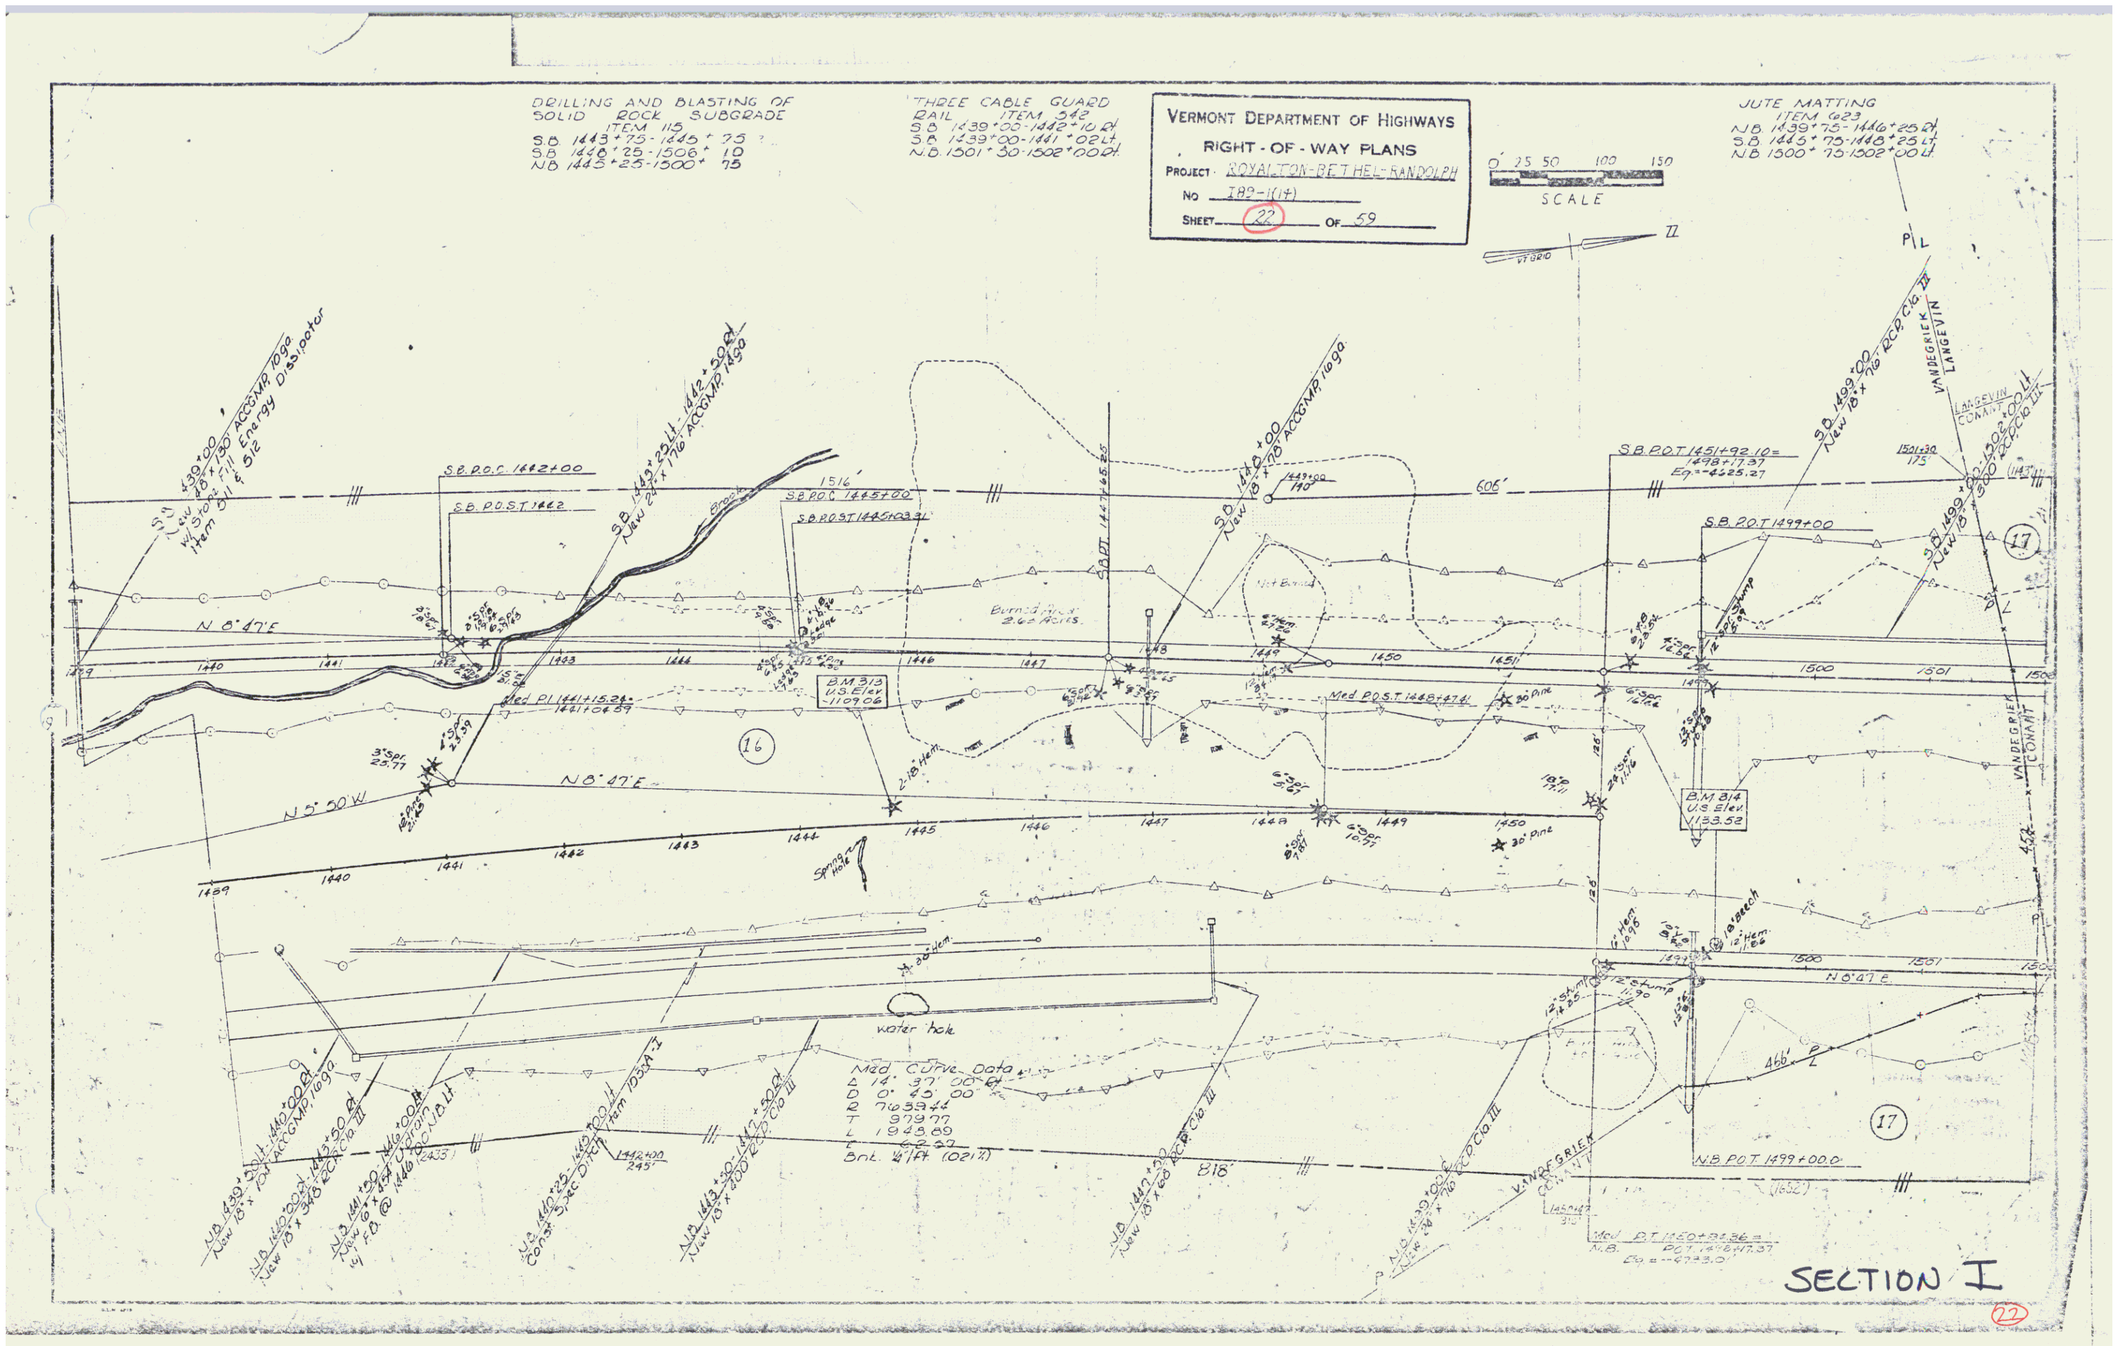
VERMONT DEPARTMENT OF HIGHWAYS
RIGHT - OF - WAY PLANS
PROJECT ROYALTON-BETHEL-RANDOLPH
NO IBP-1(14)
SHEET 22 OF 59
SCALE
DRILLING AND BLASTING OF SOLID ROCK SUBGRADE ITEM 115
S.B. 1443+75-1445+75
S.B. 1446+25-1506+10
N.B. 1445+25-1500+75
THREE CABLE GUARD RAIL ITEM 542
S.B. 1439+00-1442+10 Rt
S.B. 1439+00-1441+02 Lt
N.B. 1501+30-1502+00 Rt
JUTE MATTING ITEM 623
N.B. 1439+75-1446+25 Rt
S.B. 1445+75-1448+25 Lt
N.B. 1500+75-1502+00 Lt
N 8° 47' E
N 5° 50' W
water hole
Med. Curve Data
Δ 14° 37' 00" Rt
D 0° 45' 00"
R 7639.44
T 979.77
E 62.27
Bnt. 1/4 Ft (0217)
N.B. P.O.T. 1499+00.0
SECTION I