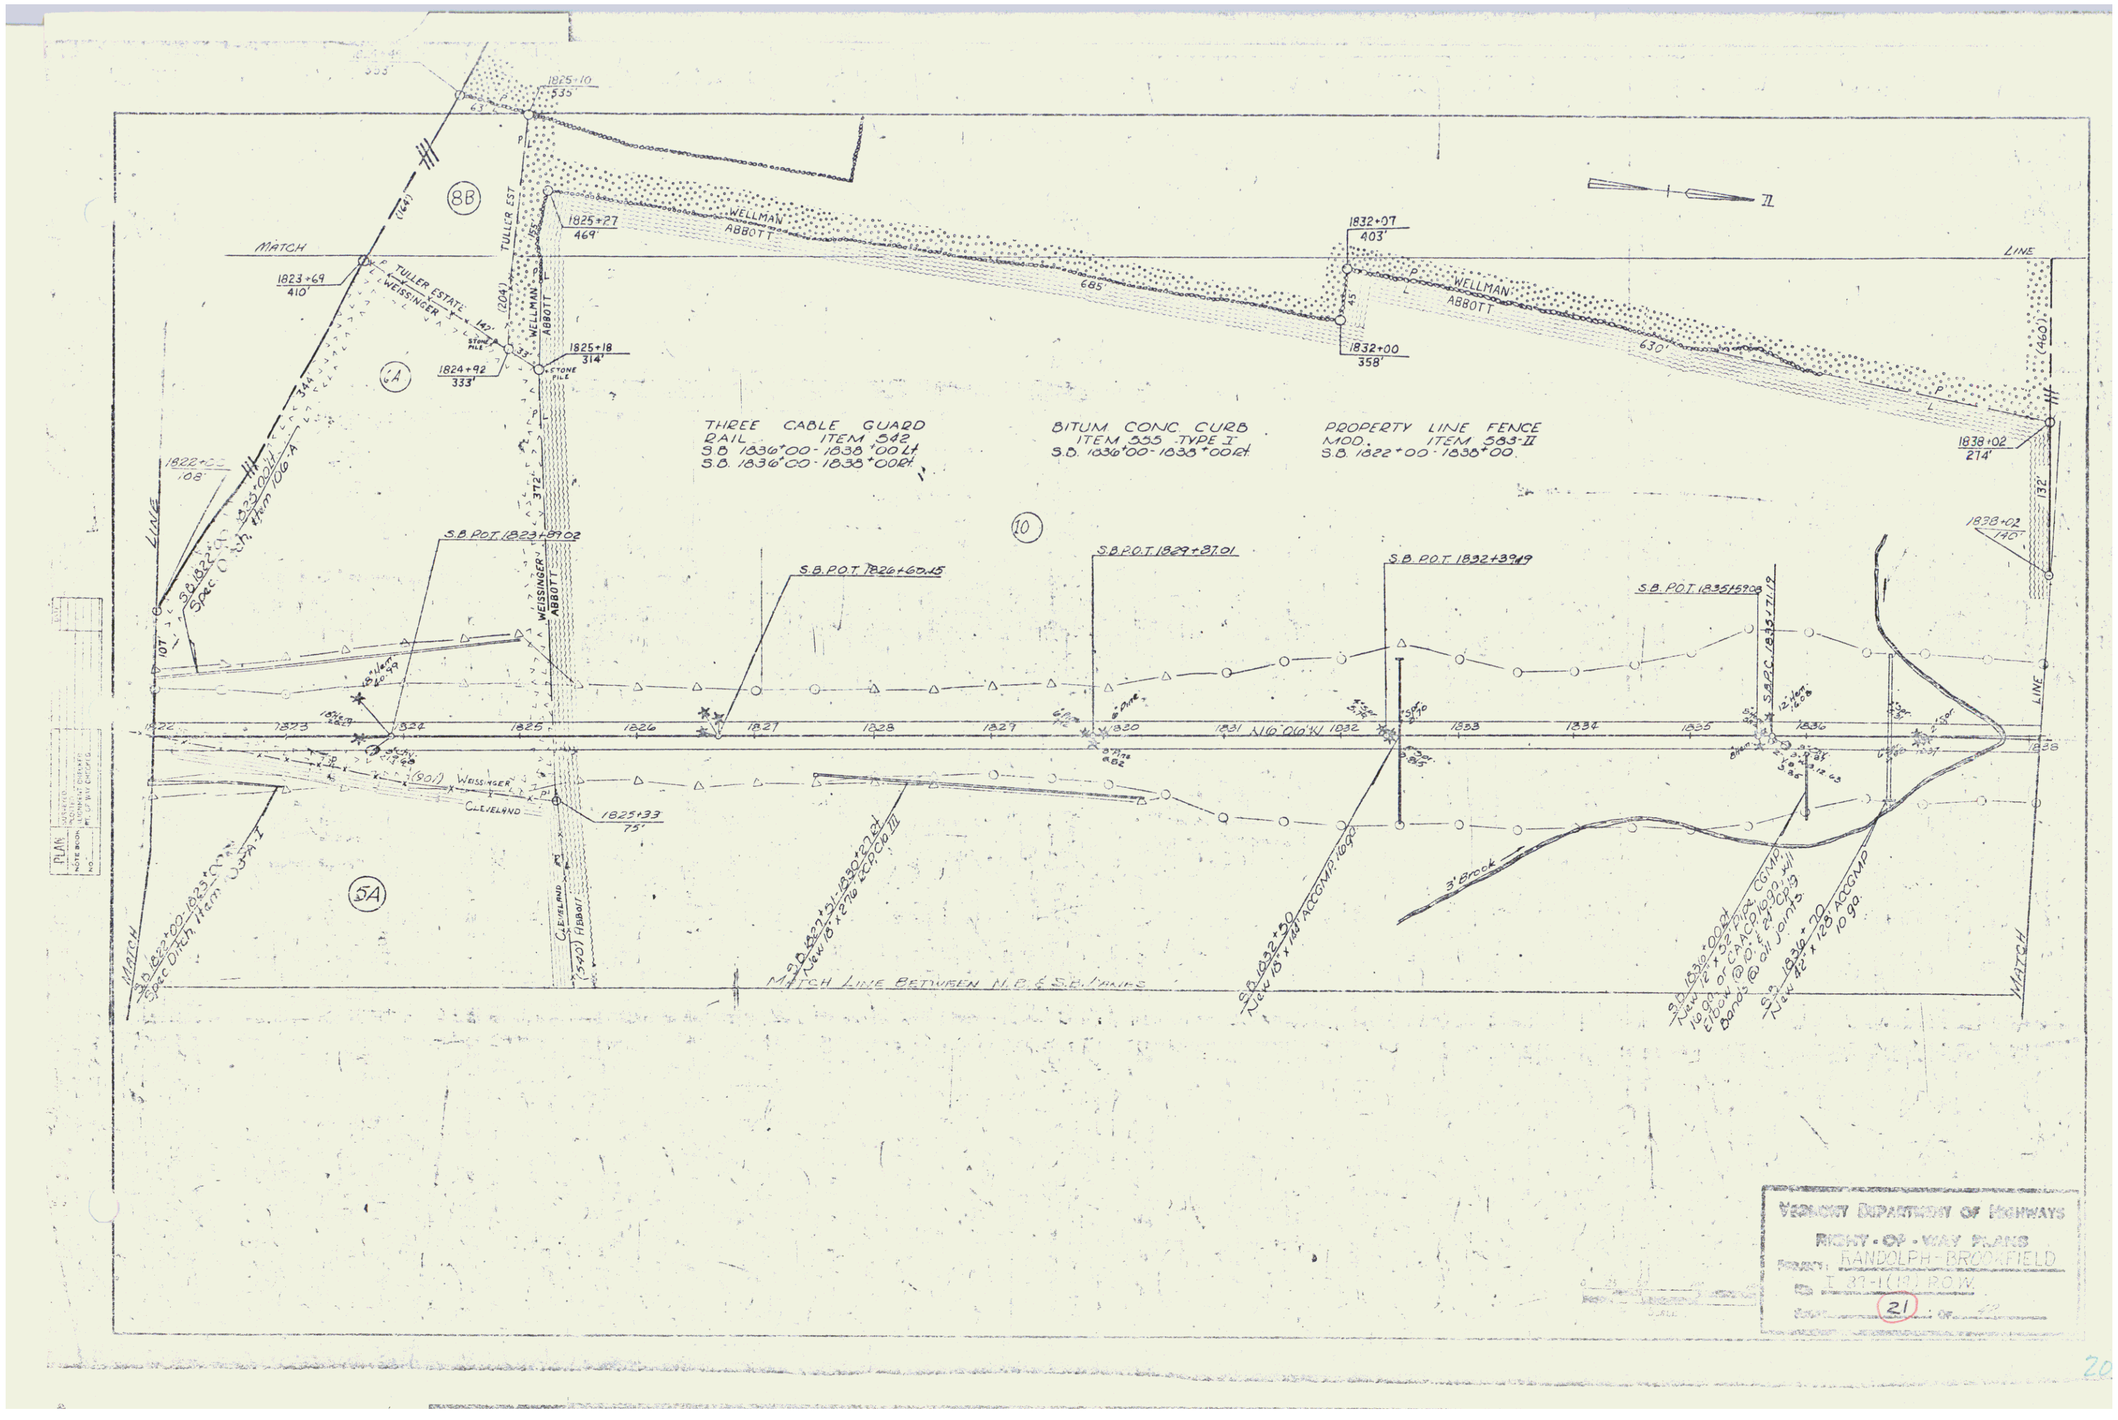
MATCH
LINE
TULLER EST.
TULLER ESTATE
WEISSINGER
WELLMAN
ABBOTT
CLEVELAND
THREE CABLE GUARD RAIL ITEM 542
S.B. 1836+00-1838+00 Lt
S.B. 1836+00-1838+00 Rt
BITUM CONC CURB ITEM 555 TYPE I
S.B. 1836+00-1838+00 Rt
PROPERTY LINE FENCE MOD. ITEM 583-II
S.B. 1822+00-1836+00.
S.B. P.O.T. 1823+87.02
S.B. P.O.T. 1826+60.15
S.B. P.O.T. 1829+87.01
S.B. P.O.T. 1832+39.19
S.B. P.O.T. 1835+59.06
MATCH LINE BETWEEN N.B. & S.B. PLANS
3' Brook
VERMONT DEPARTMENT OF HIGHWAYS
RIGHT-OF-WAY PLANS
RANDOLPH - BROOKFIELD
21