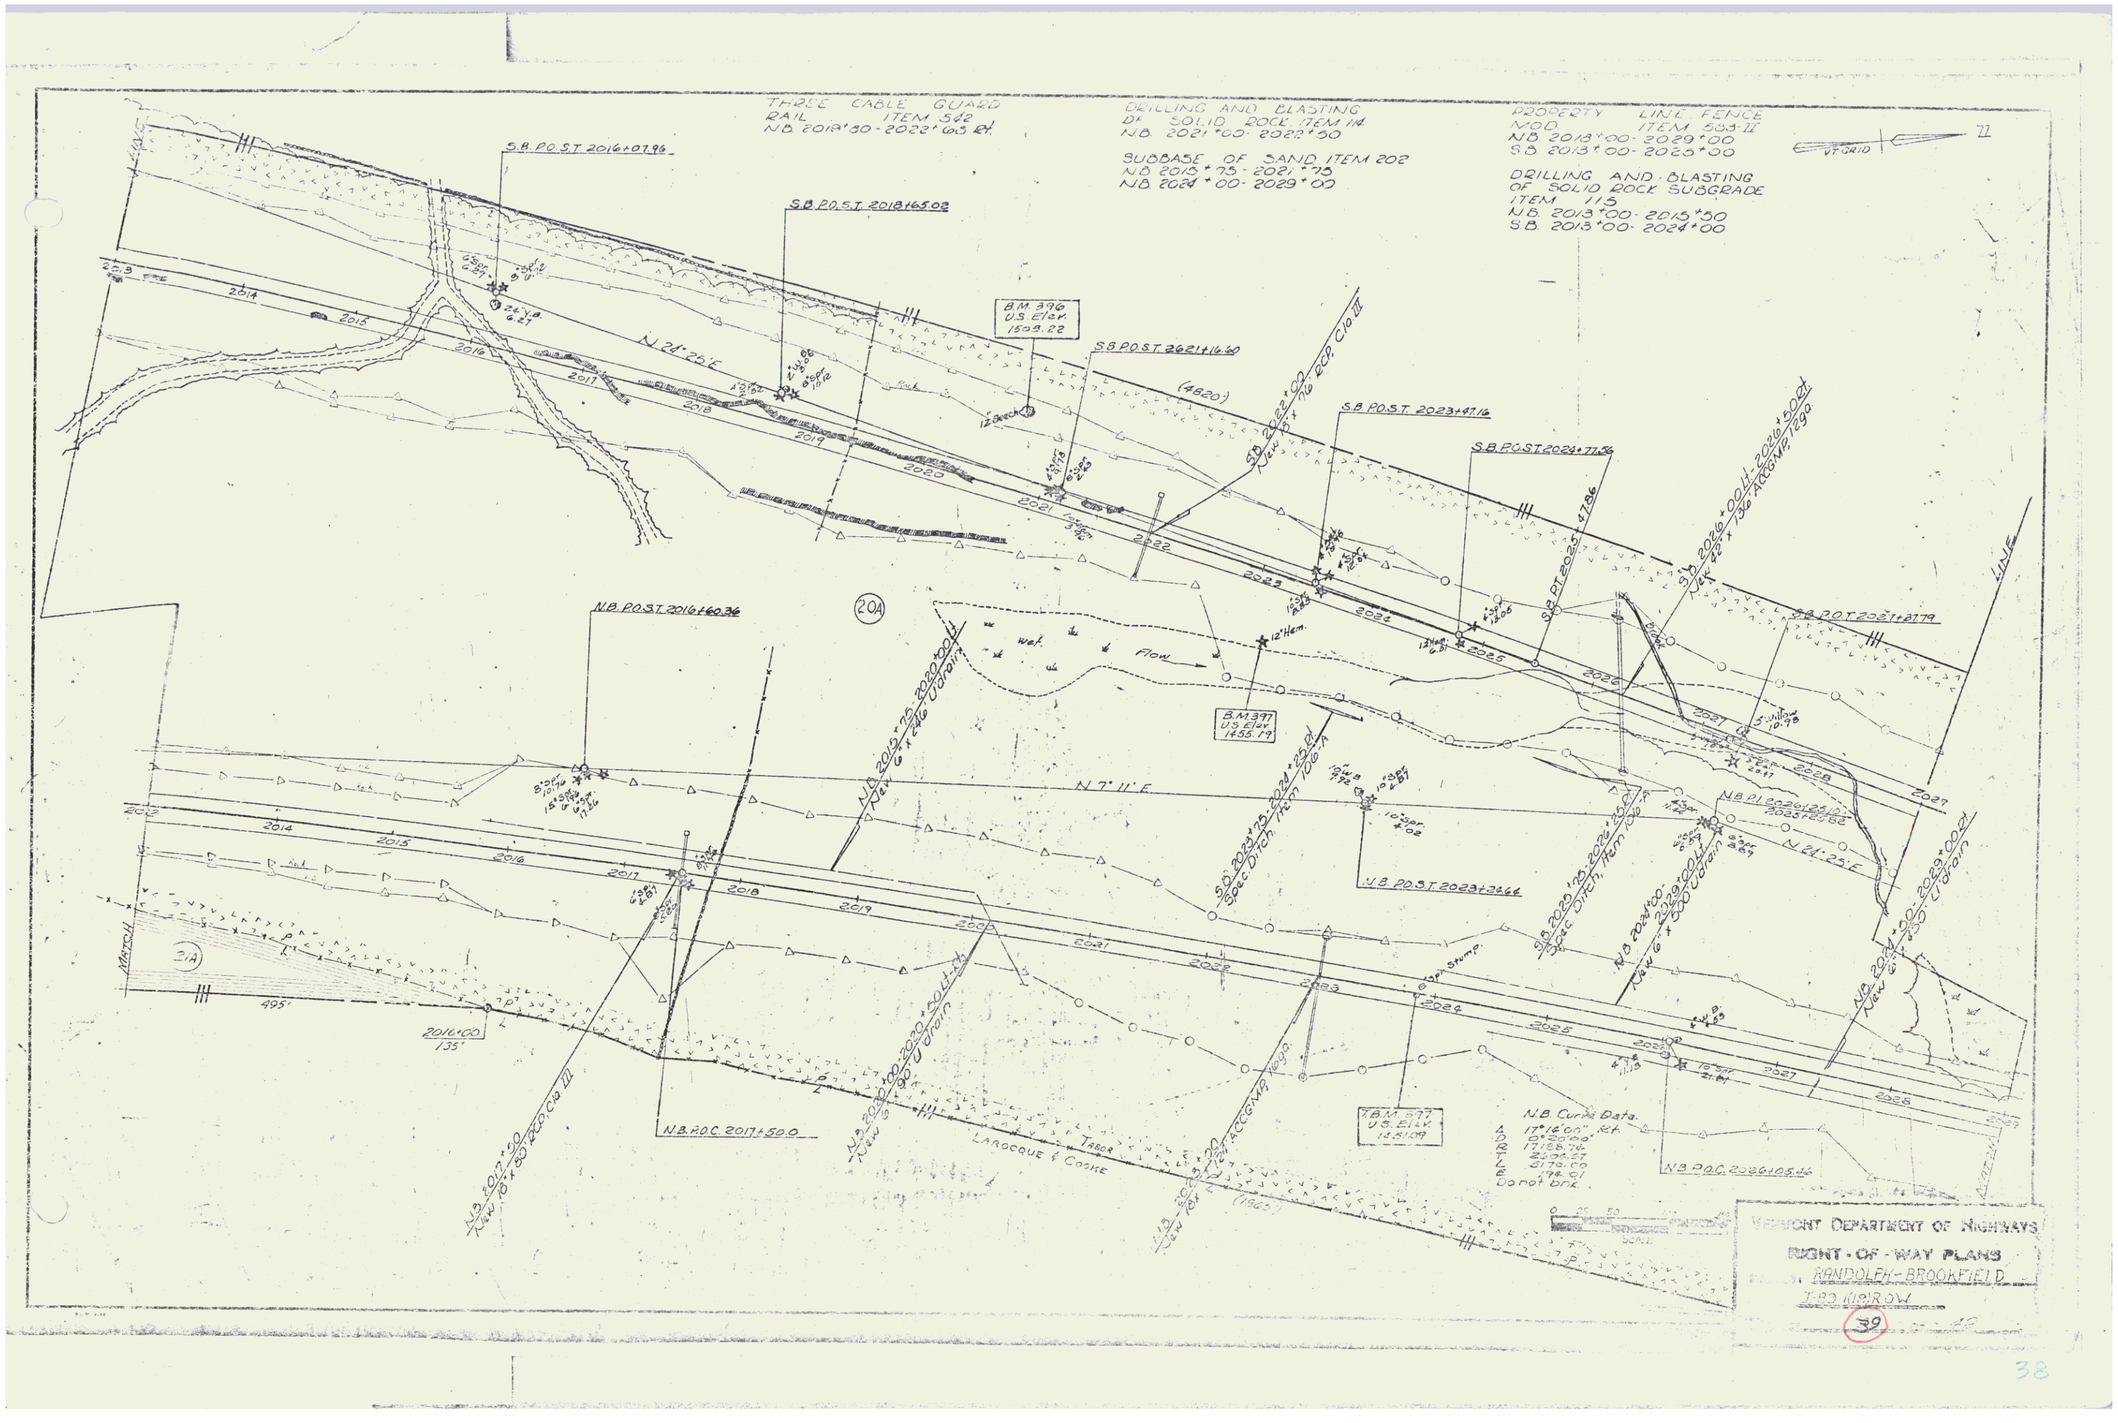
THREE CABLE GUARD RAIL ITEM 542
N.B. 2018+50 - 2022+00 Rt.
DRILLING AND BLASTING DI SOLID ROCK ITEM 114
N.B. 2021+00 - 2022+50
SUBBASE OF SAND ITEM 202
N.B. 2018+75 - 2021+75
N.B. 2024+00 - 2029+00
PROPERTY LINE FENCE
N.O.D. ITEM 613-11
N.B. 2018+00 - 2029+00
S.B. 2018+00 - 2029+00
DRILLING AND BLASTING OF SOLID ROCK SUBGRADE
ITEM 115
N.B. 2018+00 - 2015+50
S.B. 2018+00 - 2024+00
VT GRID
S.B. P.O.S.T. 2016+07.96
S.B. P.O.S.T. 2018+65.02
B.M. 396 U.S. Elev. 1509.22
S.B. P.O.S.T. 2021+16.60
S.B. P.O.S.T. 2023+07.16
S.B. P.O.S.T. 2024+77.36
S.B. P.O.S.T. 2027+81.79
N.B. P.O.S.T. 2016+60.36
B.M. 397 U.S. Elev. 1455.19
N.B. P.O.S.T. 2023+25.66
B.M. 397 U.S. Elev. 1458.09
N.B. P.O.C. 2017+50.0
N.B. P.O.C. 2026+05.46
N 24°-25' E
N 7° 11' E
Water Flow
Stump
LAROCQUE & COSKE
TABOR
N.B. Curve Data
Δ 17°16'00" Rt.
D 6°20'00"
R 1788.76
T 272.27
L 539.00
E 18.91
Do not bnk.
VERMONT DEPARTMENT OF HIGHWAYS
RIGHT-OF-WAY PLANS
RANDOLPH - BROOKFIELD
I-89 (100' R.O.W.)
39