* DENOTES STAGE 2 ITEMS

* Three Cable Guard Rail w/Steel Posts Item 542
NB 2140+02 – 2142+00 Rt.
NB 2140+97 – 2142+00 Lt.
SB 2130+96 – 2142+00 Rt.
SB 2139+52 – 2142+00 Lt.

PROPERTY LINE FENCE WITH STEEL POSTS ITEM 583-5 MOD		
STA	STA	SDE
NORTHBOUND		
2128+00	2142+00	RT.
SOUTHBOUND		
2128+00	2142+00	LT.

Construct U-Turn, Medium Opening
Rt. 2138+50 – 15' Lt.
SB 2138+50 – 12' Rt.

Drilling to Blasting of Solid Rock Subgrade, Item 115
SB 2128+00 – 2137+50
NB 2127+00 – 2135+50

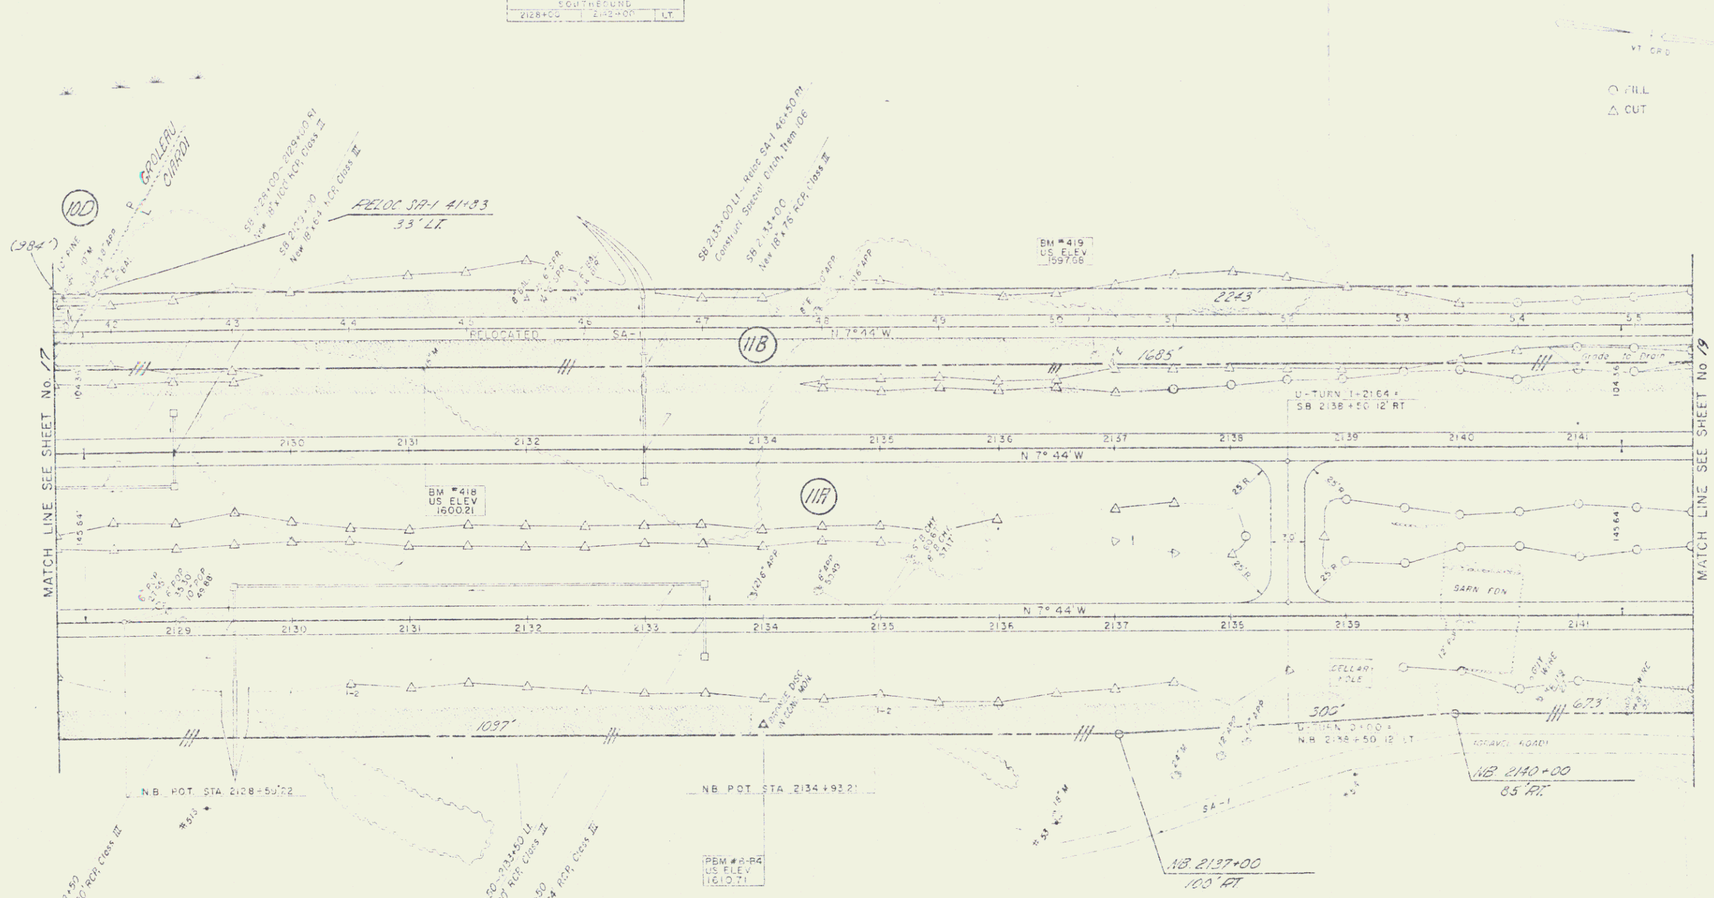

FOR PLAN AND PROFILE OF RELOCATED SA-1 SEE SHEETS 40-49 OF 406

CONTROL OF ACCESS IS COMPLETE ON THIS SHEET EXCEPT FOR RELOCATED SA-1 STA. 41+50 TO 55+50 (LT.)

PORTER, PUBLICK & ARMSTRONG
CONSULTING ENGINEERS, BOSTON, MASS.

BROOKFIELD-WILLIAMSTOWN
BERLIN
I 89-1 (20)
SECTION NO. I
SHEET 18 OF 90

16