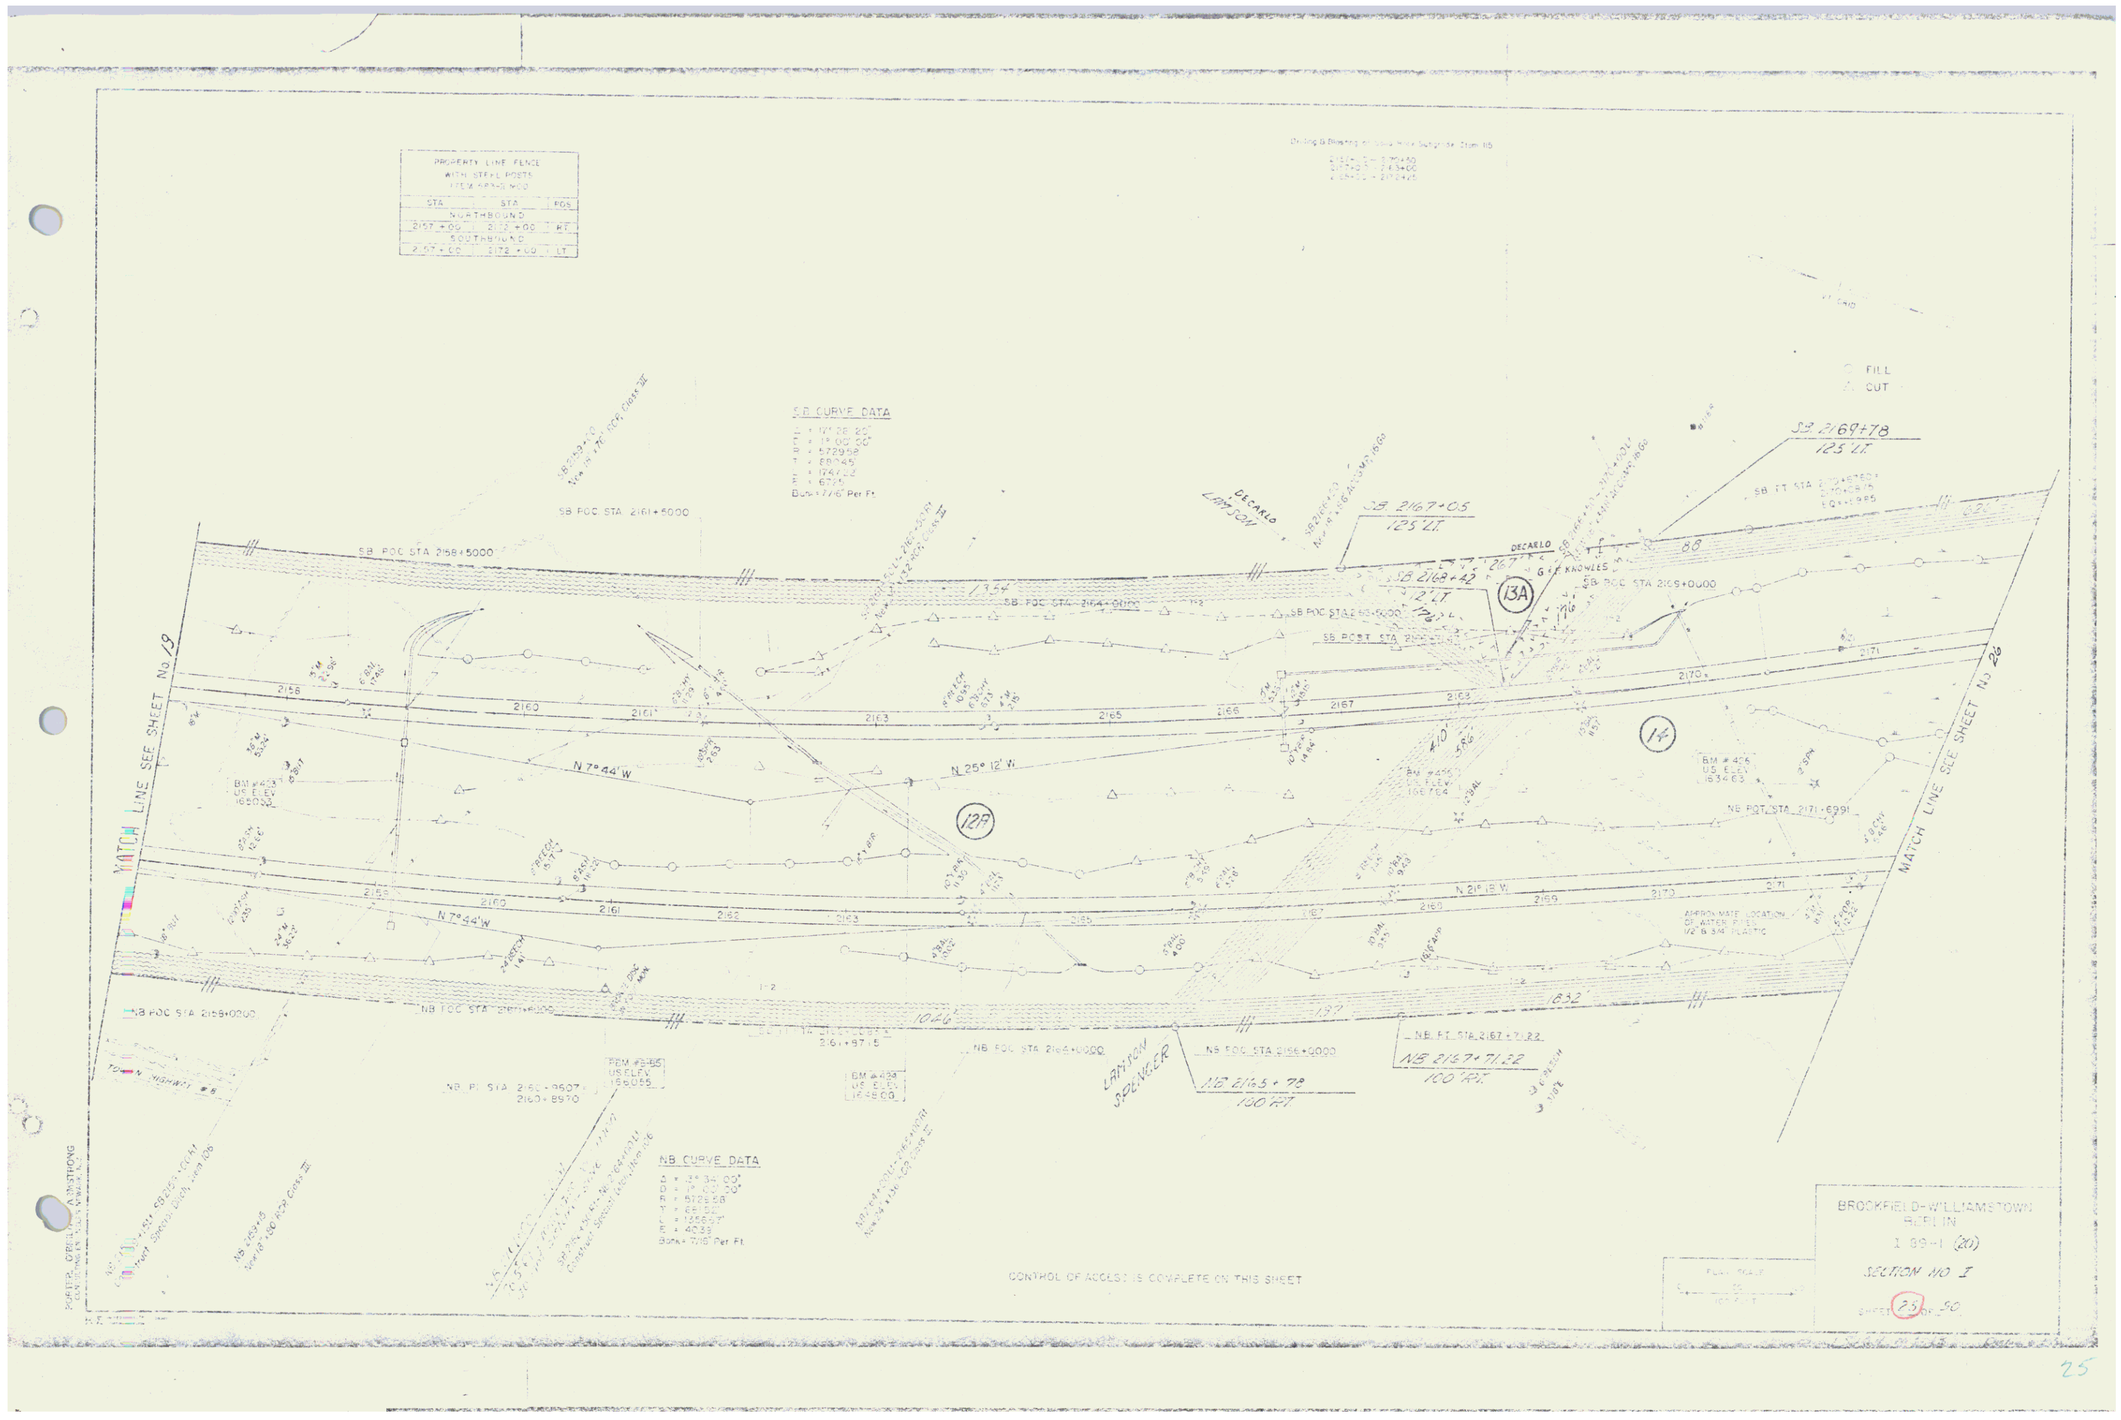
PROPERTY LINE FENCE
WITH STAYL POSTS
(TEM #P43-W10)
STA STA FOS
NORTHBOUND
2157+00 2173+00 RT
SOUTHBOUND
2157+00 2172+00 LT
S.B. CURVE DATA
Δ = 17° 28' 22"
Base = 7/16" Per Ft.
FILL
CUT
SB 2169+78
125 LT.
SB 2167+05
125 LT.
SB 2168+42
2 LT
DECARLO
G & E KNOWLES
SB POC STA 2158+5000
SB POC STA 2161+5000
SB POC STA 2164+0000
SB POC STA 2169+0000
SB POST STA 2171+6991
1354'
1026'
832'
N 7° 44' W
N 25° 12' W
N 21° 18' W
MATCH LINE SEE SHEET No 26
BM #423
US ELEV
165032
BM #426
US ELEV
163463
APPROXIMATE LOCATION
OF WATER PIPE
1/2" & 3/4" PLASTIC
NB POC STA 2168+0000
NB POC STA 2164+0000
NB POC STA 2156+0000
NB FT STA 2167+71.22
NB 2167+71.22
100' RT.
NB 2165+78
NB PI STA 2161+9607
2160+8970
PERM #5465
US ELEV
166055
BM #428
US ELEV
165860
LAMSON
SPENCER
NB CURVE DATA
Base = 7/16" Per Ft.
CONTROL OF ACCESS IS COMPLETE ON THIS SHEET
BROCKFIELD-WILLIAMSTOWN
I 89-1 (20)
SECTION NO I
13A
14
12A

25