DRILLING & BLASTING OF SOLID ROCK SUBGRADE
ITEM 115
S.A.#1 16+50 - 22+90.00

6' GALV. CHAIN-LINK FENCE (8'-0" Post Spacing)
S.A.#1 18+00 - 22+19 Lt.

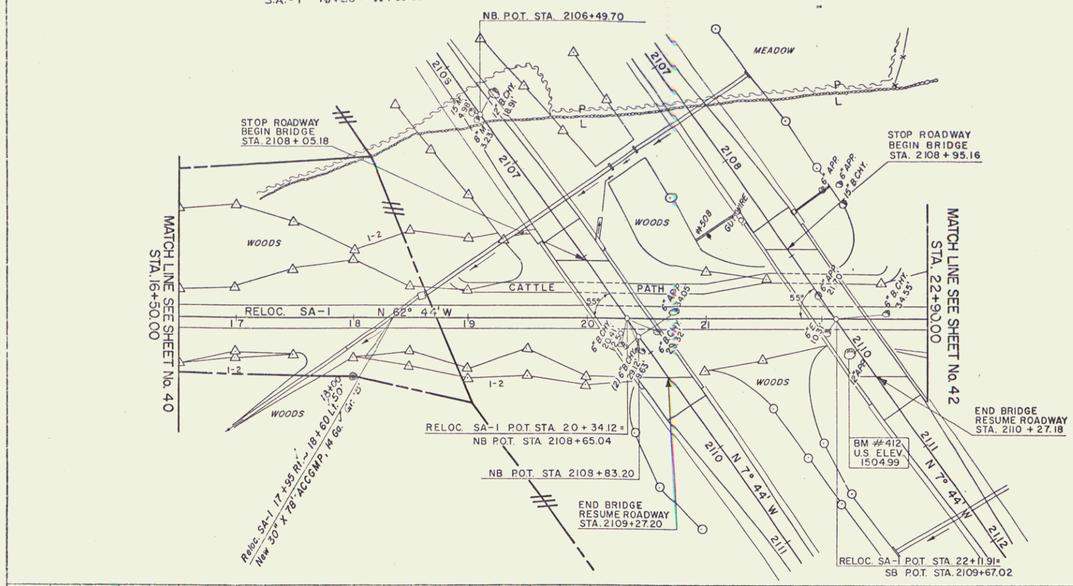

FOR PLAN OF RELOCATED SA-1
STA. 22+90.00 TO STA. 29+00.00
SEE SHEET 32 OF 406

NOTE:
SEE SHEETS BR 200 SERIES
FOR THE ABOVE STRUCTURES

NOTE: RELOC. SA-1 TO BE BUILT IN ITS ENTIRETY DURING STAGE I CONSTRUCTION.

VT. GRID

○ FILL
△ CUT

PLAN SCALE
0 50 100
100 FEET

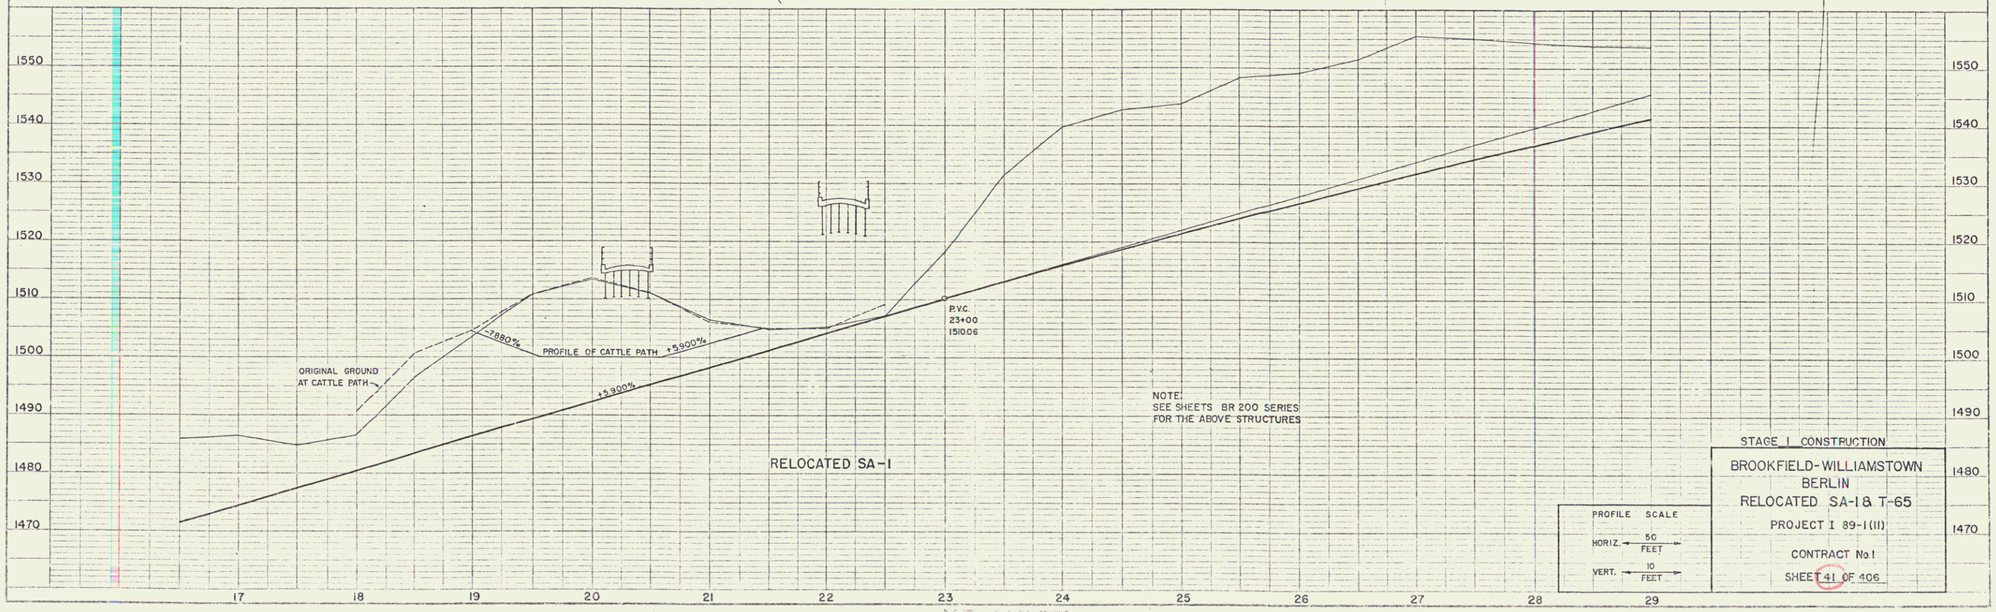

NOTE:
SEE SHEETS BR 200 SERIES
FOR THE ABOVE STRUCTURES

PROFILE SCALE
HORIZ. 50 FEET
VERT. 10 FEET

STAGE I CONSTRUCTION

BROOKFIELD-WILLIAMSTOWN
BERLIN
RELOCATED SA-1 & T-65
PROJECT I 89-1(11)
CONTRACT No. 1
SHEET 41 OF 406

PLAN
NOTE BOOK NO. 13
PLOTTED WEBSTER-MARTIN 1/66
DRAWN W.E. FOSTER 12/66
CHECKED H.E. REYNOLDS 12/66
PROFILE
NOTE BOOK NO. 13
PLOTTED WEBSTER-MARTIN 1/66
DRAWN W.E. FOSTER 12/66
CHECKED H.E. REYNOLDS 12/66
PROFILE CHECKED H.E. REYNOLDS 12/66

81