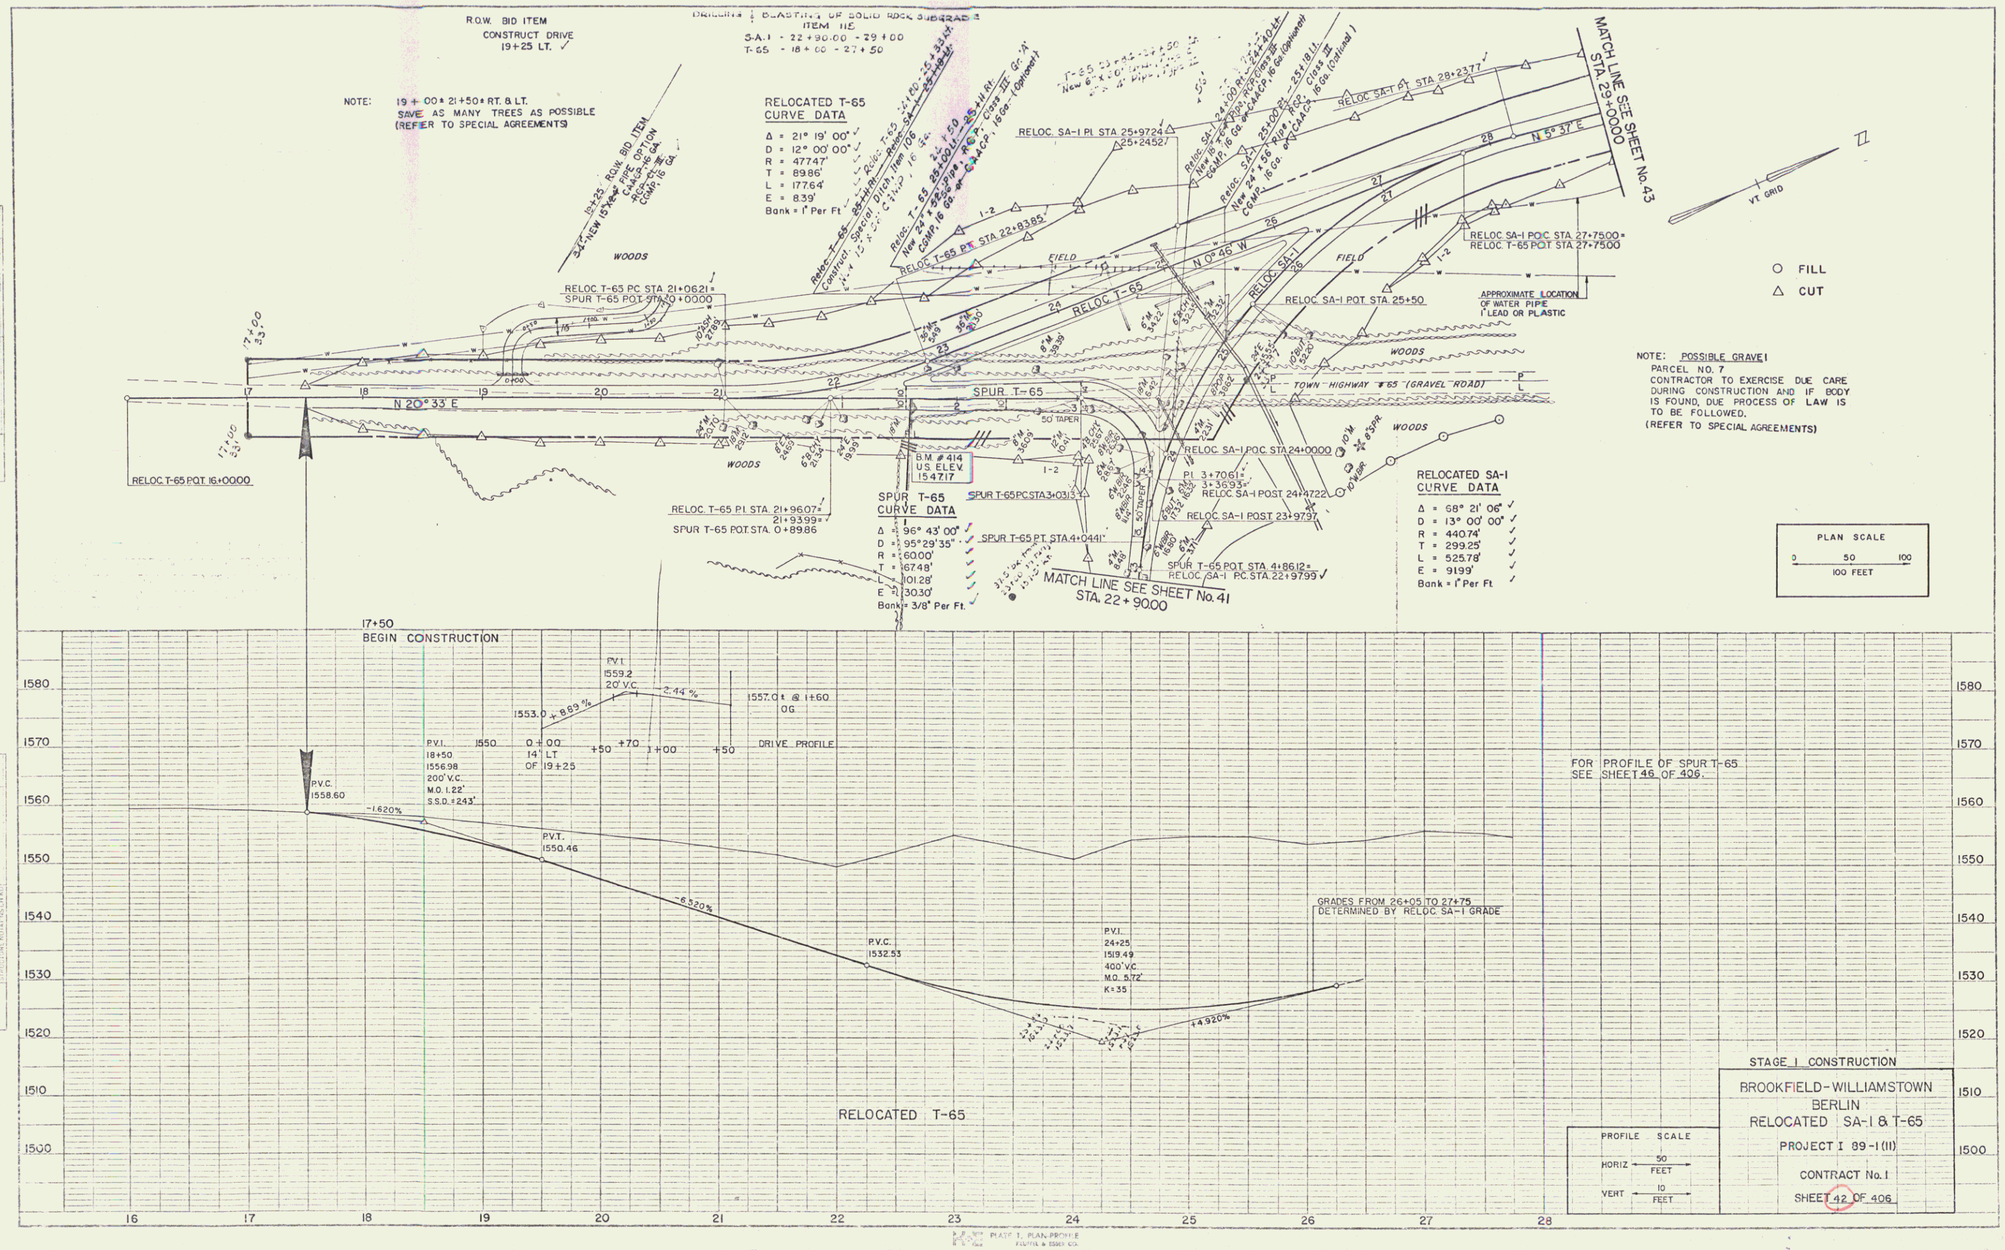
R.O.W. BID ITEM
CONSTRUCT DRIVE
19+25 LT.
NOTE: 19 + 00 & 21+50 RT. & LT.
SAVE AS MANY TREES AS POSSIBLE
(REFER TO SPECIAL AGREEMENTS)
DRILLING & BLASTING OF SOLID ROCK SUBGRADE
ITEM 115
S-A-1 - 22+90.00 - 29+00
T-65 - 18+00 - 27+50
RELOCATED T-65
CURVE DATA
Δ = 21° 19' 00"
D = 12° 00' 00"
R = 477.47'
T = 89.86'
L = 177.64'
E = 8.39'
Bank = 1' Per Ft
WOODS
FIELD
RELOC T-65 PC STA 21+062.1*
SPUR T-65 POT STA 0+00.00
RELOC T-65 PT STA 22+83.85
RELOC SA-I PI STA 25+97.24
25+24.52
RELOC SA-I POT STA 25+50
RELOC SA-I POC STA 27+75.00*
RELOC T-65 POT STA 27+75.00
APPROXIMATE LOCATION
OF WATER PIPE
1" LEAD OR PLASTIC
MATCH LINE SEE SHEET No. 43
STA. 29+00.00
N 5° 37' E
N 0° 46' W
RELOC SA-1
RELOC T-65
SPUR T-65
N 20° 33' E
50' TAPER
TOWN HIGHWAY #65 (GRAVEL ROAD)
RELOC SA-I POC STA 24+00.00
PI 3+70.61*
3+36.93*
RELOC SA-I POST 24+47.22
RELOC SA-I POST 23+97.97
SPUR T-65 POT STA 4+86.12*
RELOC SA-I PC STA 22+97.99
MATCH LINE SEE SHEET No. 41
STA. 22+90.00
RELOC T-65 POT 16+00.00
RELOC T-65 PI STA 21+96.07*
21+93.99*
SPUR T-65 POT STA 0+89.86
B.M. # 414
U.S. ELEV.
154.717
SPUR T-65 PC STA 3+03.13
SPUR T-65 PT STA 4+04.41
SPUR T-65
CURVE DATA
Δ = 96° 43' 00"
D = 95° 29' 35"
R = 60.00'
T = 67.48'
L = 101.28'
E = 30.30'
Bank = 3/8" Per Ft.
RELOCATED SA-I
CURVE DATA
Δ = 68° 21' 06"
D = 13° 00' 00"
R = 440.74'
T = 299.25'
L = 525.78'
E = 91.99'
Bank = 1' Per Ft
VT GRID
FILL
CUT
NOTE: POSSIBLE GRAVEL
PARCEL NO. 7
CONTRACTOR TO EXERCISE DUE CARE
DURING CONSTRUCTION AND IF BODY
IS FOUND, DUE PROCESS OF LAW IS
TO BE FOLLOWED.
(REFER TO SPECIAL AGREEMENTS)
PLAN SCALE
0 50 100
100 FEET
17+50
BEGIN CONSTRUCTION
P.V.C.
1558.60
-1.620%
P.V.I.
18+50
1556.98
200' V.C.
M.O. 1.22'
S.S.D. = 243'
P.V.T.
1550.46
-6.520%
P.V.C.
1532.53
P.V.I.
24+25
1519.49
400' V.C.
M.O. 5.72'
K = 35
+4.920%
P.V.I.
1559.2
20' V.C.
-2.44%
1553.0 = 8.89%
1557.0 ± @ 1+60
OG
0+00
14' LT
OF 19+25
DRIVE PROFILE
GRADES FROM 26+05 TO 27+75
DETERMINED BY RELOC SA-1 GRADE
FOR PROFILE OF SPUR T-65
SEE SHEET 46 OF 406.
RELOCATED T-65
PROFILE SCALE
HORIZ 50 FEET
VERT 10 FEET
STAGE I CONSTRUCTION
BROOKFIELD-WILLIAMSTOWN
BERLIN
RELOCATED SA-1 & T-65
PROJECT I 89-1(11)
CONTRACT No. 1
SHEET 42 OF 406

82