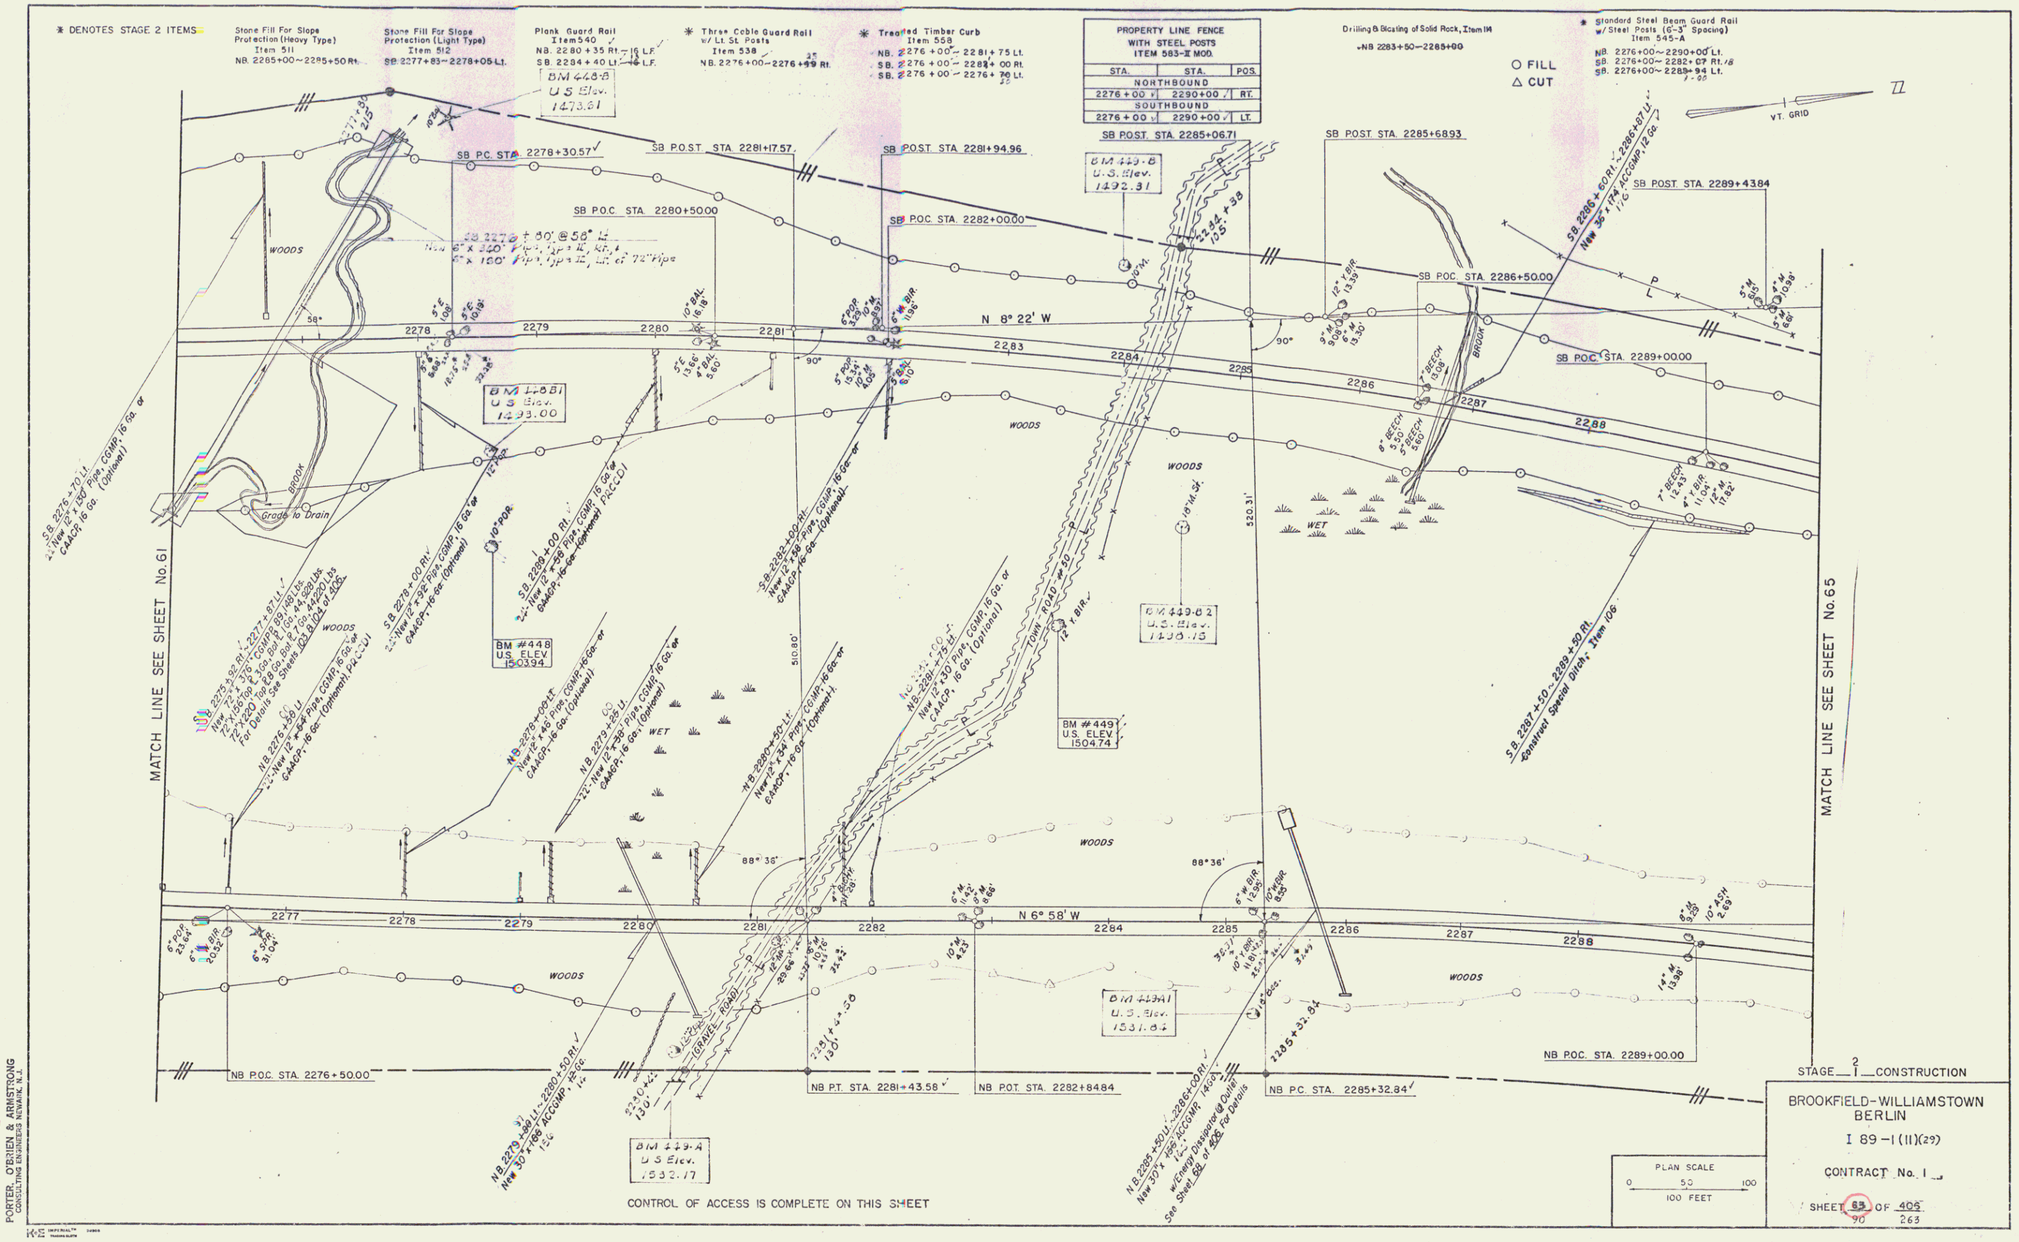
* DENOTES STAGE 2 ITEMS
Stone Fill For Slope Protection (Heavy Type) Item 511 NB. 2285+00~2285+50 Rt.
Stone Fill For Slope Protection (Light Type) Item 512 SB. 2277+83~2278+05 Lt.
Plank Guard Rail Item 540 NB. 2280+35 Rt. SB. 2284+40 Lt.
* Three Cable Guard Rail w/ Lt. St. Posts Item 538 NB. 2276+00~2276+59 Rt.
* Treated Timber Curb Item 558 NB. 2276+00~2281+75 Lt. SB. 2276+00~2284+00 Rt. SB. 2276+00~2276+76 Lt.
PROPERTY LINE FENCE WITH STEEL POSTS ITEM 583-II MOD.
STA. STA. POS.
NORTHBOUND
2276+00 2290+00 RT.
SOUTHBOUND
2276+00 2290+00 LT.
Drilling & Blasting of Solid Rock, Item 114 NB. 2283+50~2285+00
* Standard Steel Beam Guard Rail w/ Steel Posts (6'-3" Spacing) Item 545-A
NB. 2276+00~2290+00 Lt.
SB. 2276+00~2282+67 Rt.
SB. 2276+00~2289+94 Lt.
○ FILL
△ CUT
VT. GRID
SB P.O.C. STA. 2278+30.57
SB P.O.S.T. STA. 2281+17.57
SB P.O.S.T. STA. 2281+94.96
SB P.O.S.T. STA. 2285+06.71
SB P.O.S.T. STA. 2285+68.93
SB P.O.S.T. STA. 2289+43.84
SB P.O.C. STA. 2280+50.00
SB P.O.C. STA. 2282+00.00
SB P.O.C. STA. 2286+50.00
SB P.O.C. STA. 2289+00.00
N 8° 22' W
N 6° 58' W
WOODS
WET
BROOK
Grade to Drain
TOWN ROAD #50
(GRAVEL ROAD)
MATCH LINE SEE SHEET No. 61
MATCH LINE SEE SHEET No. 65
NB P.O.C. STA. 2276+50.00
NB P.T. STA. 2281+43.58
NB P.O.T. STA. 2282+84.84
NB P.C. STA. 2285+32.84
NB P.O.C. STA. 2289+00.00
BM #449-B U.S. Elev. 1473.81
BM #449-C U.S. Elev. 1492.31
BM #449-B2 U.S. Elev. 1496.15
BM #449 U.S. ELEV. 1504.74
BM #449-A U.S. Elev. 1532.17
CONTROL OF ACCESS IS COMPLETE ON THIS SHEET
PLAN SCALE 0 50 100 100 FEET
STAGE 2 CONSTRUCTION
BROOKFIELD-WILLIAMSTOWN BERLIN
I 89-1(11)(29)
CONTRACT No. 1
SHEET 83 OF 405
90 263
PORTER, O'BRIEN & ARMSTRONG CONSULTING ENGINEERS NEWARK, N.J.

94