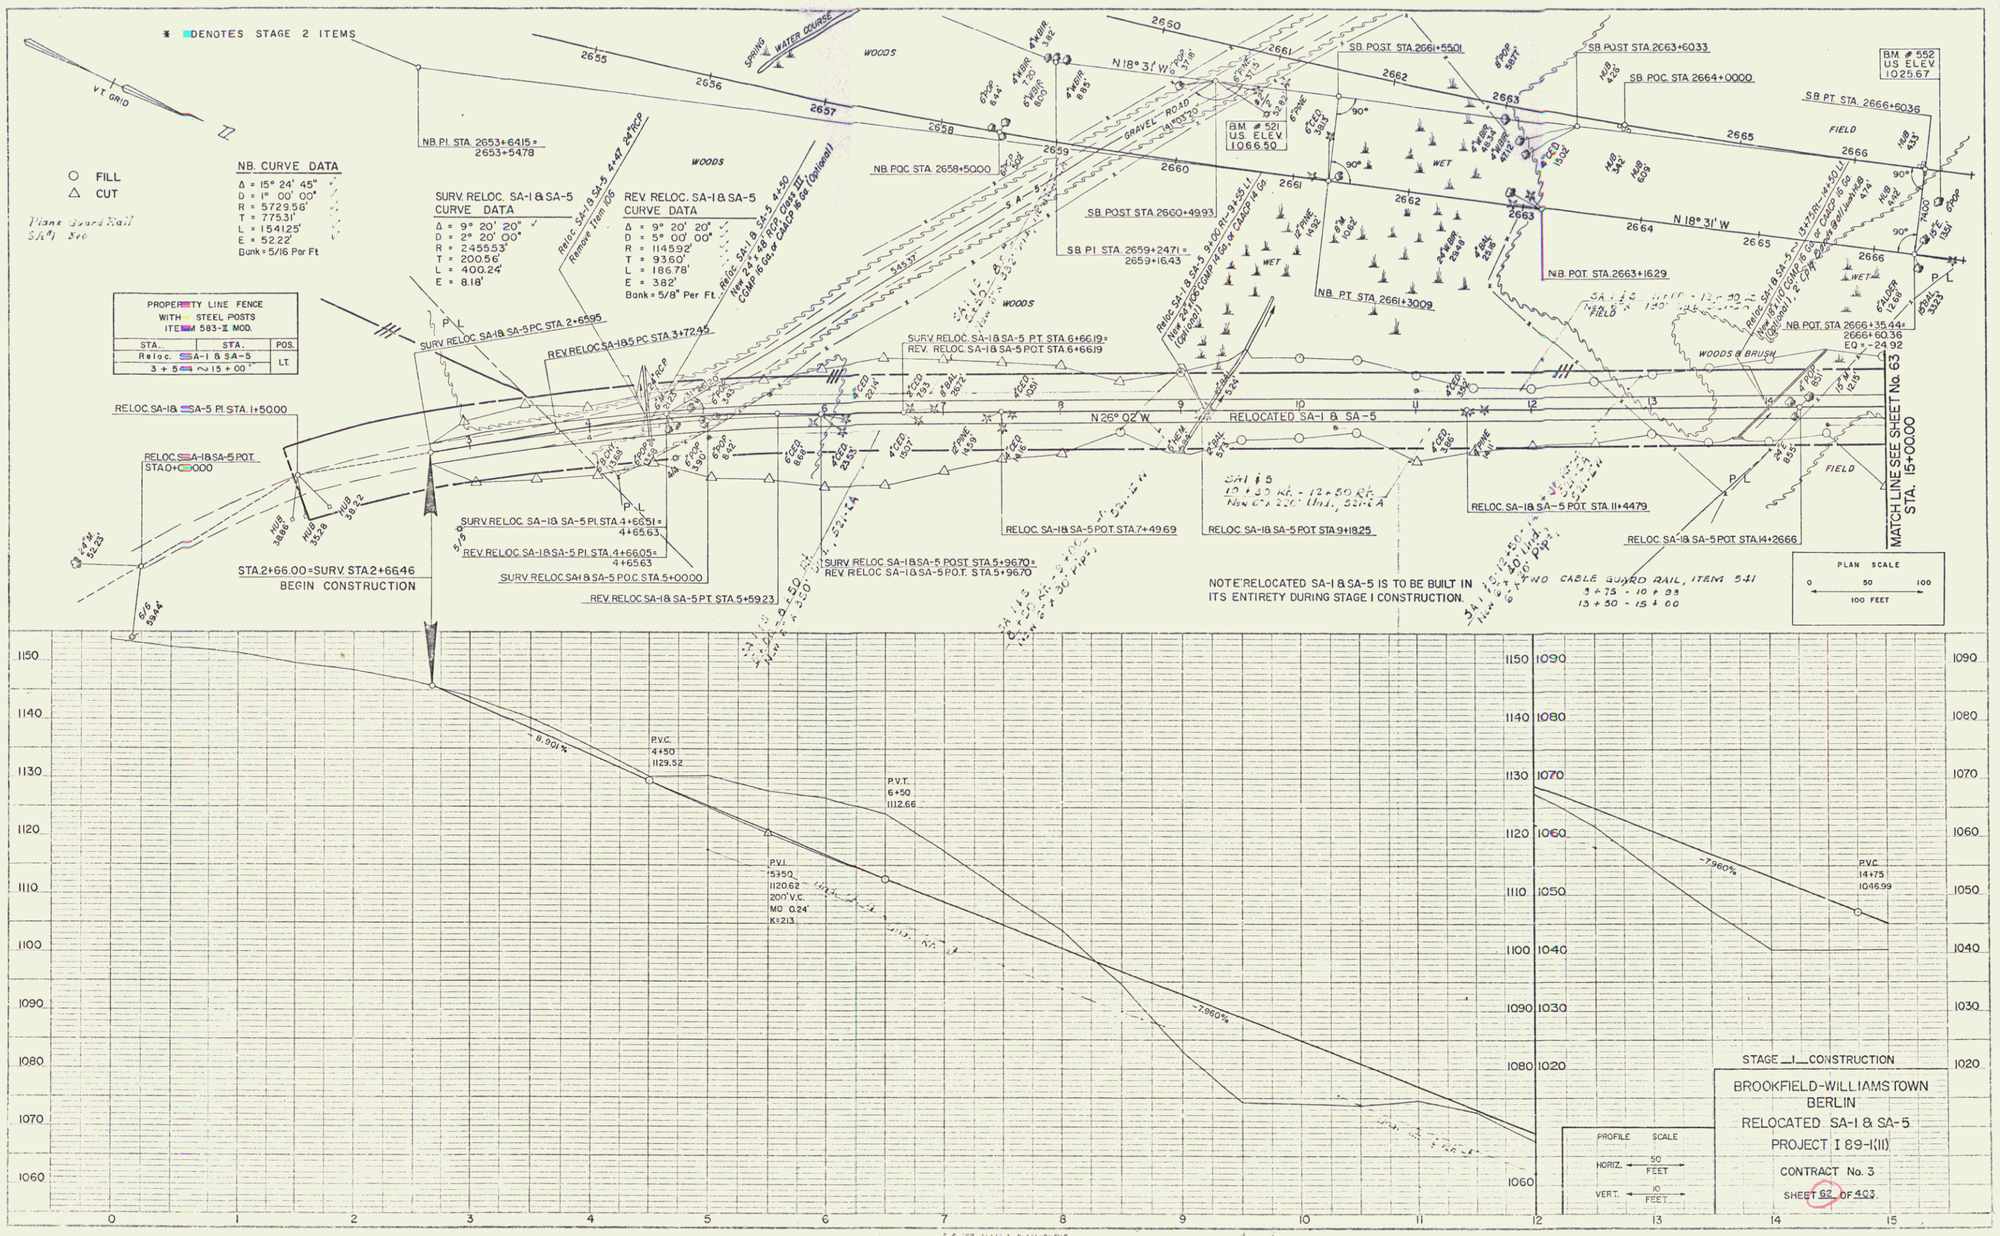
* DENOTES STAGE 2 ITEMS
FILL
CUT
NB. CURVE DATA
Δ = 15° 24' 45"
D = 1° 00' 00"
R = 5729.56'
T = 775.31'
L = 1541.25'
E = 52.22'
Bank = 5/16 Per Ft
SURV. RELOC. SA-1 & SA-5 CURVE DATA
Δ = 9° 20' 20"
D = 2° 20' 00"
R = 2455.53'
T = 200.56'
L = 400.24'
E = 8.18'
REV. RELOC. SA-1 & SA-5 CURVE DATA
Δ = 9° 20' 20"
D = 5° 00' 00"
R = 1145.92'
T = 93.60'
L = 186.78'
E = 3.82'
Bank = 5/8" Per Ft.
PROPERTY LINE FENCE WITH STEEL POSTS ITEM 583-II MOD.
STA. Reloc. SA-1 & SA-5 3 + 50 ~ 15 + 00
POS. LT.
NB. PI. STA. 2653+64.15 = 2653+54.78
NB. POC. STA. 2658+50.00
SB. POST STA. 2661+55.01
SB. POST STA. 2663+60.33
SB. POC. STA. 2664+00.00
SB. PT. STA. 2666+60.36
SB. POST STA. 2660+49.93
SB. PI. STA. 2659+24.71 = 2659+16.43
NB. POT. STA. 2663+16.29
NB. PT. STA. 2661+30.09
NB. POT. STA. 2666+35.44 = 2666+60.36 EQ = -24.92
BM # 521 US. ELEV. 1066.50
BM # 552 US. ELEV. 1025.67
N 18° 31' W
N 26° 02' W
RELOCATED SA-1 & SA-5
RELOC. SA-1 & SA-5 PI. STA. 1+50.00
RELOC. SA-1 & SA-5 POT. STA. 0+00.00
STA. 2+66.00 = SURV. STA. 2+66.46
BEGIN CONSTRUCTION
SURV. RELOC. SA-1 & SA-5 PC. STA. 2+65.95
REV. RELOC. SA-1 & SA-5 PC. STA. 3+72.45
SURV. RELOC. SA-1 & SA-5 PI. STA. 4+66.51 = 4+65.63
REV. RELOC. SA-1 & SA-5 PI. STA. 4+66.05 = 4+65.63
SURV. RELOC. SA-1 & SA-5 POC. STA. 5+00.00
REV. RELOC. SA-1 & SA-5 PT. STA. 5+59.23
SURV. RELOC. SA-1 & SA-5 POST. STA. 5+96.70 = REV. RELOC. SA-1 & SA-5 POT. STA. 5+96.70
SURV. RELOC. SA-1 & SA-5 PT. STA. 6+66.19 = REV. RELOC. SA-1 & SA-5 POT. STA. 6+66.19
RELOC. SA-1 & SA-5 POT. STA. 7+49.69
RELOC. SA-1 & SA-5 POT. STA. 9+18.25
RELOC. SA-1 & SA-5 POT. STA. 11+44.79
RELOC. SA-1 & SA-5 POT. STA. 14+26.66
MATCH LINE SEE SHEET No. 63 STA. 15+00.00
NOTE: RELOCATED SA-1 & SA-5 IS TO BE BUILT IN ITS ENTIRETY DURING STAGE I CONSTRUCTION.
TWO CABLE GUARD RAIL, ITEM 541
PLAN SCALE 0 50 100 100 FEET
P.V.C. 4+50 1129.52
P.V.T. 6+50 1112.66
P.V.I. 15+50 1120.62 200' V.C. MO 0.24' K=21.3
P.V.C. 14+75 1046.99
-8.901%
-7.960%
PROFILE SCALE
HORIZ. 50 FEET
VERT. 10 FEET
STAGE I CONSTRUCTION
BROOKFIELD-WILLIAMSTOWN
BERLIN
RELOCATED SA-1 & SA-5
PROJECT I 89-1(11)
CONTRACT No. 3
SHEET 62 OF 403.

131