Construction Plans

Berlin - Montpelier I 89-1(12)
Station 2674+95.66 = 35+00 ~ 208+00

INDEX OF SHEETS

1	Title sheet	
2	Alignment Data Sheet	
3-9	Typical Sheets	
10-11	Quantity Sheets	
12-13	Drainage Plan	
14-20	Erosion Control	
27-34	Right-of-Way Detail Sheets	
35-97	Plan and Profile Sheets	
98-71	Zig Zag Detail Sheets	
72-73	Details of 10'x7' - 130' Reinforced Concrete Box at Sta. 494+68±	
84-92	Details of 7'x7'x 330' Reinforced Concrete Box at Sta. 50+25 (Pipe Gulley)	
99-107	BR 100 Series Town Highway 40 at Sta. 59+70±	
108-122	BR 200 Series Berlin State Highway at Sta. 75+00	
123-135	BR 300 Series Town Highway 18 at Sta. 101+00±	
136-150	Details of 60" C.G.M.P.P. at Sta. 162+00	
151-175	BR 400 Series Vt. 12 at Sta. 193+50±	
175	A-60 Solid Rock Excavation (In Areas Over 50 M.P.H.)	12-21-67 R
180	A-61 Solid Rock Excavation (In Areas Under 50 M.P.H.)	8- 7-67 R
181	B-1 Banking Tables	7-17-67 R
182	B-5 Typical Slope Grading	3-10-65
183	B-6 Muck Excavation	3-10-65
184	B-10 Embankment on a Slope	3-10-65
185	B-11 Methods of Slope Stabilization	3-10-65
186	Blank	
187	D-2 Underdrain and Headwalls	7-25-67 R
188	D-3 Gutters	7-19-67 R
189	D-4 Elbows, Flushing Basins and Metal End Sections	8- 1-66 R
190	Blank	
191	D-8 Drop Inlets	3-10-65
192	D-10 Drop Inlet Tops	3-10-65
193	D-11 Details of Grates and Covers	3-10-65
194	D-12 Catch Basin or Manhole	3-10-65
195	D-16 Drop Inlet Type 3L	7-16-67 R
196	D-17 A.C.C.M.P. Vertical Riser and Concentric Reducer Units	1- 6-68 R
197	Blank	
198	E-31 Federal Aid Construction Identification Signs	8-21-67 R
199	E-32 Road Construction Approach Signs	1- 6-67
200	E-34 On-Project Construction Signs	5- 3-67 R
201	Blank	
202	Blank	
203	F-1 Property Line	11-23-67 R
204	G-9a Two Cable Guard Rail	5-10-65
205	G-9c Pinch Guard Rail	12-30-66 R
206	J-1 Boundary Markers	3-10-65
207	SCB-D1-67 All Details Used	1-24-68
208	SCB-D2-67 Details Ⓐ, Ⓑ & Ⓒ	1-24-68
209	SCB-D3-67 Detail Ⓓ	1-24-68
210	SCB-D4-67 All Details Used	1-24-68
211	SCB-D5-67 Details Ⓔ, Ⓕ & Ⓖ	1-24-68
212	SCB-D6-67 Details Ⓗ & Ⓘ	1-24-68
213	SCB-D9-67 Detail Ⓙ	1-24-68
214	SB-H1-64 Sheet 1 of 2 Aluminum Railing Details	1-31-67 R
215	SB-H1-64 Sheet 2 of 2 Aluminum Railing Details	11- 8-66 R
216	SB-R2-63 Steel Railing Details	11- 8-66 R
217	Blank	
218	Blank	
219-429	Mainline Cross Sections	
430-436	State Aid 1 Cross Sections	
437-438	Town Highway 42 Cross Sections	
439-443	Town Highway 40 Cross Sections	
444-467	Ramp Cross Sections	
468-486	Berlin State Highway Cross Sections	
487-494	Town Highway 12 Cross Sections	
495-497	Vt. 12 Cross Sections	

STATE OF VERMONT
DEPARTMENT OF HIGHWAYS

PROPOSED IMPROVEMENT

INTERSTATE PROJECT

TOWN OF BERLIN--CITY OF MONTPELIER
COUNTY OF WASHINGTON
INTERSTATE ROUTE 89
WHITE RIVER JCT.-MONTPELIER ROAD

BEGINNING AT A POINT 2.647 MILES SOUTHERLY OF THE SOUTHERN CROSSING OF THE BERLIN-MONTPELIER TOWN LINE AND EXTENDING NORTHERLY 3.267 MILES.

LENGTH OF ROADWAY 16,507.85 FEET = 3.127 MILES
LENGTH OF BRIDGES 740.92 FEET = 0.140 MILES
LENGTH OF PROJECT 17,250.77 FEET = 3.267 MILES

ADT	1962	4400
ADT	1987	11990
DHV	1987	1840
D		51.3%
T		6%
V		60

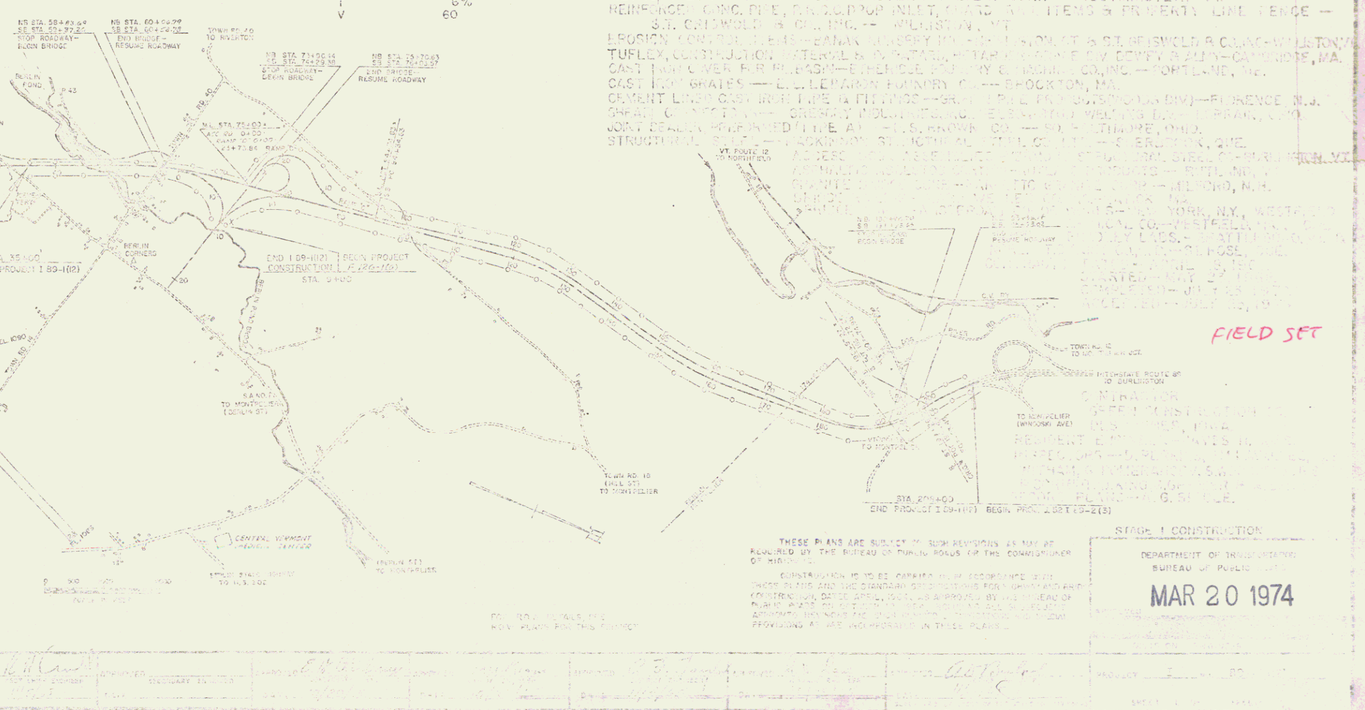

PROJECT NAME & NUMBER TYPE STAGE I
BERLIN-MONTPELIER I 89-1(12) GRADING & DRAINAGE
RECORD PLANS
MATERIALS

SUBBASE OF GRAVEL & GRAVEL BACKFILL -- LOWE PIT -- BERLIN, VT.
SUBBASE OF SAND -- ALKING PIT-BARRE, VT. & HERRING PITS & BROUSSEAU PIT -- BERLIN, VT.
TAR EMULSION, WATER REPELLENT & PRIME WATERPROOFING-KIRBY EQUIPMENT CO.-NEWPORT, VT.
BITUMINOUS CONCRETE, CONCRETE CLASS A & B -- KELLEY CONST. INC. -- WEBSTERVILLE, VT.
REINFORCING STEEL & STEEL PILING -- BETHLEHEM STEEL CORP. -- STEELTON, PA.
METAL CULVERT PIPE -- NORTHEASTERN CULVERT CORP. -- WESTMINSTER, VT.
EROSION CONTROL HERBICIDE-BAMAN NURSERY INC. -- [illegible] & S.T. CRISWOLD & CO. INC.-WILLISTON, VT.
TUFLEX, CONSTRUCTION MATERIAL & [illegible] -- [illegible] & DOWEY, & FLYNN-CAMBRIDGE, MA.
CAST IRON SEWER & R.R. BRASS -- [illegible] CO. INC. -- PORTLAND, ME.
CAST IRON GRATES -- L. L. LEBANON FOUNDRY CO. -- BROCKTON, MA.
CEMENT LINED CAST IRON PIPE & FITTINGS -- [illegible] -- FLORENCE, N.J.
SHEET [illegible] -- GREGORY PUBLISHING CO. -- [illegible] WELDING [illegible] -- FRANKLIN, OHIO
JOINT SEALER [illegible] -- [illegible] -- SOUTHAMPTON, OHIO.
STRUCTURAL STEEL -- [illegible] -- [illegible] -- SHERBROOKE, QUE.
[illegible] -- [illegible] -- [illegible] -- [