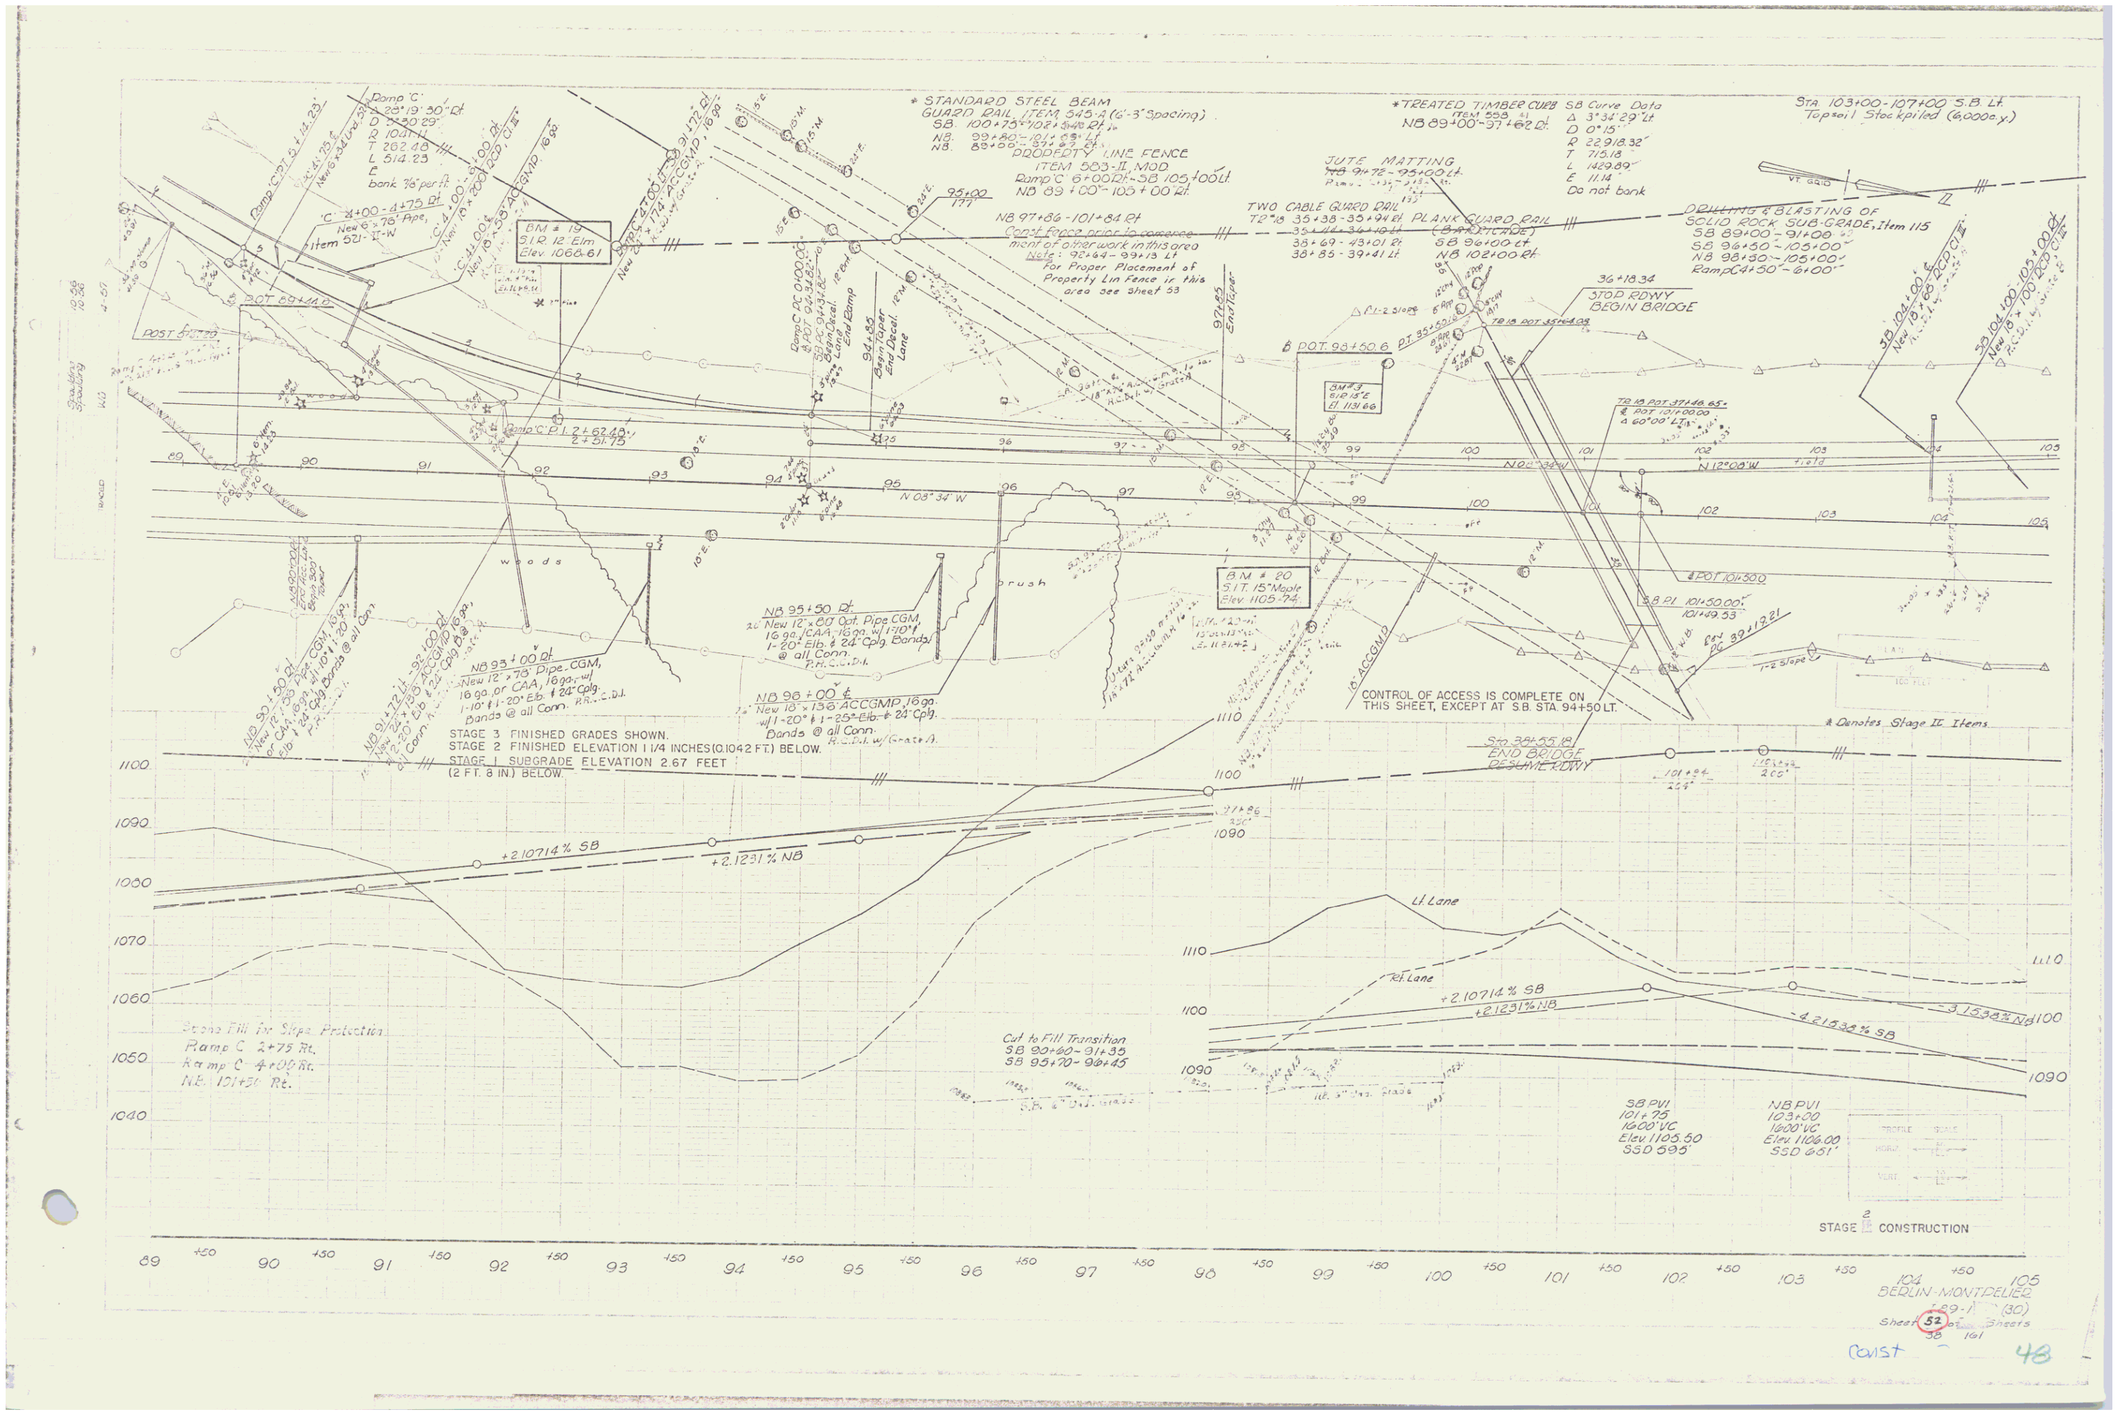
STAGE 3 FINISHED GRADES SHOWN.
STAGE 2 FINISHED ELEVATION 1 1/4 INCHES (0.1042 FT.) BELOW.
STAGE 1 SUBGRADE ELEVATION 2.67 FEET (2 FT. 8 IN.) BELOW.
CONTROL OF ACCESS IS COMPLETE ON THIS SHEET, EXCEPT AT S.B. STA. 94+50 LT.
* Denotes Stage II Items
STAGE 2 CONSTRUCTION
+2.10714 % SB
+2.1231 % NB
-4.21434 % SB
-3.1534 % NB
Lt. Lane
Rt. Lane
Cut to Fill Transition
SB 90+60 - 91+35
SB 95+70 - 96+45
Stone Fill for Slope Protection
Ramp C 2+75 Rt.
Ramp C 4+00 Rt.
NB 101+50 Rt.
SB PVI
101+35
1000' VC
Elev. 1105.50
SSD 595'
NB PVI
103+00
1600' VC
Elev. 1106.00
SSD 651'
BERLIN-MONTPELIER
89-1 (30)
Sheet 52 of 161 Sheets
Const 48