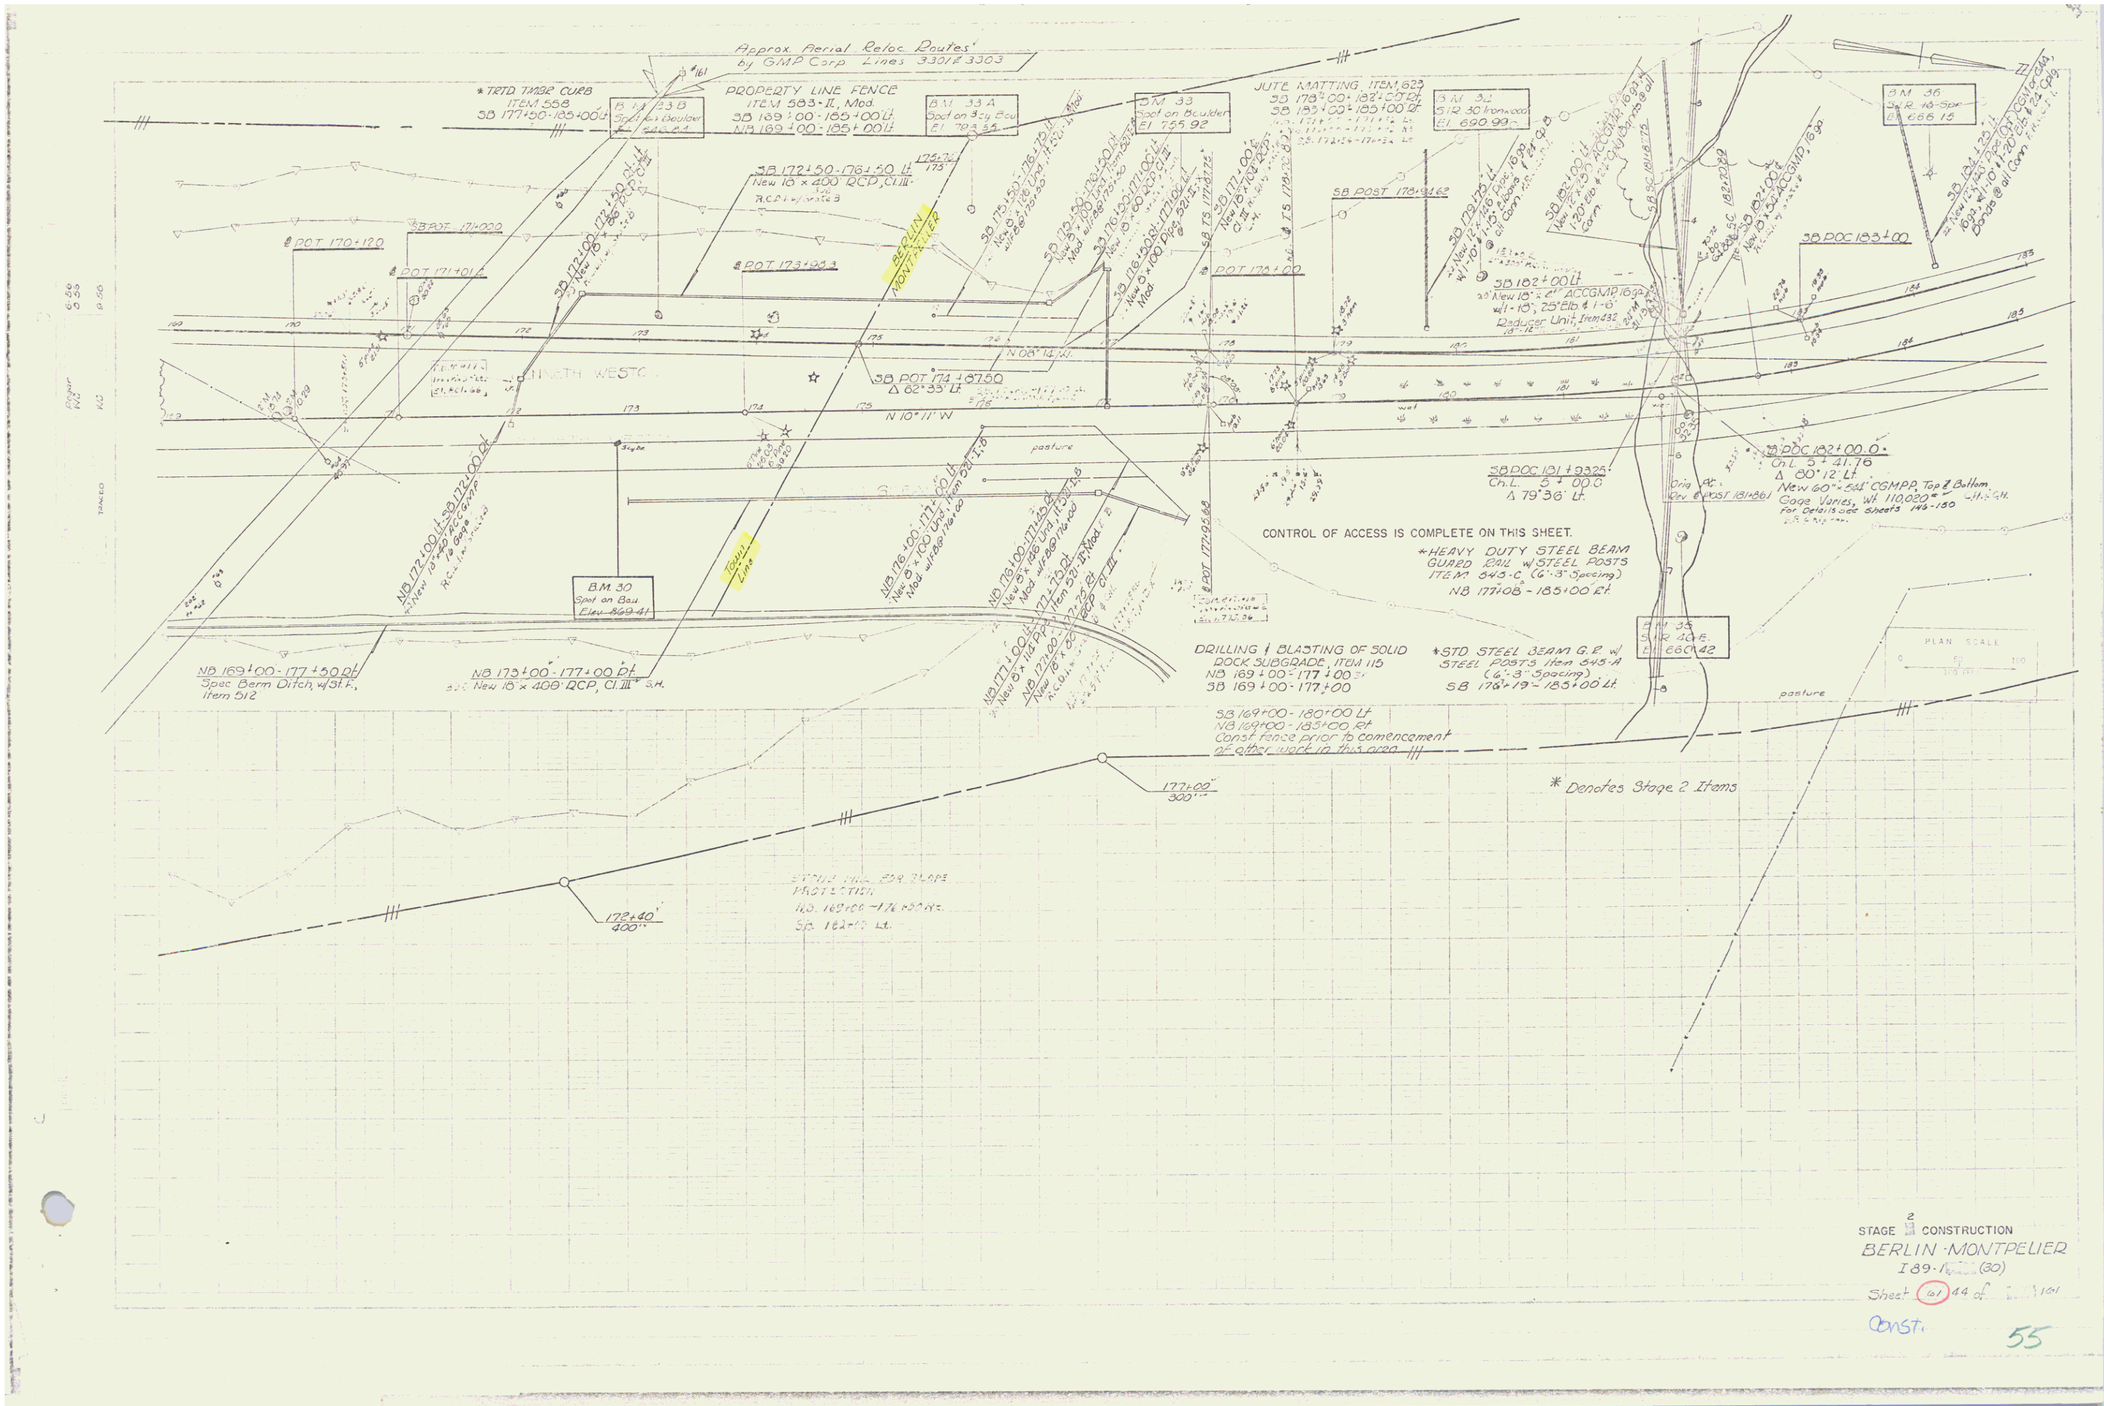

STAGE 2 CONSTRUCTION
BERLIN - MONTPELIER
I 89-1 (30)
Sheet 44 of 101
Const.
55