

CURVE DATA							
RAMP	CURVE NO	Δ	R	T	ARC L	PC OF PCC	PCC OF PT
A	1	60°49'15"	1000.00	536.35'	1061.34	4+92.05	15+53.58


See Sheet 56

See Sheet 32

Note: All Ramp Curves based on Arc Definition, Main Line Curve, Chord Definition.

NOTE: SEE SHEETS 54 & 55 FOR RAMP PROFILES.

NOTE: FOR SUMMARY OF LANDSCAPE MATERIAL
Project 1-89-213 Sheet #32
Contract #1

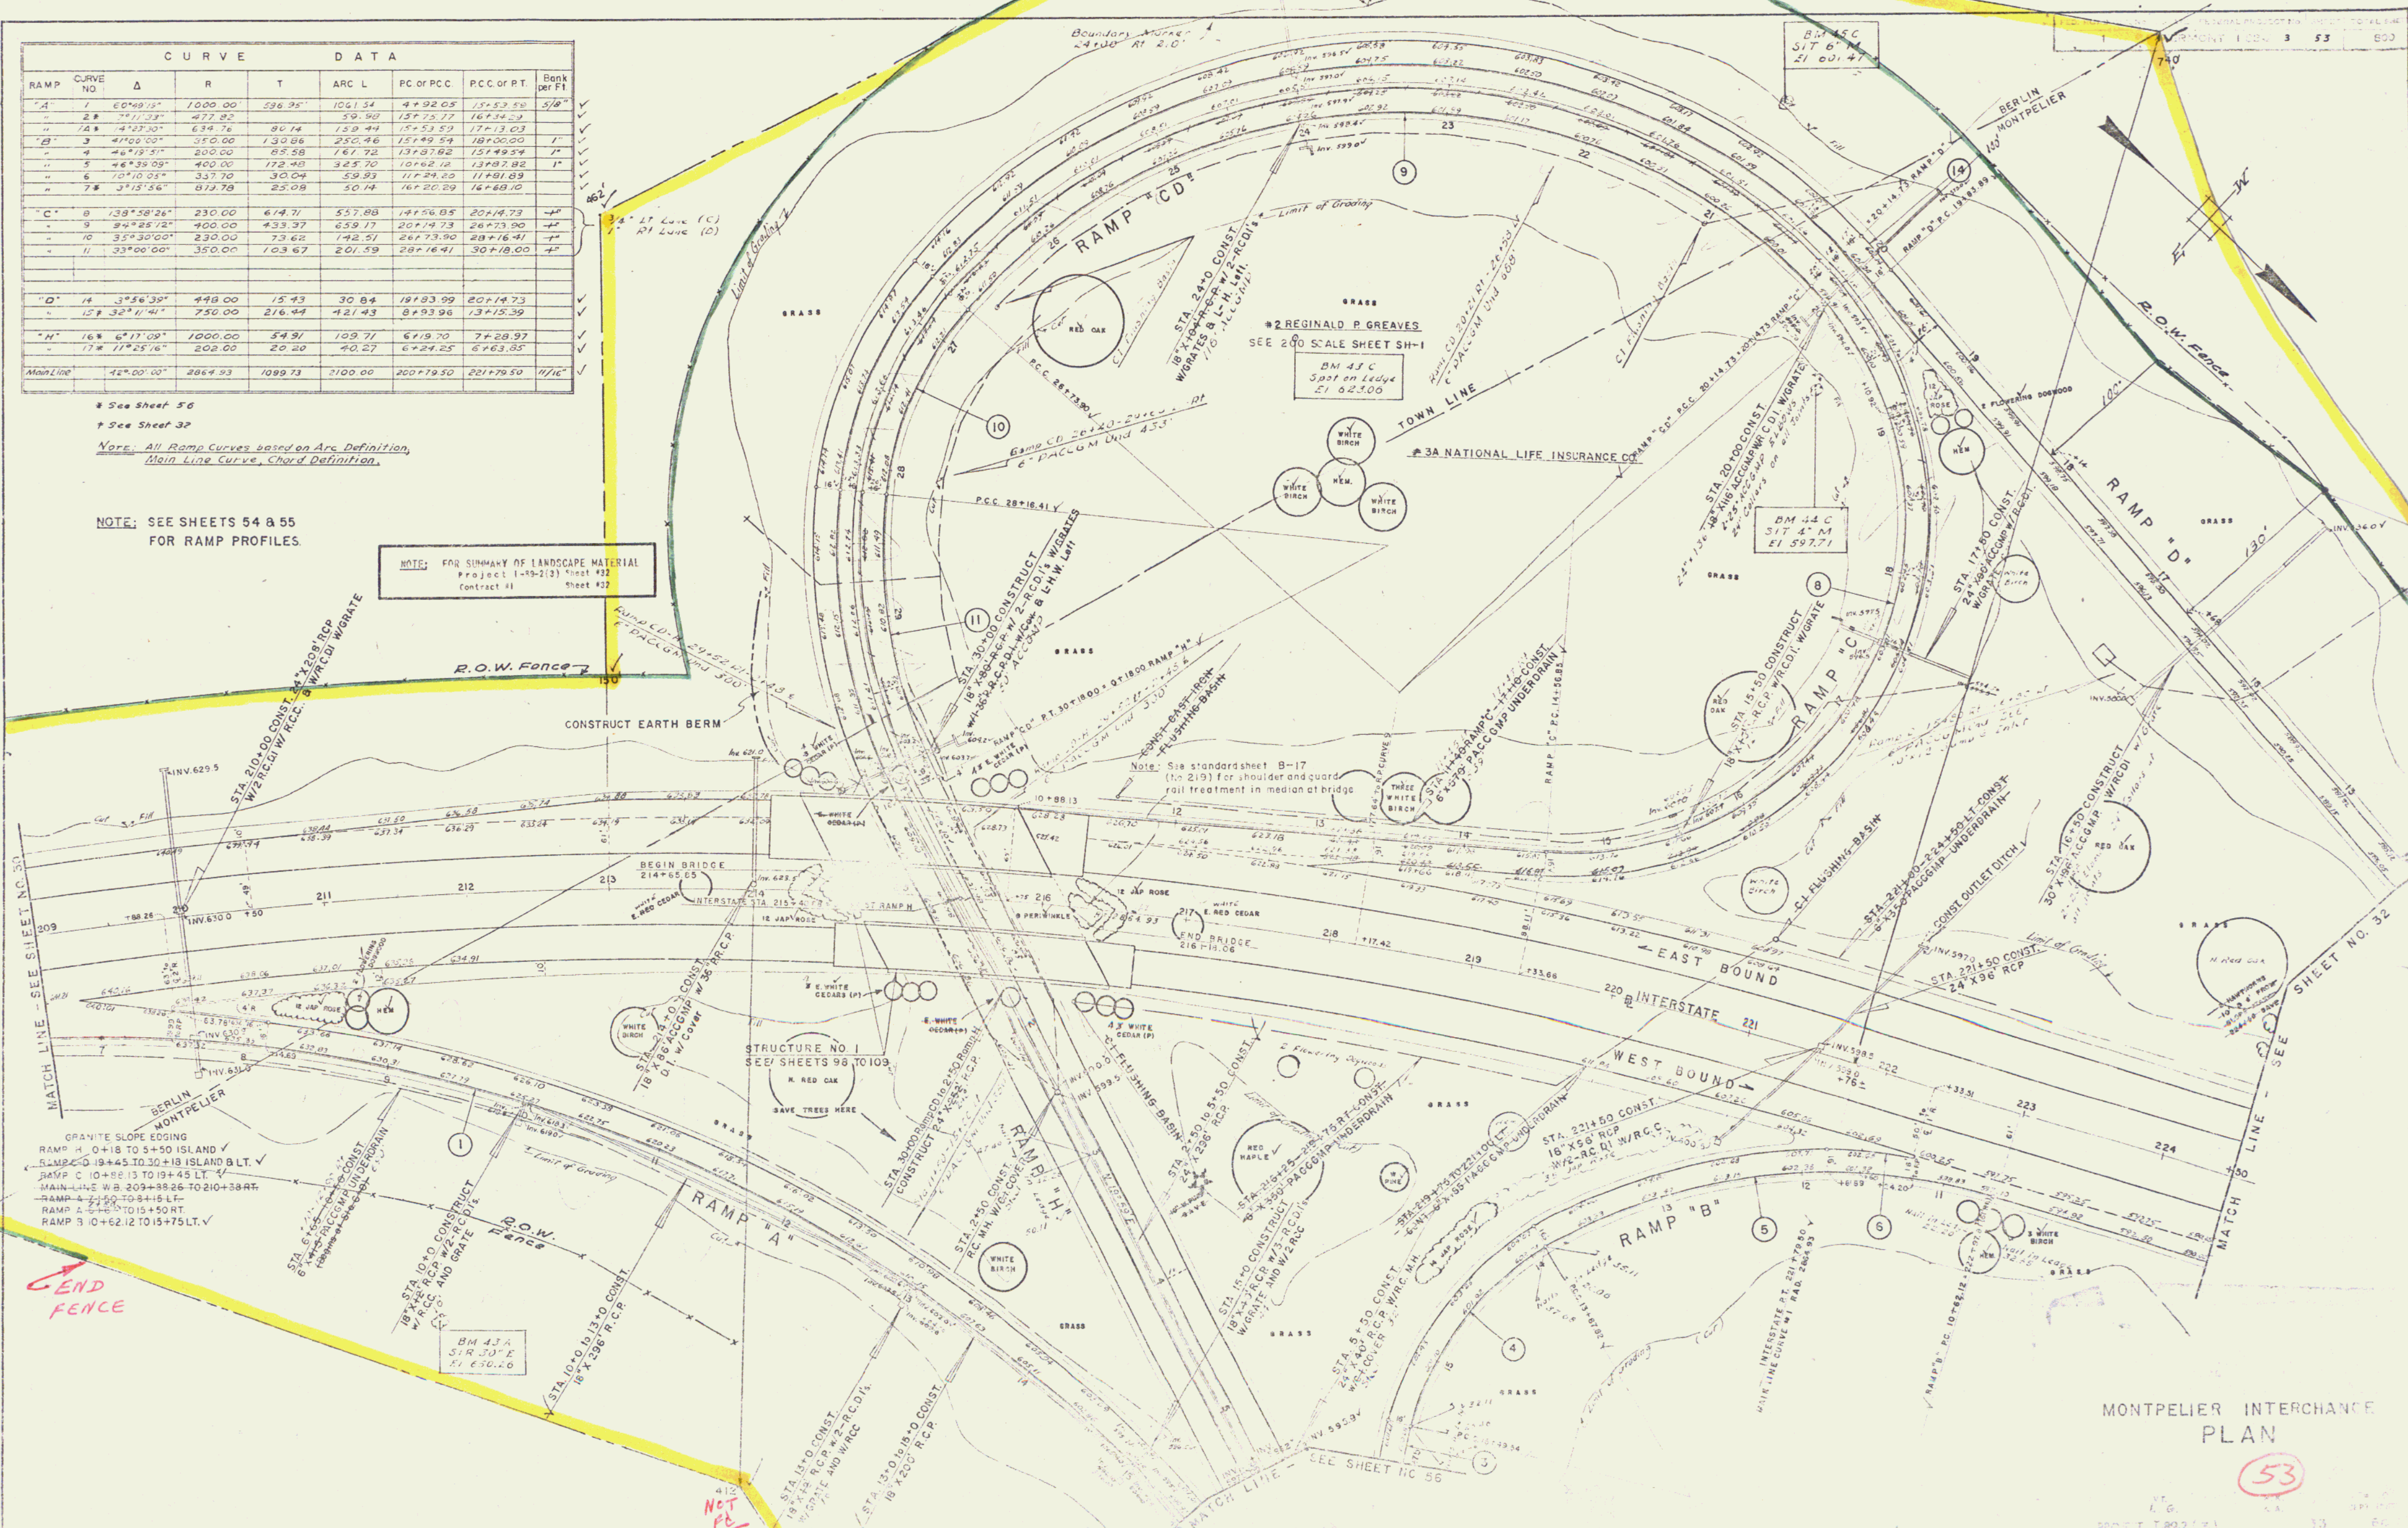

MONTPELIER INTERCHANGE PLAN

53

6