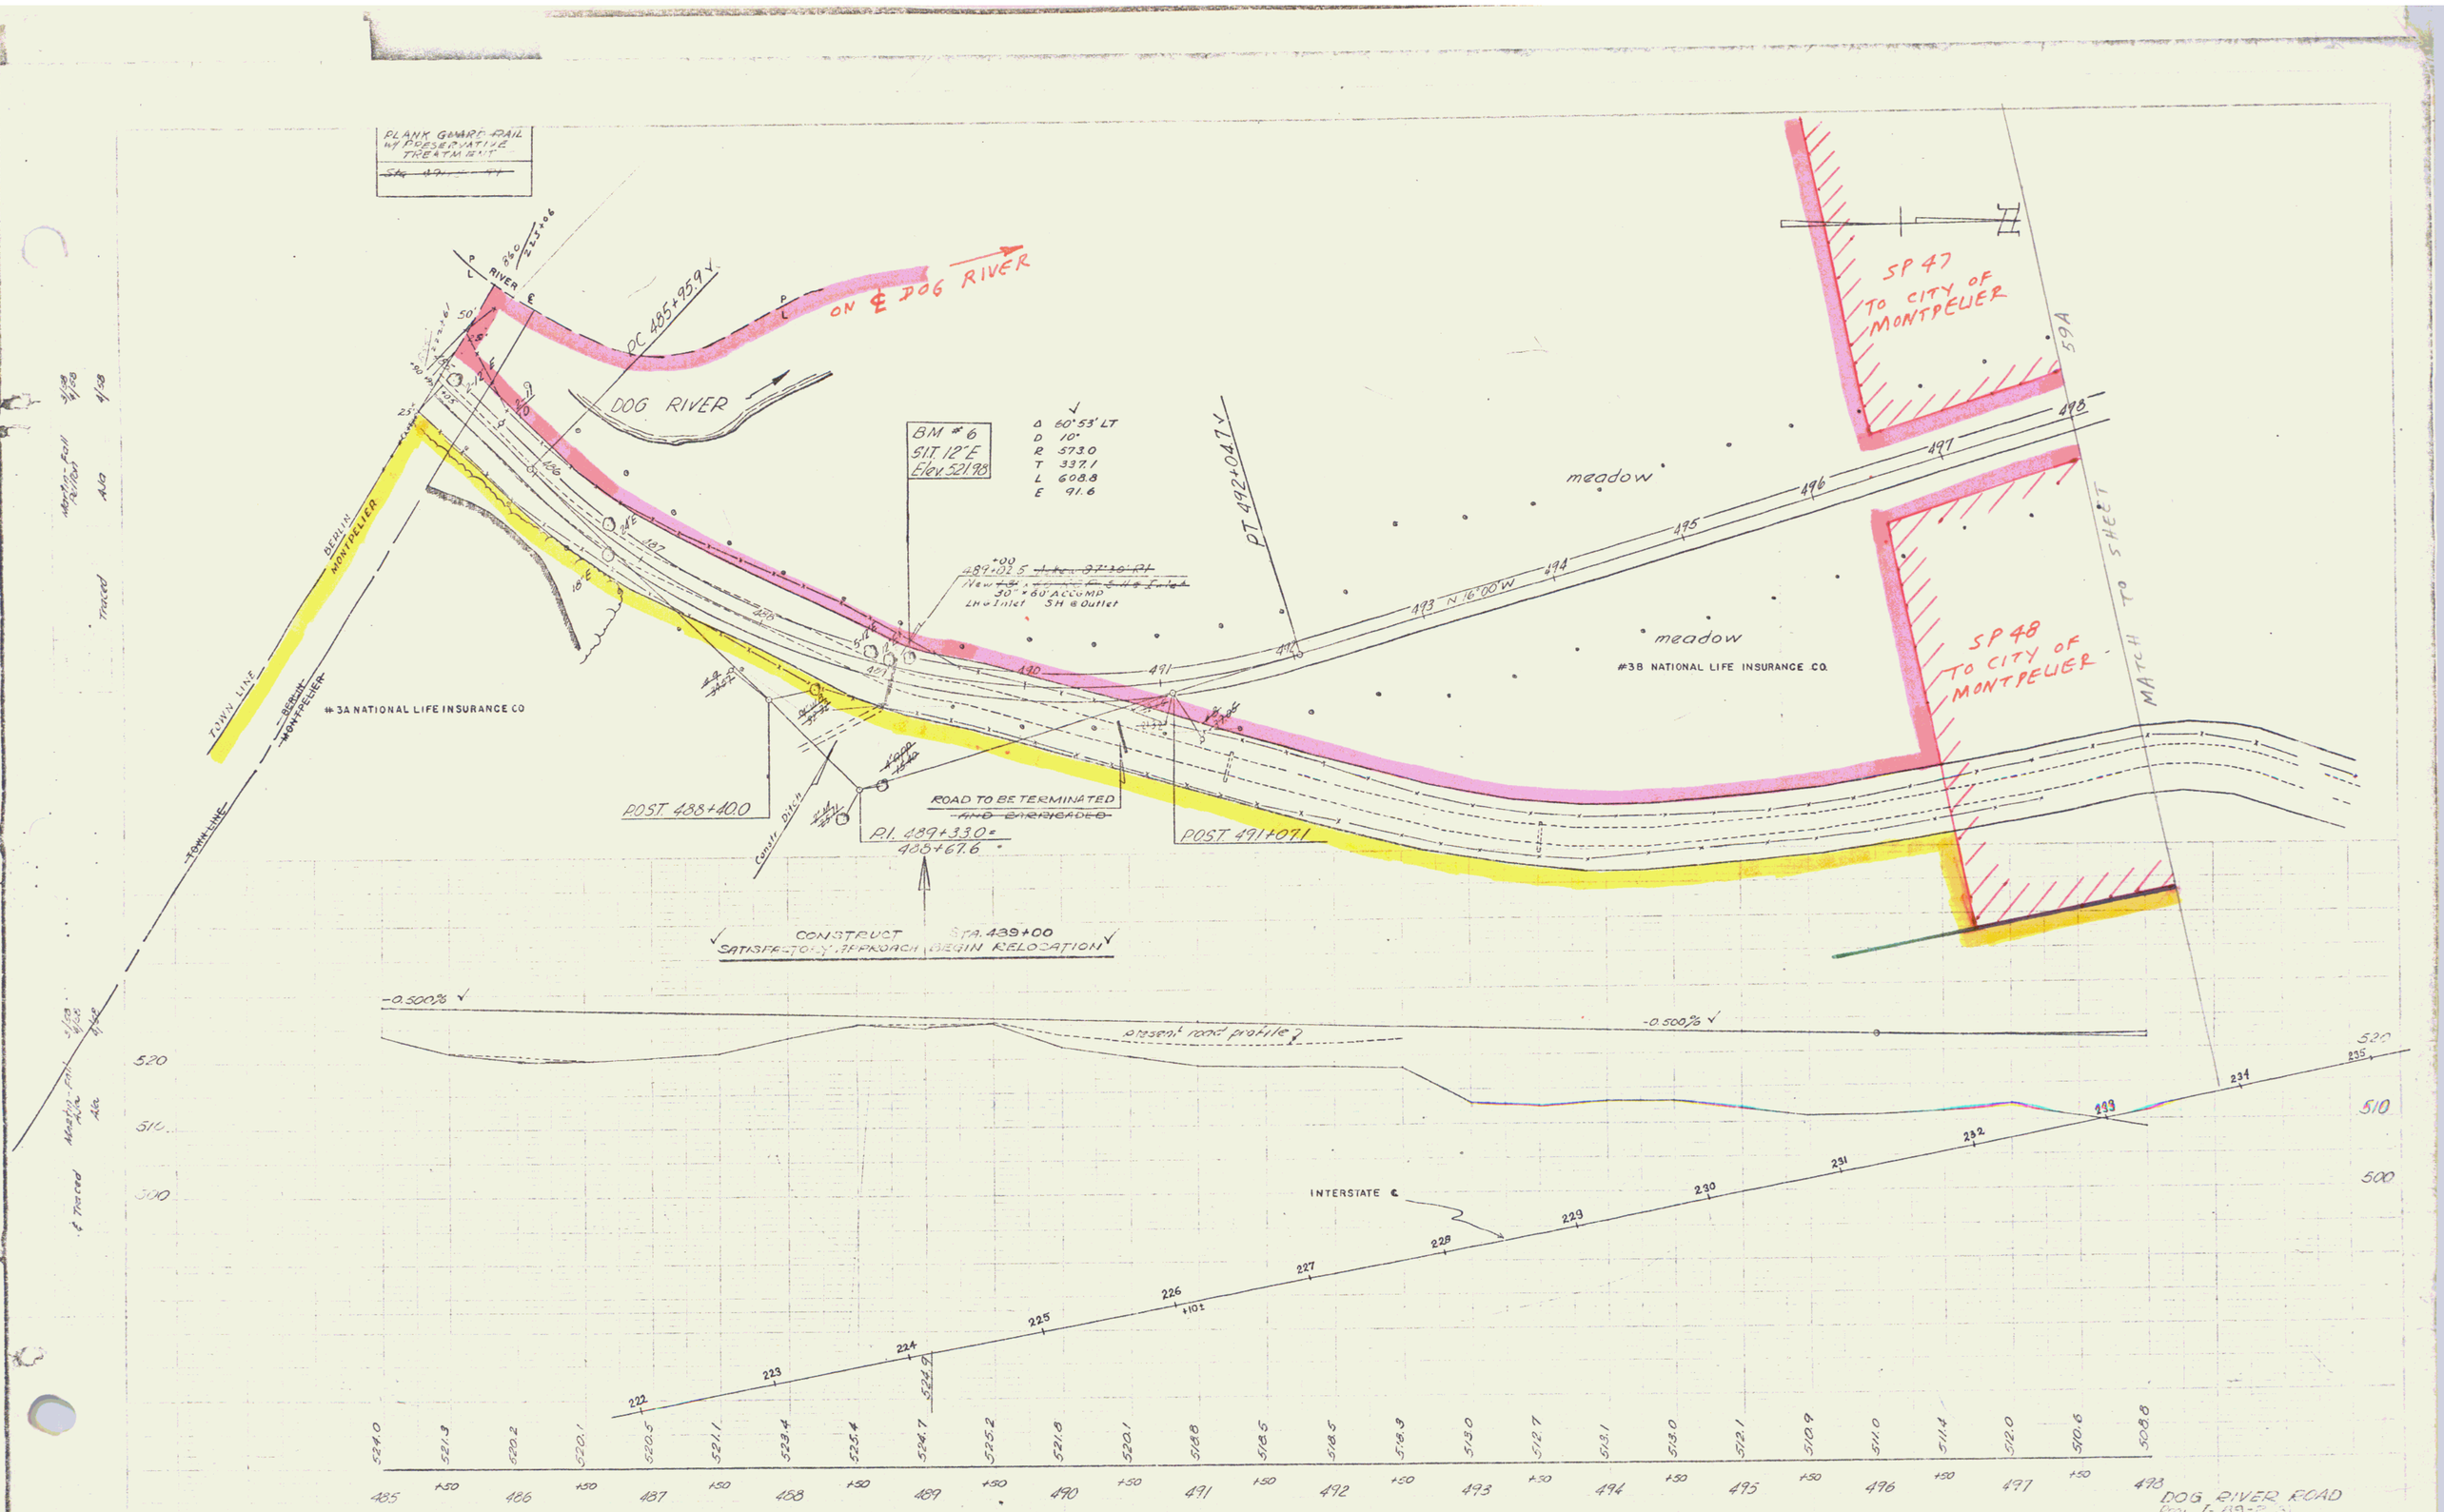

DOG RIVER ROAD
Proj F-89-E(3)
Sheet 59 of 800
Cont 1

12