~~EXCAVATION & REMOVAL OF ROAD SURFACE ON ROADWAYS ITEM 118A~~
~~STA. 505+00 TO 520+00 LT.~~

3 CABLE GUARD RAIL
STA. 518+50 TO 520+00 LT. ✓
~~STA. 505+00 TO 506+00 LT.~~

I 89-2 (3) 60 800

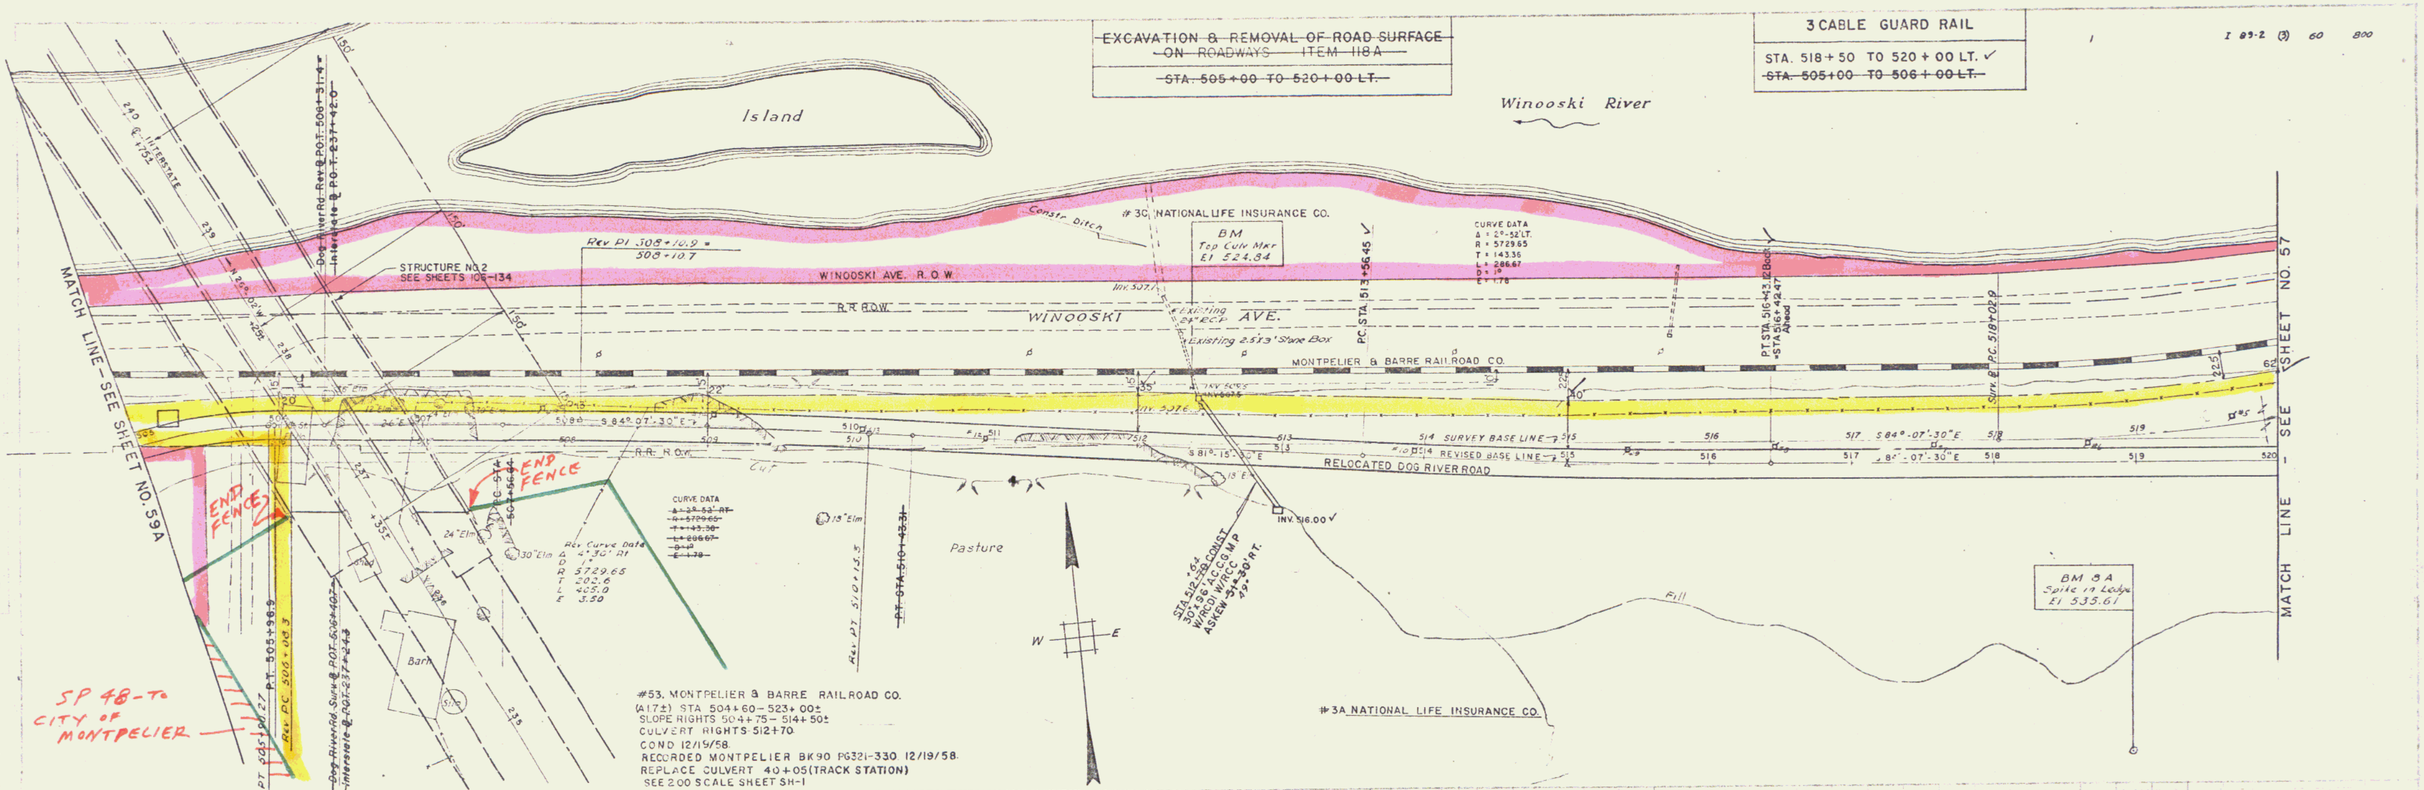

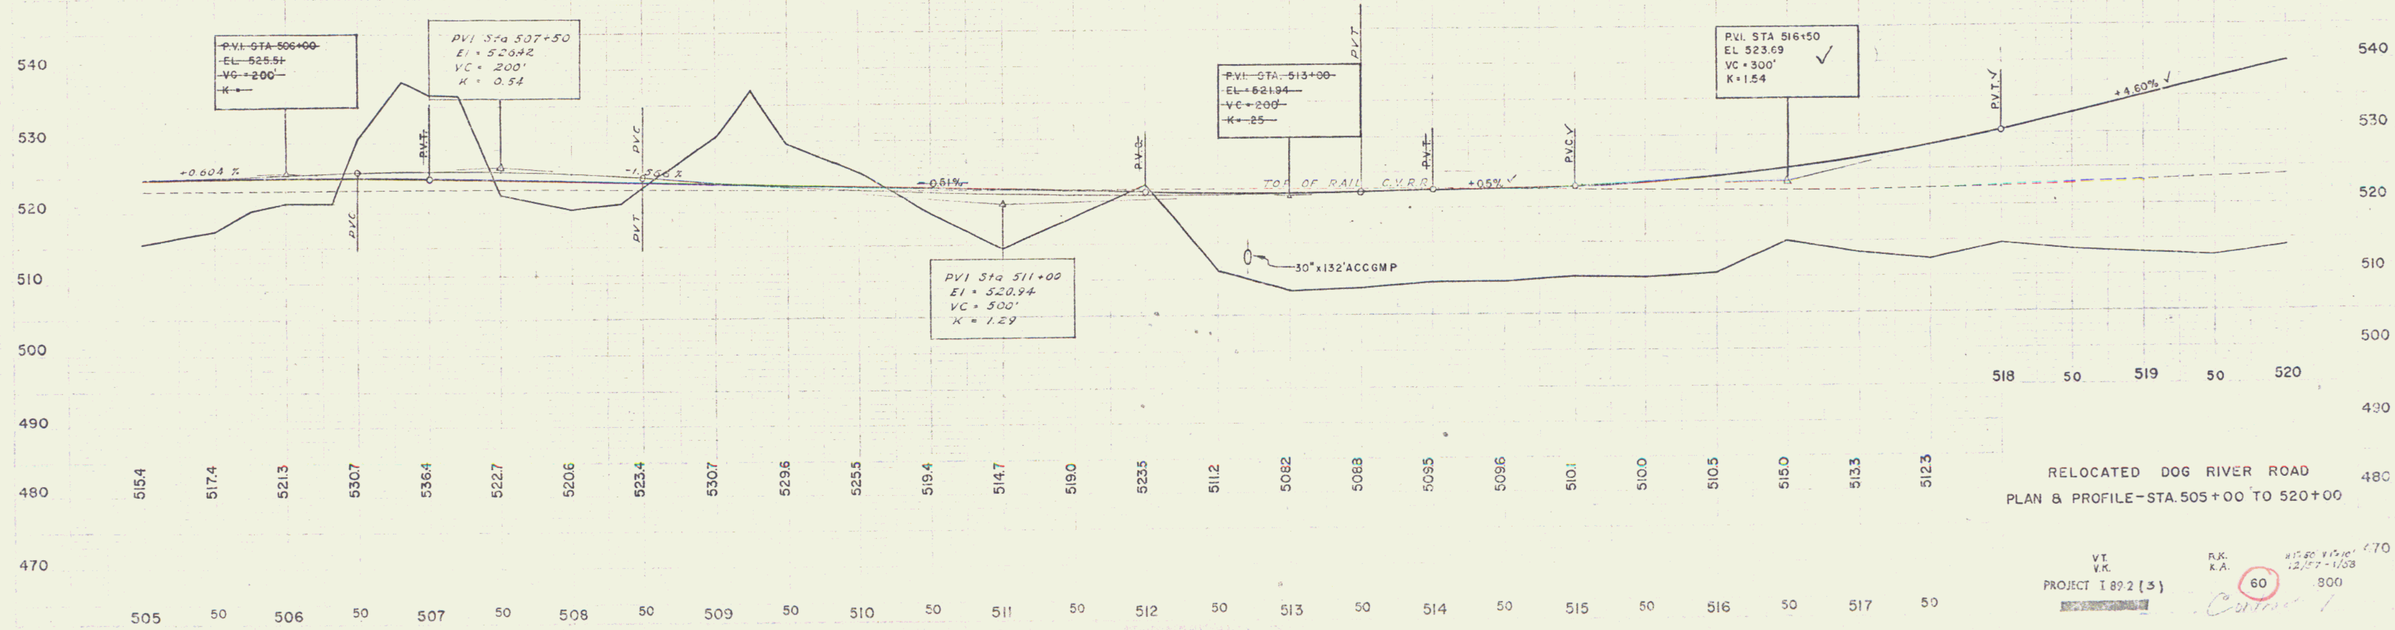

RELOCATED DOG RIVER ROAD
PLAN & PROFILE - STA. 505+00 TO 520+00

V.T.
V.K.

R.K.
K.A.

PROJECT I 89-2 (3)

60

800

Contract 1

14