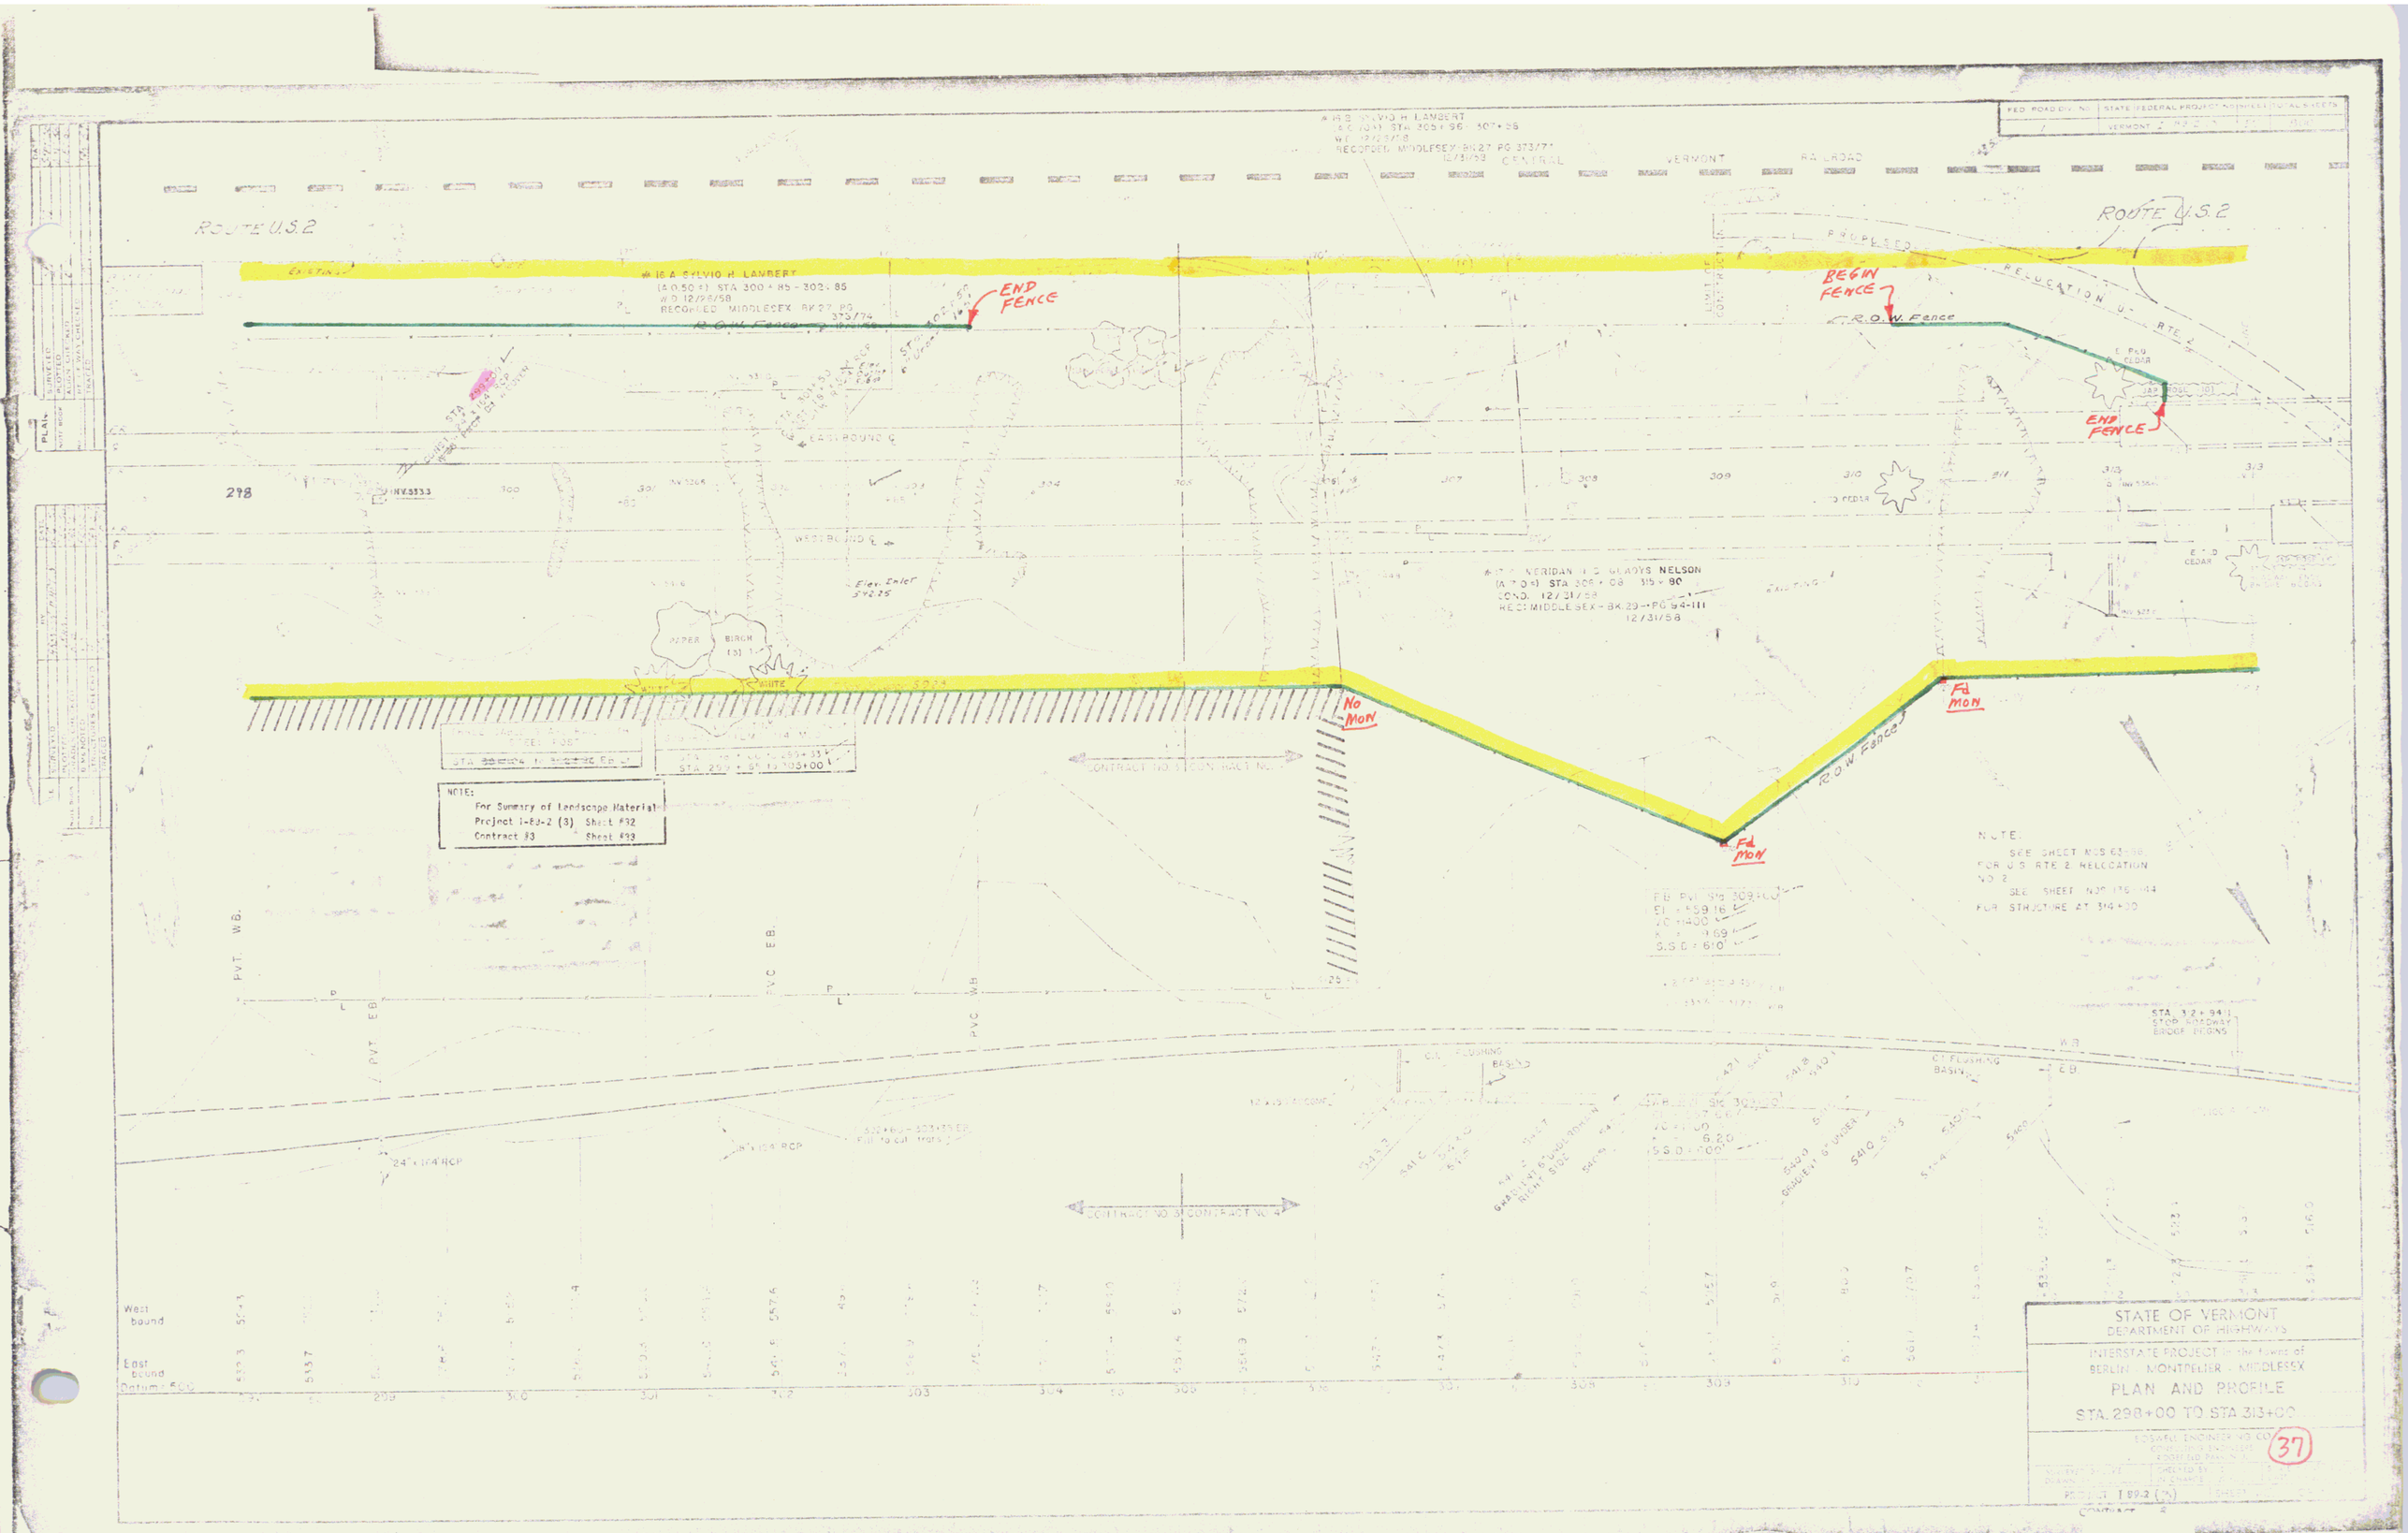
ROUTE U.S. 2
VERMONT RAILROAD
#16 A SYLVIO H. LAMBERT
(A 0.50 ±) STA 300 + 85 - 302 + 85
W.D. 12/26/58
RECORDED MIDDLESEX BK 27 PG 373/74
END FENCE
BEGIN FENCE
R.O.W. Fence
PROPOSED RELOCATION U.S. RTE 2
EAST BOUND ℄
WEST BOUND ℄
Elev. Inlet 542.25
NO MON
Fd MON
NOTE:
For Summary of Landscape Material
Project I-89-2 (3) Sheet #32
Contract #3 Sheet #33
CONTRACT NO. 3
CONTRACT NO. 4
PVT. W.B.
PVT. E.B.
PVC E.B.
PVC W.B.
24" CMP RCP
18" CMP RCP
CI FLUSHING BASIN
STA. 312+94 STOP BROADWAY BRIDGE BEGINS
West bound
East bound
Datum: 500
STATE OF VERMONT
DEPARTMENT OF HIGHWAYS
INTERSTATE PROJECT in the towns of
BERLIN - MONTPELIER - MIDDLESEX
PLAN AND PROFILE
STA. 298+00 TO STA. 313+00
37

19